46102

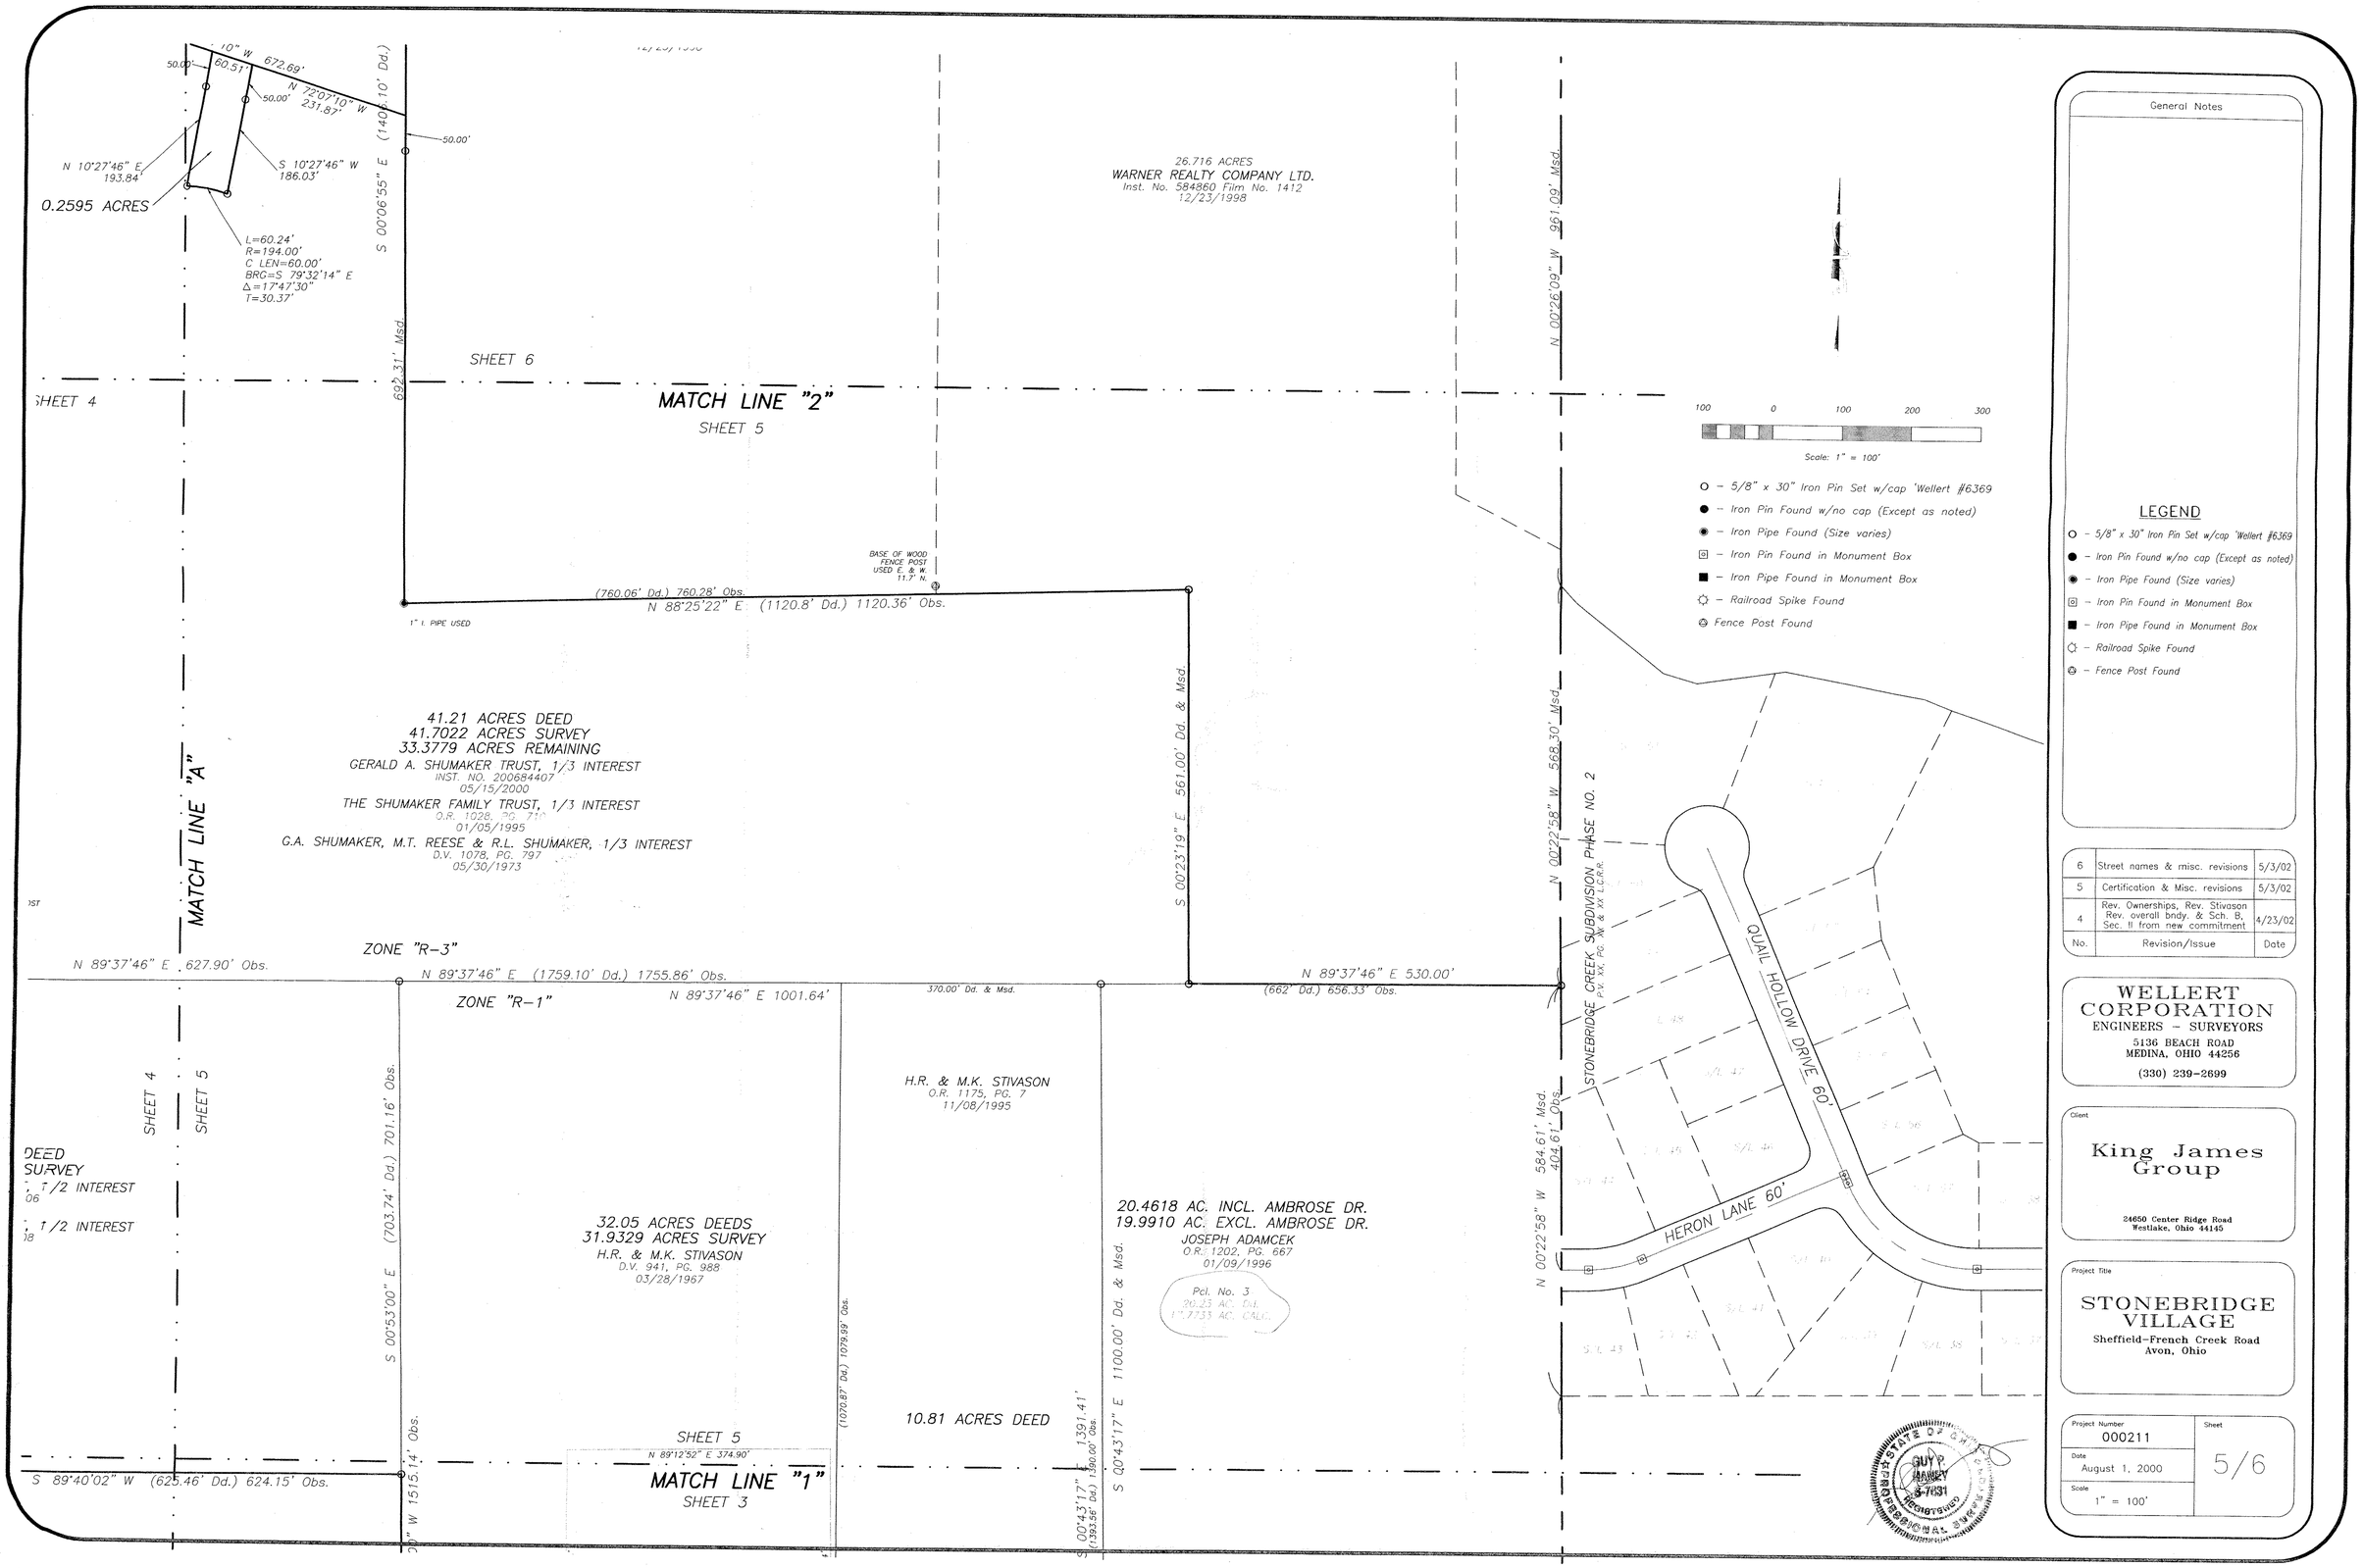


| No. | Revision/Issue | Date |
|---|---|---|
| 6 | Street names & misc. revisions | 5/3/02 |
| 5 | Certification & Misc. revisions | 5/3/02 |
| 4 | Rev. Ownerships, Rev. Stivason Rev. overall bndy. & Sch. B, Sec. II from new commitment | 4/23/02 |

WELLERT CORPORATION
ENGINEERS – SURVEYORS
5136 BEACH ROAD
MEDINA, OHIO 44256
(330) 239-2699

Client
King James Group
24650 Center Ridge Road
Westlake, Ohio 44145

Project Title
STONEBRIDGE VILLAGE
Sheffield-French Creek Road
Avon, Ohio

| Project Number | Sheet |
|---|---|
| 000211 | 5/6 |
| Date: August 1, 2000 | |
| Scale: 1" = 100' | |

K:\PROJECTS\SURVEYS\KJ_AVON\gps_7_19\Re_04_02.dwg, 05/07/02 09:18:23 AM