07-00-002-102-054
07-00-002A 055
003
043
042
006 thru-010
047
012
013

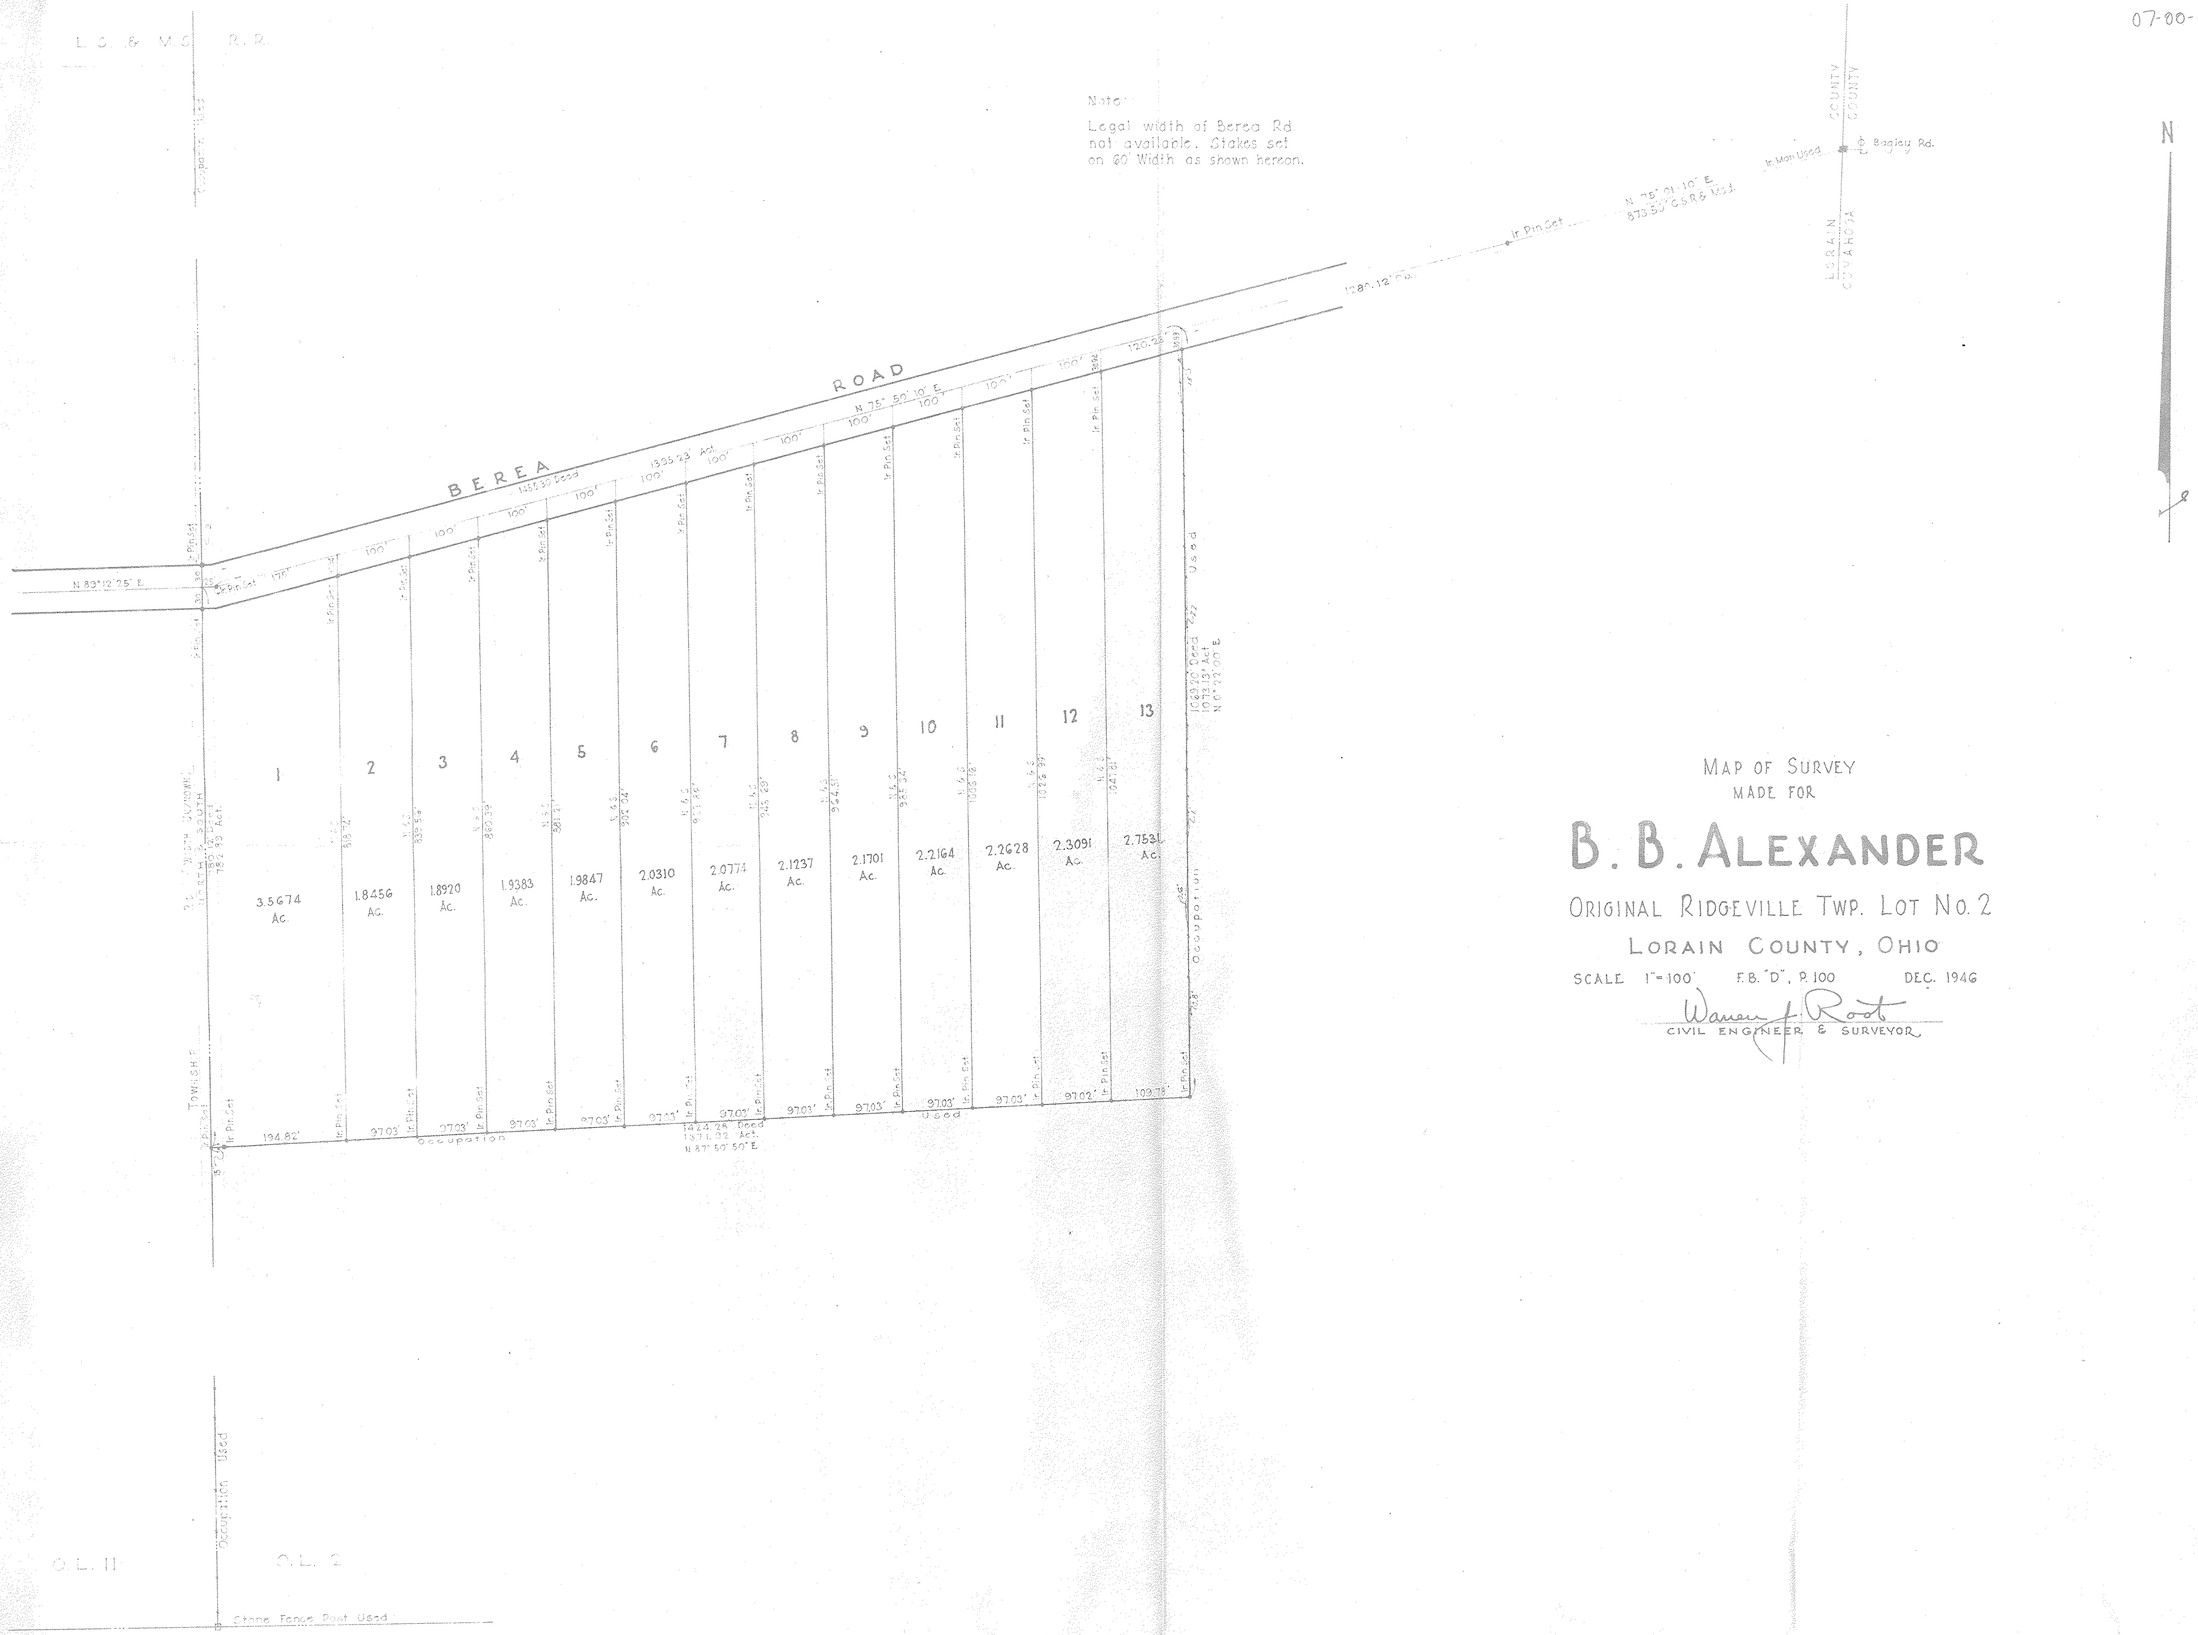

MAP OF SURVEY
MADE FOR

B. B. ALEXANDER

ORIGINAL RIDGEVILLE TWP. LOT NO. 2

LORAIN COUNTY, OHIO

SCALE 1" = 100' F.B. "D", P. 100 DEC. 1946

Warren J. Root
CIVIL ENGINEER & SURVEYOR

Alexander to Warren T. B.