07-00-010-106-010 thru
07-00-010-A
Scan # 46106

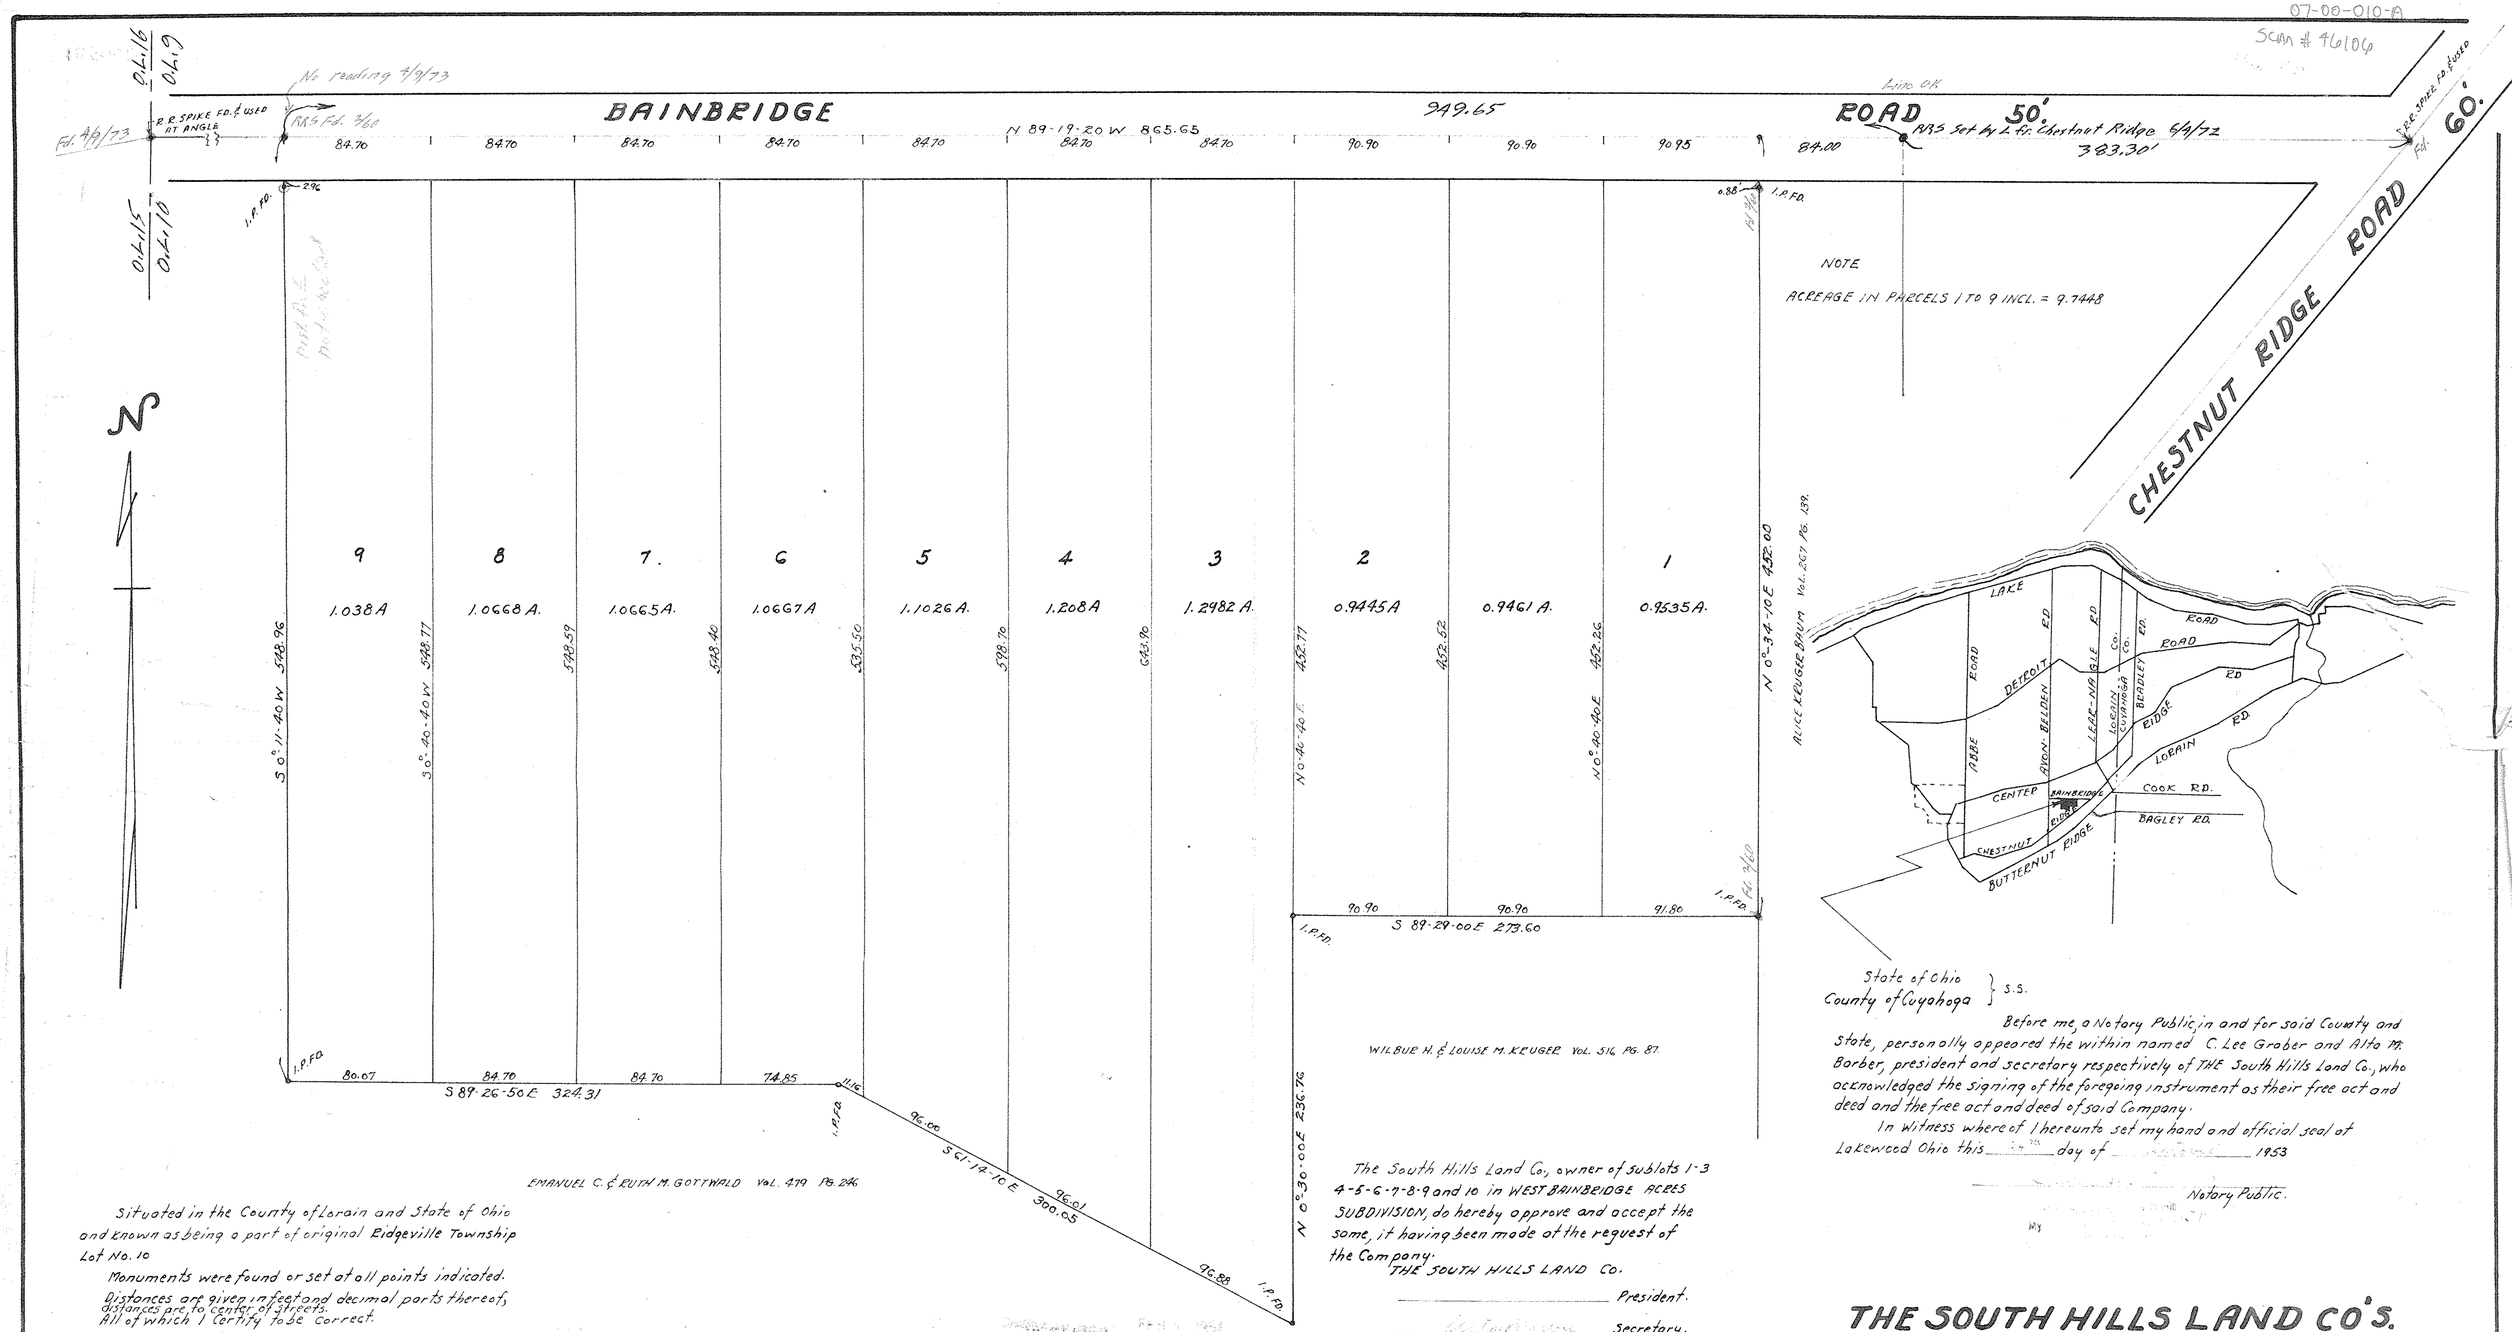

Situated in the County of Lorain and State of Ohio and known as being a part of original Ridgeville Township Lot No. 10

Monuments were found or set at all points indicated.

Distances are given in feet and decimal parts thereof, distances are to center of streets.
All of which I certify to be correct.

Irving L. Dean. Surveyor.
REG. No. 1681.

The South Hills Land Co, owner of sublots 1-3 4-5-6-7-8-9 and 10 in WEST BAINBRIDGE ACRES SUBDIVISION, do hereby approve and accept the same, it having been made at the request of the Company.

THE SOUTH HILLS LAND CO.

_____ President.

_____ Secretary.

State of Ohio
County of Cuyahoga } S.S.

Before me, a Notary Public in and for said County and State, personally appeared the within named C. Lee Graber and Alta M. Barber, president and secretary respectively of THE South Hills Land Co., who acknowledged the signing of the foregoing instrument as their free act and deed and the free act and deed of said Company.

In witness whereof I hereunto set my hand and official seal at Lakewood Ohio this _____ day of _____ 1953

_____ Notary Public.

THE SOUTH HILLS LAND CO'S.
WEST BAINBRIDGE ACRES

OFFICE - 16518 DETROIT AVE. PHONE: LA. 1-8180
JULY 1953 I. L. DEAN - SURVEYOR
SCALE 50'=1" REG. NO. 1681.