11-00-068-000-017

11-00-068-000-017
11-00-073-000-019
11-8
SCAN # 46123
46124
46125

ALTA/ACSM LAND TITLE SURVEY

PREPARED FOR

C. M. E. PROPERTIES CO., HUNTINGTON NATIONAL BANK & OLD REPUBLIC NATIONAL TITLE INSURANCE COMPANY

SITUATED IN THE TOWNSHIP OF EATON, COUNTY OF LORAIN, STATE OF OHIO
AND KNOWN AS BEING PART OF ORIGINAL EATON TOWNSHIP LOT NUMBERS 68 & 73
APRIL 2011

OLD REPUBLIC NATIONAL TITLE INSURANCE COMPANY COMMITMENT NO. CB-2057 EFFECTIVE DATE: MARCH 4, 2011 AT 8:00 A.M. EXHIBIT A - LEGAL DESCRIPTION

PARCEL NO. 1

SITUATED IN THE TOWNSHIP OF EATON, COUNTY OF LORAIN, STATE OF OHIO, KNOWN AS BEING PART OF ORIGINAL EATON TOWNSHIP LOT NUMBERS 68 AND 73 AS DESCRIBED IN A DEED TO C. M. E. PROPERTIES CO. AS RECORDED IN INSTRUMENT NUMBER 20060181471 (PARCEL 1) OF THE LORAIN COUNTY DEED RECORDS, AND FURTHER DESCRIBED AS FOLLOWS:

COMMENCING AT A 1-INCH IRON PIN WITH ALUMINUM CAP FOUND IN A MONUMENT BOX AT THE INTERSECTION OF THE CENTERLINE OF NORTH DURKEE ROAD (60 FEET WIDE) WITH THE SOUTHERLY LINE OF ORIGINAL EATON TOWNSHIP LOT NUMBER 73;

THENCE NORTH 00° 12' 20" EAST, ALONG THE CENTERLINE OF SAID NORTH DURKEE ROAD, A DISTANCE OF 711.71 FEET TO A POINT IN A NORTHERLY LINE OF A PARCEL OF LAND DESCRIBED IN A DEED TO WILLIAM E. CROMLING, III & CHRISTINE M. CROMLING AS RECORDED IN INSTRUMENT NUMBER 19960387048 OF THE LORAIN COUNTY DEED RECORDS; SAID POINT IS THE TRUE PLACE OF BEGINNING OF LAND HEREIN DESCRIBED;

COURSE 1: THENCE CONTINUING NORTH 00° 12' 20" EAST, ALONG THE CENTERLINE OF SAID NORTH DURKEE ROAD, A DISTANCE OF 119.64 FEET TO A POINT IN THE SOUTHWESTERLY CORNER OF A PARCEL OF LAND DESCRIBED IN A DEED TO C. M. E. PROPERTIES CO. (11-00-073-000-032) AS RECORDED IN INSTRUMENT NUMBER 20060181471 (PARCEL 2) OF THE LORAIN COUNTY DEED RECORDS;

COURSE 2: THENCE SOUTH 89° 09' 23" EAST, ALONG THE SOUTHERLY LINE OF SAID C. M. E. PROPERTIES CO. (11-00-073-000-032) PARCEL, PASSING THROUGH A 1-INCH IRON PIPE FOUND AT 29.58 FEET, AN OVERALL DISTANCE OF 375.89 FEET TO A 1-INCH IRON PIPE FOUND;

COURSE 3: THENCE NORTH 00° 15' 17" EAST, ALONG THE EASTERLY LINE OF SAID C. M. E. PROPERTIES CO. (11-00-073-000-032) PARCEL AND THE EASTERLY LINE OF A PARCEL OF LAND DESCRIBED IN A DEED TO TERENCE J. FINK (11-00-073-000-031) AS RECORDED IN INSTRUMENT NUMBER 20010787547 OF THE LORAIN COUNTY DEED RECORDS, PASSING THROUGH A 1-INCH PIPE FOUND AT 214.80 FEET, AN OVERALL DISTANCE OF 399.84 FEET TO A 1-INCH IRON PIPE FOUND IN A SOUTHERLY LINE OF A PARCEL OF LAND DESCRIBED IN A DEED TO TERENCE J. FINK AS RECORDED IN INSTRUMENT NUMBER 19940318822 OF THE LORAIN COUNTY DEED RECORDS;

COURSE 4: THENCE SOUTH 89° 06' 24" EAST ALONG THE SOUTHERLY LINE OF SAID FINK PARCEL (19940318822), A DISTANCE OF 2997.36 FEET TO A 5/8-INCH IRON REBAR CAPPED "BRAMHALL 8073" SET AT THE NORTHWESTERLY CORNER OF A PARCEL OF LAND DESCRIBED IN A DEED TO PINE BROOK GOLF CLUB AS RECORDED IN O.R. VOLUME 248, PAGE 146 OF THE LORAIN COUNTY DEED RECORDS;

THE FOLLOWING FOUR COURSES (COURSES 5-8) ARE ALONG THE SOUTHERLY LINE OF SAID PINE BROOK GOLF CLUB PARCEL:

COURSE 5: THENCE SOUTH 75° 20' 55" EAST, A DISTANCE OF 83.14 FEET TO A 5/8-INCH IRON REBAR CAPPED "BRAMHALL 8073"SET;

COURSE 6: THENCE SOUTH 89° 23' 59" EAST, A DISTANCE OF 713.03 FEET TO A 5/8-INCH IRON REBAR CAPPED "BRAMHALL 8073" SET;

COURSE 7: THENCE NORTH 22° 51' 05" EAST, A DISTANCE OF 258.36 FEET TO A 5/8-INCH IRON REBAR CAPPED "BRAMHALL 8073" SET;

COURSE 8: THENCE NORTH 71° 49' 53" EAST, A DISTANCE OF 470.56 FEET TO A 5/8-INCH IRON REBAR CAPPED "BRAMHALL 8073" SET IN THE SOUTHERLY LINE OF SAID FINK PARCEL;

COURSE 9: THENCE SOUTH 89° 03' 06" EAST, A DISTANCE OF 776.99 FEET TO A 5/8-INCH IRON REBAR CAPPED "BRAMHALL 8073" SET IN A SOUTHEASTERLY CORNER OF SAID FINK PARCEL;

COURSE 10: THENCE NORTH 00° 18' 31" EAST, ALONG THE EASTERLY LINE OF SAID FINK PARCEL, A DISTANCE OF 432.09 FEET TO A 5/8-INCH IRON REBAR CAPPED "BRAMHALL 8073" SET IN THE SOUTHERLY LINE OF A PARCEL OF LAND DESCRIBED IN A DEED TO PROJECT MERCY (NAME CHANGED TO HOLY LOVE MINISTRIES 10/29/1997) AS RECORDED IN INSTRUMENT NUMBER 19950376296 OF THE LORAIN COUNTY DEED RECORDS;

COURSE 11: THENCE SOUTH 89° 10' 30" EAST, A DISTANCE OF 269.64 FEET TO A 5/8-INCH IRON REBAR CAPPED "BRAMHALL 8073" SET IN THE SOUTHEASTERLY CORNER OF SAID PROJECT MERCY (HOLY LOVE MINISTRIES) PARCEL AND IN THE WESTERLY LINE OF A PARCEL OF LAND DESCRIBED IN A DEED TO C. M. E. PROPERTIES CO. (11-00-053-000-005) AS RECORDED IN INSTRUMENT NUMBER 20070187809 OF THE LORAIN COUNTY DEED RECORDS;

COURSE 12: THENCE SOUTH 00° 18' 34" WEST, ALONG THE WESTERLY LINE OF SAID C. M. E. PROPERTIES CO. (11-00-053-000-005) PARCEL AND THE WESTERLY LINE OF A PARCEL OF LAND DESCRIBED IN A DEED TO MARY J. TERNES, TRUSTEE AS RECORDED IN INSTRUMENT NUMBER 20060150269, A DISTANCE OF 1310.21 FEET TO A 5/8-INCH IRON REBAR CAPPED "BRAMHALL 8073" SET IN THE NORTHEASTERLY CORNER OF A PARCEL OF LAND DESCRIBED IN A DEED TO C. M. E. PROPERTIES CO. AS RECORDED IN INSTRUMENT NUMBER 20010731332 OF THE LORAIN COUNTY DEED RECORDS;

COURSE 13: THENCE NORTH 89° 17' 25" WEST, ALONG THE NORTHERLY LINE OF SAID C. M. E. PROPERTIES CO. AND CROMLING PARCELS, PASSING THROUGH A 5/8-INCH REBAR WITH CAP STAMPED "MCCARTNEY" FOUND AT 5223.10 FEET IN THE NORTHEASTERLY CORNER OF SAID CROMLING PARCEL, AND PASSING THROUGH A 5/8-INCH IRON REBAR CAPPED "BRAMHALL 8073" SET AT 5728.10 FEET IN THE EASTERLY RIGHT-OF-WAY OF SAID NORTH DURKEE ROAD, AN OVERALL DISTANCE OF 5758.10 FEET TO A POINT IN THE CENTERLINE OF SAID NORTH DURKEE ROAD AND THE TRUE PLACE OF BEGINNING.

CONTAINING WITHIN SAID BOUNDS 78.7703 ACRES OF LAND, OF WHICH 50.4882 ACRES LIE WITHIN ORIGINAL EATON TOWNSHIP LOT NUMBER 68 AND 28.2821 ACRES LIE WITHIN ORIGINAL EATON TOWNSHIP LOT NUMBER 73, BE THE SAME MORE OR LESS, BUT SUBJECT TO ALL LEGAL HIGHWAYS AND EASEMENTS OF RECORD AS SURVEYED BY BRAMHALL ENGINEERING & SURVEYING COMPANY, INC. IN MARCH OF 2011. ALL BEARINGS ARE INTENDED TO DESCRIBE ANGLES ONLY. THE BASIS OF BEARINGS USED WAS A PORTION OF THE CENTERLINE NORTH DURKEE ROAD (60 FEET WIDE), WHICH WAS ASSUMED TO BE NORTH 00 12' 20" EAST.

THE ABOVE INTENDS TO DESCRIBE LORAIN COUNTY AUDITOR'S PERMANENT PARCEL NUMBERS 11-00-068-000-017, 11-00-068-000-014 AND 11-00-073-000-019.

№02910
APPROVED
LORAIN CO.
MAP DEPT.
DATE 4/13/11
PAGE 11-8
BY T. SPILLMAN
#11-02910

EXISTING UNDERGROUND UTILITIES NOTE

THE SIZE & LOCATION, BOTH HORIZONTAL AND VERTICAL, OF THE UNDERGROUND UTILITIES SHOWN HEREON, HAVE BEEN OBTAINED BY A SEARCH OF AVAILABLE RECORDS. VERIFICATION BY FIELD OBSERVATION HAS BEEN CONDUCTED WHERE PRACTICAL. HOWEVER, BRAMHALL ENGINEERING AND SURVEYING COMPANY, INC. DOES NOT GUARANTEE THE COMPLETENESS NOR ACCURACY THEREOF.

REVISION

DATE:	BY:	DESCRIPTION:
04-04-2011	AMK	PRELIMINARY ISSUE TO CLIENT
04-08-2011	AMK	ISSUE TO CLIENT

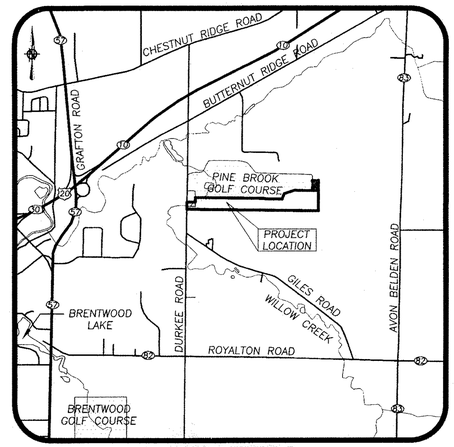

LOCATION MAP
-NOT TO SCALE-

PARCEL NO. 2

SITUATED IN THE TOWNSHIP OF EATON, COUNTY OF LORAIN, STATE OF OHIO, KNOWN AS BEING PART OF ORIGINAL EATON TOWNSHIP LOT NUMBER 73 AS DESCRIBED IN A DEED TO C. M. E. PROPERTIES CO. AS RECORDED IN INSTRUMENT NUMBER 20060181471 (PARCEL 2) OF THE LORAIN COUNTY DEED RECORDS, AND FURTHER DESCRIBED AS FOLLOWS:

COMMENCING AT A 1-INCH IRON PIN WITH ALUMINUM CAP FOUND IN A MONUMENT BOX AT THE INTERSECTION OF THE CENTERLINE OF NORTH DURKEE ROAD (60 FEET WIDE) WITH THE SOUTHERLY LINE OF ORIGINAL EATON TOWNSHIP LOT NUMBER 73;

THENCE NORTH 00° 12' 20" EAST, ALONG THE CENTERLINE OF SAID NORTH DURKEE ROAD, A DISTANCE OF 831.35 FEET TO A POINT IN A NORTHWESTERLY CORNER OF A PARCEL OF LAND DESCRIBED IN A DEED TO C. M. E. PROPERTIES CO. (11-00-073-000-019) AS RECORDED IN INSTRUMENT NUMBER 20060181471 (PARCEL 1) OF THE LORAIN COUNTY DEED RECORDS; SAID POINT IS THE TRUE PLACE OF BEGINNING OF LAND HEREIN DESCRIBED;

COURSE 1: THENCE CONTINUING NORTH 00° 12' 20" EAST, ALONG THE CENTERLINE OF SAID NORTH DURKEE ROAD, A DISTANCE OF 200.00 FEET TO A POINT IN THE SOUTHWESTERLY CORNER OF A PARCEL OF LAND DESCRIBED IN A DEED TO TERENCE J. FINK AS RECORDED IN INSTRUMENT NUMBER 20010787547 OF THE LORAIN COUNTY DEED RECORDS;

COURSE 2: THENCE SOUTH 89° 09' 23" EAST, ALONG THE SOUTHERLY LINE OF SAID FINK PARCEL, AN DISTANCE OF 376.07 FEET TO A POINT, SAID POINT BEING 14.80' SOUTHERLY FROM A 1-INCH IRON PIPE FOUND AND BEING IN A WESTERLY LINE OF SAID C. M. E. PROPERTIES CO. PARCEL (PARCEL 1);

COURSE 3: THENCE SOUTH 00° 15' 17" WEST, ALONG A WESTERLY LINE OF SAID C. M. E. PROPERTIES CO. PARCEL (PARCEL 1), A DISTANCE OF 200.00 FEET TO A 1-INCH IRON PIPE FOUND IN A NORTHERLY LINE OF SAID C. M. E. PROPERTIES CO. PARCEL (PARCEL 1);

COURSE 4: THENCE NORTH 89° 09' 23" WEST ALONG A NORTHERLY LINE OF SAID C. M. E. PROPERTIES CO. PARCEL (PARCEL 1), PASSING THROUGH A 1-INCH IRON PIPE FOUND AT 346.31 FEET, AN OVERALL DISTANCE OF 375.89 FEET TO A POINT IN THE CENTERLINE OF SAID NORTH DURKEE ROAD AND THE TRUE PLACE OF BEGINNING.

CONTAINING WITHIN SAID BOUNDS 1.7262 ACRES OF LAND, BE THE SAME MORE OR LESS, BUT SUBJECT TO ALL LEGAL HIGHWAYS AND EASEMENTS OF RECORD AS SURVEYED BY BRAMHALL ENGINEERING & SURVEYING COMPANY, INC. IN MARCH OF 2011. ALL BEARINGS ARE INTENDED TO DESCRIBE ANGLES ONLY. THE BASIS OF BEARINGS USED WAS A PORTION OF THE CENTERLINE NORTH DURKEE ROAD (60 FEET WIDE), WHICH WAS ASSUMED TO BE NORTH 00 12' 20" EAST.

THE ABOVE INTENDS TO DESCRIBE LORAIN COUNTY AUDITOR'S PERMANENT PARCEL NUMBER 11-00-073-000-032.

SURVEYOR'S CERTIFICATION

TO C. M. E. PROPERTIES, CO., HUNTINGTON NATIONAL BANK, AND OLD REPUBLIC NATIONAL TITLE INSURANCE COMPANY:

THIS IS TO CERTIFY THAT THIS MAP OR PLAT AND THE SURVEY ON WHICH IT IS BASED WERE MADE IN ACCORDANCE WITH THE 2011 MINIMUM STANDARD DETAIL REQUIREMENTS FOR ALTA/ACSM LAND TITLE SURVEYS, JOINTLY ESTABLISHED AND ADOPTED BY ALTA AND NSPS, AND INCLUDES ITEMS 1, 2, 3, 4, 6a, 8, 11a, 13, 14, 16, 17, 18, AND 19 OF TABLE A THEREOF. THE FIELD WORK WAS COMPLETED ON APRIL 7, 2011.

4/8/2011
DATE

MICHAEL C. BRAMHALL, P.S., P.E.
REGISTERED OHIO SURVEYOR No. 8073

STATE OF OHIO
MICHAEL BRAMHALL
S-8073
REGISTERED
PROFESSIONAL SURVEYOR

SCHEDULE "B" SECTION II COMMENTS

SURVEY RELATED TITLE EXCEPTIONS
OLD REPUBLIC NATIONAL TITLE INSURANCE COMPANY
COMMITMENT NO.: CB-2057
EFFECTIVE DATE: MARCH 4, 2011 AT 8:00 A.M.
ITEMS 1-11 AND 19-22 OF SAID TITLE COMMITMENT DO NOT RELATE TO SPECIFIC EASEMENTS ON THE SUBJECT PARCEL.

12. RIGHT OF WAY AS RECORDED MARCH 19, 1891, IN DEED VOLUME 67, PAGE 125, LORAIN COUNTY RECORDS. **(BLANKET EASEMENT AS INDICATED ON MAP; UNABLE TO DETERMINE SPECIFIC USE)**
13. RIGHT OF WAY AS RECORDED MARCH 26, 1891, IN DEED VOLUME 65, PAGE 285, LORAIN COUNTY RECORDS. **(UNABLE TO READ IN ITS' ENTIRETY; UNABLE TO INDICATE ON MAP)**
14. RIGHT OF WAY AS RECORDED MAY 23, 1891, IN DEED VOLUME 67, PAGE 256, LORAIN COUNTY RECORDS. **(UNABLE TO READ IN ITS' ENTIRETY; UNABLE TO INDICATE ON MAP)**
15. OIL AND GAS LEASE AS RECORDED DECEMBER 7, 1907, IN LEASE VOLUME 7, PAGE 20 LORAIN COUNTY RECORDS. **(APPEARS TO ENCOMPASS SUBJECT PARCELS AS INDICATED ON MAP)**
16. OIL AND GAS LEASE AS RECORDED APRIL 23, 1910, IN LEASE VOLUME 10, PAGE 27, LORAIN COUNTY RECORDS. **(BLANKET EASEMENT, APPEARS TO AFFECT A PORTION OF THE PROPERTY IN ORIGINAL LOT 68, UNABLE TO DETERMINE EXACT AREAS AFFECTED)**
17. OIL AND GAS LEASE AS RECORDED MAY 2, 1968, IN LEASE VOLUME 85, PAGE 585, LORAIN COUNTY RECORDS. **(BLANKET EASEMENT AS INDICATED ON MAP)**
18. RIGHT OF WAY EASEMENT AS RECORDED JULY 12, 1989 IN O.R. VOLUME 195, PAGE 317, LORAIN COUNTY RECORDS. **(EASEMENT TO THE RURAL LORAIN COUNTY WATER AUTHORITY FOR WATER LINES. EASEMENT TO SHALL BE 20 FEET WIDE FOR CONSTRUCTION PURPOSES AND 10 FEET WIDE FOR MAINTENANCE PURPOSES; LOCATION OF EASEMENT IS NOT DESCRIBED IN DOCUMENT, BUT IN A CONVERSATION WITH RLWCA ON APRIL 1, 2011 IT WAS DESCRIBED AS BEING ADJACENT TO THE RIGHT-OF-WAY OF DURKEE ROAD; OTHER CONDITIONS THAT EXIST IN SAID DOCUMENT ARE AS FOLLOWS:**
    1. **PROPERTY RESTORATION TO BE TO THE OWNERS SATISFACTION.**
    2. **EXCESS DIRT TO BE USED TO RESHAPE THE DITCH LINE ON THE NORTH SIDE OF THE CREEK.**
    3. **IF AT ANY TIME IN THE FUTURE, THE WATER LINES LOCATION WOULD INTERFERE WITH WITH ANY IMPROVEMENTS IN THE PROPERTY, THE RURAL LORAIN COUNTY WATER AUTHORITY WOULD MOVE IT AT THEIR EXPENSE.)**

ZONING CLASSIFICATIONS

THE PROPERTY SHOWN HEREON LIES WITHIN ZONE "R-1" RESIDENTIAL DISTRICT, UNDER THIS CLASSIFICATION THE FOLLOWING WOULD APPLY TO NEW CONSTRUCTION:

"R-1" RESIDENTIAL DISTRICT (ARTICLE 6)

MINIMUM BUILDING LOT AREA FOR EACH SINGLE-FAMILY DETACHED DWELLING OR OTHER PRINCIPAL STRUCTURE PERMITTED: ONE (1) ACRE* (SCHEDULE 603)

MAXIMUM PERCENTAGE OF LOT COVERAGE: ALL BUILDINGS INCLUDING ACCESSORY BUILDINGS SHALL NOT COVER MORE THAN THIRTY (30) PERCENT OF THE AREA OF THE LOT (SCHEDULE 603)

MINIMUM LOT FRONTAGE AND LOT WIDTH: ONE HUNDRED TWENTY-FIVE (125) FEET (SCHEDULE 603)

MINIMUM FRONT YARD DEPTH: SEVENTY-FIVE (75) FEET (SCHEDULE 603)

MINIMUM REAR YARD: THIRTY (30) FEET (SCHEDULE 603)

MINIMUM SIDE YARDS: NOT LESS THAN TEN (10) FEET. THE SUM OF TWO SIDE YARDS SHALL NOT BE LESS THAN TWENTY (20) FEET (SCHEDULE 603)

TWO AND ONE HALF (2.5) STORIES OR THIRTY-FIVE (35) FEET IN HEIGHT EXCEPT AS OTHERWISE PROVIDED IN THIS RESOLUTION (SCHEDULE 604)

NOTE: ITEMS WITHIN ( ) REFERENCE THE SECTION FROM THE CODIFIED ORDINANCES OF TOWNSHIP CITY OF EATON.

* WHERE WATER SERVICE AND A WASTE WATER SYSTEM CONNECTED TO A SANITARY SEWER OR TO AN OHIO ENVIRONMENTAL PROTECTION AGENCY (EPA) APPROVED SEPTIC SYSTEM IS AVAILABLE.

FLOOD ZONE DATA

THE SUBJECT PARCEL LIES WITHIN THE FOLLOWING FLOOD HAZARD AREAS ACCORDING TO THE NATIONAL FLOOD INSURANCE PROGRAM RATE MAP PANEL No. 39093C0233D ISSUED BY THE FEDERAL EMERGENCY MANAGEMENT AGENCY, AND HAVING AN EFFECTIVE DATE OF AUGUST 19, 2008:

FLOODWAY AREA IN ZONE "AE" – BASE FLOOD ELEVATIONS DETERMINED; THE FLOODWAY IS THE CHANNEL OF A STREAM PLUS ANY ADJACENT FLOODPLAIN AREAS THAT MUST BE KEPT FREE OF ENCROACHMENT SO THAT THE 1% ANNUAL CHANCE FLOOD CAN BE CARRIED WITHOUT SUBSTANTIAL INCREASES IN FLOOD HEIGHTS.

ZONE "AE" – SPECIAL FLOOD HAZARD AREAS SUBJECT TO INUNDATION BY THE 1% ANNUAL CHANCE FLOOD; BASE FLOOD ELEVATIONS DETERMINED.

ZONE "X" – AREAS OF 0.2% ANNUAL CHANCE FLOOD; AREAS OF 1% ANNUAL CHANCE FLOOD WITH AVERAGE DEPTHS OF LESS THAN 1 FOOT OR WITH DRAINAGE AREAS LESS THAN 1 SQUARE MILE; AND AREAS PROTECTED BY LEVEES FROM 1% ANNUAL CHANCE FLOOD.

PROPERTY NOT IN ONE OF THE ABOVE DESIGNATED FLOOD AREAS ARE DETERMINED TO BE OUTSIDE OF THE 0.2% ANNUAL CHANCE FLOODPLAIN.

REFERENCES

- LORAIN COUNTY TAX MAP RECORDS.
- LORAIN COUNTY DEED RECORDS FOR SUBJECT, ADJACENT, & ADJOINING PARCELS
- CODIFIED ORDINANCES OF EATON TOWNSHIP
- TOWNSHIP OF EATON ZONING DISTRICT MAP REVISED 5/4/2009
- FEMA FLOOD INSURANCE RATE MAPS (FIRM) COMMUNITY PANEL No. 39093C0233D, EFFECTIVE AUGUST 19, 2008.
- OLD REPUBLIC NATIONAL TITLE INSURANCE COMPANY COMMITMENT NO. CB-2057.
- SURVEY BY DONALD G. BOHNING & ASSOCIATES, INC., JANUARY 2007.

DRAWN BY: AMK
CHECKED BY: BDA

BRAMHALL
ENGINEERING AND SURVEYING CO., INC.
801 MOORE ROAD AVON, OHIO 44011
(440) 934 - 7878 (440) 934 - 7879 FAX

SHEET 1 OF 3
JOB NO. 11-3092