Plat of Lot Split And Consolidation
Part of Original Grafton Township Lot 34
Township 4 North, Range 16 West
Of the Connecticut Western Reserve Survey
Now in the Township of Grafton, Lorain County, Ohio
March, 2011 Scale 1"= 100'

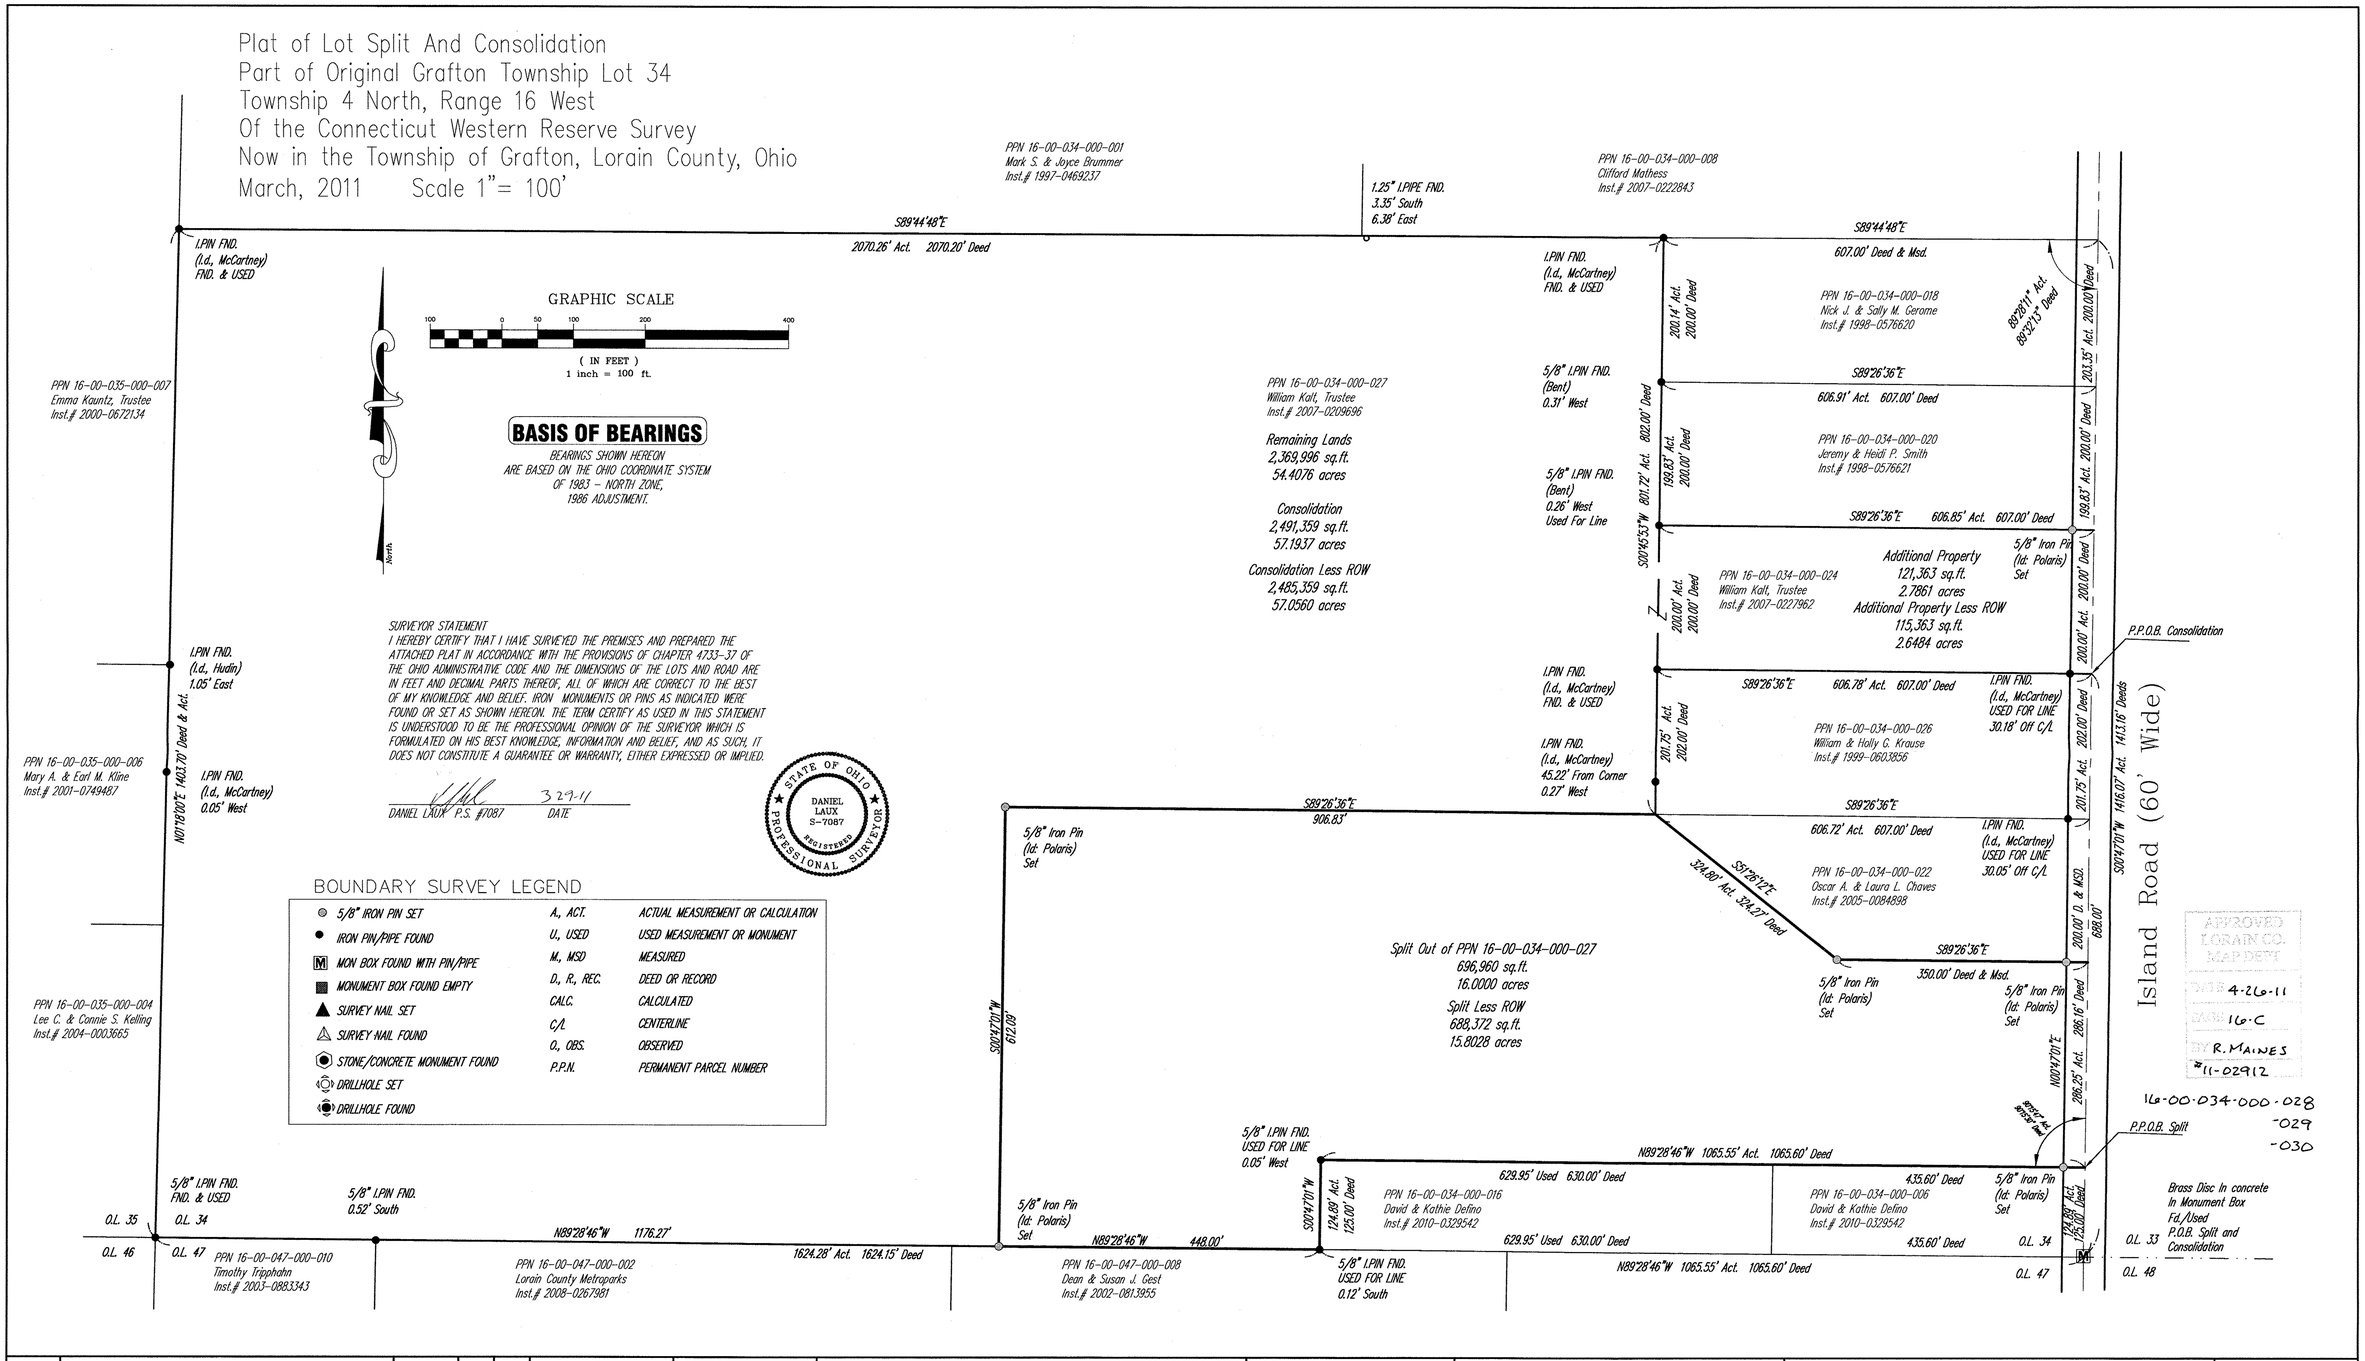

REV. No.		DATE	BY	CH'K'D

DATE: 03/01/2011
SCALE: HOR. 1"= 100'
VERT. 1"=0'
FOLDER: DWG\SURVEYS\
FILENAME: BOUNDARY
TAB: LOT SPLIT
DRAWN: DL

LOT SPLIT AND CONSOLIDATION

GRAFTON TOWNSHIP – LORAIN COUNTY – OHIO

polaris Engineering & Surveying

POLARIS ENGINEERING & SURVEYING, INC.
34600 CHARDON ROAD – SUITE D
WILLOUGHBY HILLS, OHIO 44094
(440) 944-4433 (440) 944-3722 (Fax)
www.polaris-es.com

MAP OF LANDS

CONTRACT No. 11010

SHEET 01 OF 01

16-00-034-000-028
029
030
Scan # 461133