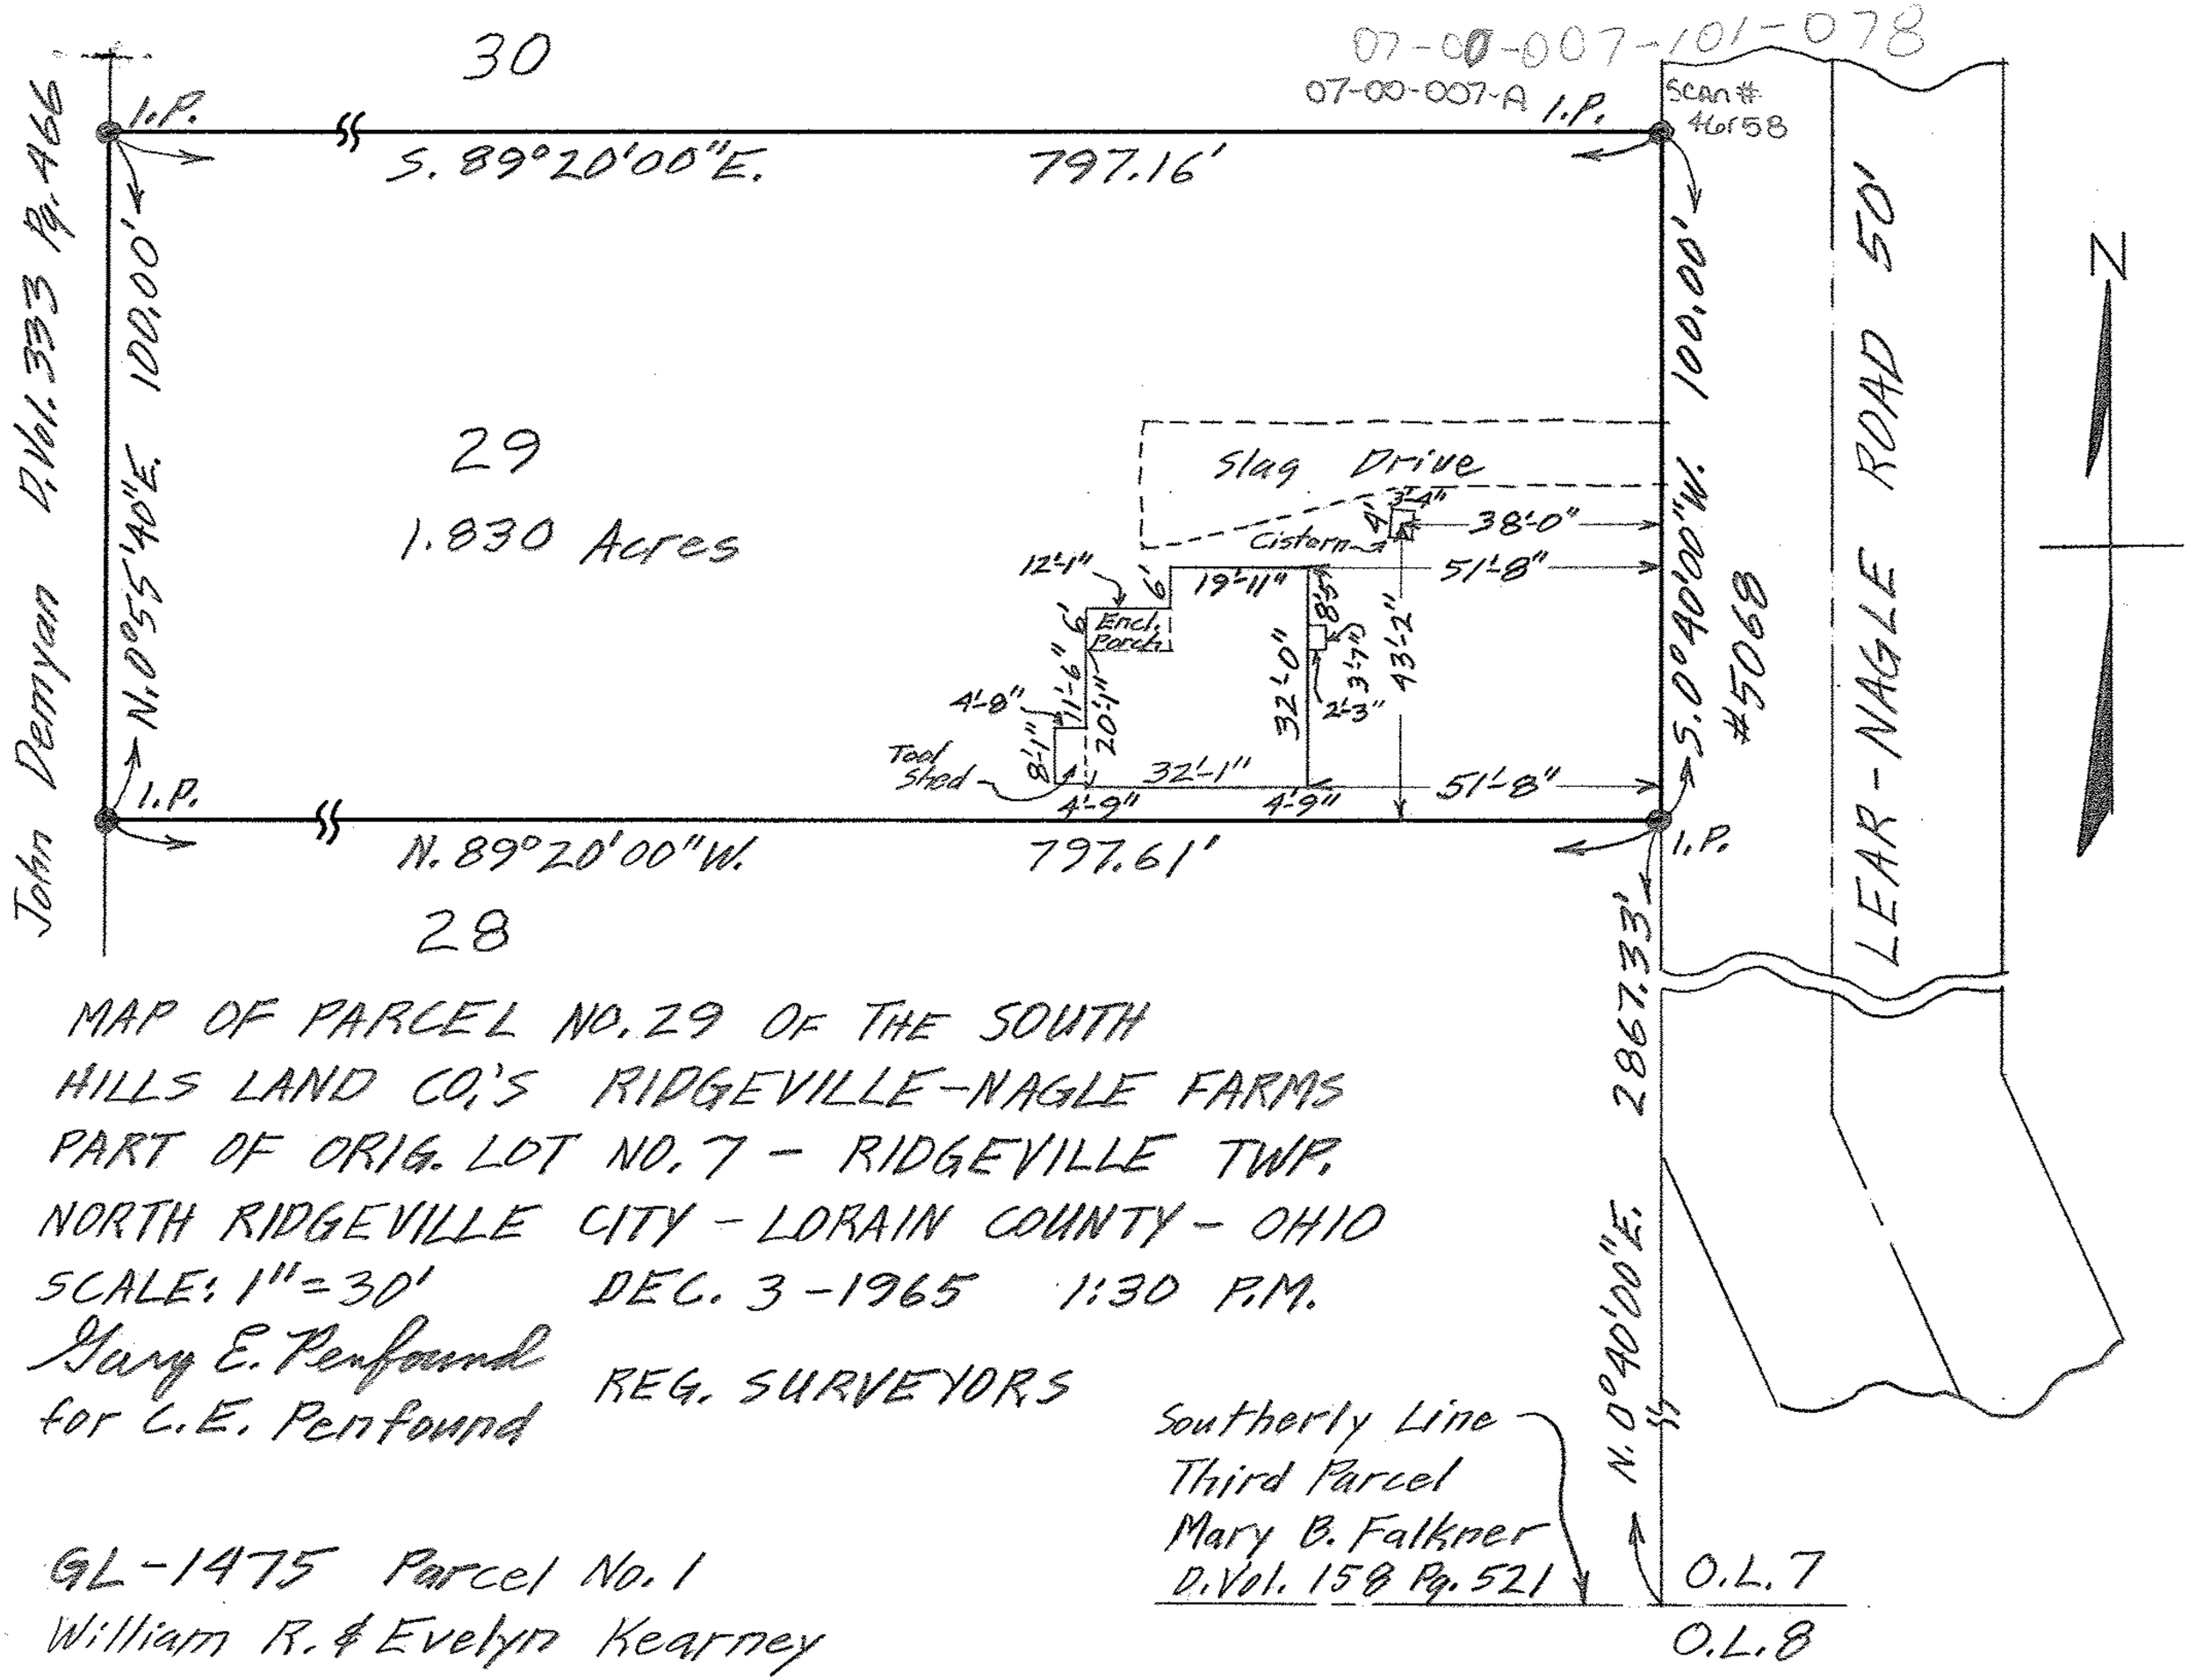

MAP OF PARCEL NO. 29 OF THE SOUTH HILLS LAND CO.'S RIDGEVILLE-NAGLE FARMS
PART OF ORIG. LOT NO. 7 - RIDGEVILLE TWP.
NORTH RIDGEVILLE CITY - LORAIN COUNTY - OHIO
SCALE: 1" = 30' DEC. 3 - 1965 1:30 P.M.

Gary E. Penfound
for C.E. Penfound REG. SURVEYORS

GL-1475 Parcel No. 1
William R. & Evelyn Kearney