07-00-008-115-016
07-00-008-D
SCAN #46168

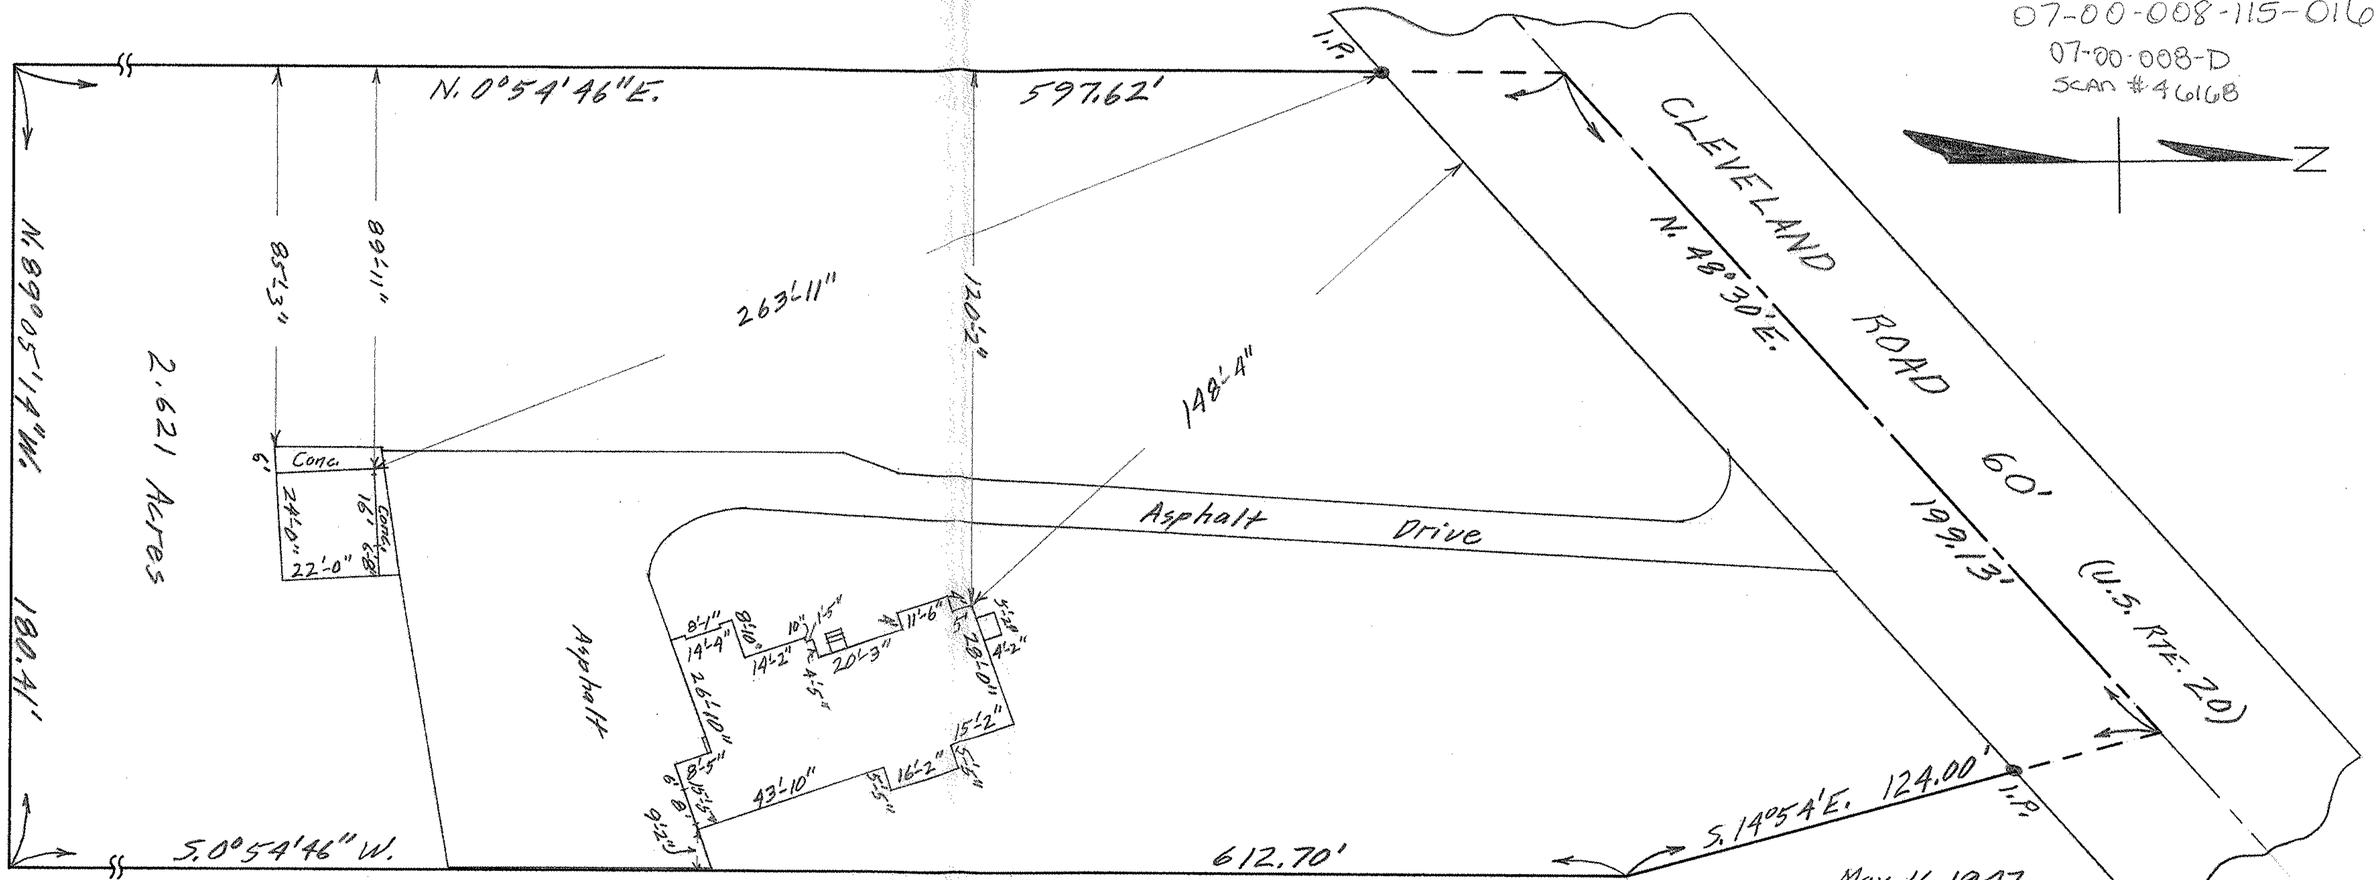


May 16, 1947

MAP OF PART OF ORIGINAL LOT NO. 8 RIDGEVILLE TWP.
NORTH RIDGEVILLE CITY - LORAIN COUNTY - OHIO
SCALE: 1" = 40' OCT. 28-1965 4:30 P.M.
Gary E. Penfound for C.E. Penfound REG. SURVEYORS

Fred & Louise Haffner D.Vol. 414 Pg. 47

E-14154 BURICH, Donald S. & Mary Ellen