07-00-009-11B-053, 052, 053, 059

PLAT OF SURVEY FOR 07-00-009-C

Scan# 46173

OSCAR W. & RUTH E. PALMER

ORIGINAL LOT 9 RIDGEVILLE TWP.
NORTH RIDGEVILLE CITY
LORAIN COUNTY OHIO
SCALE: 1" = 100' APRIL 1973
Gary E. Penfound – Reg. Surveyor No. 4457
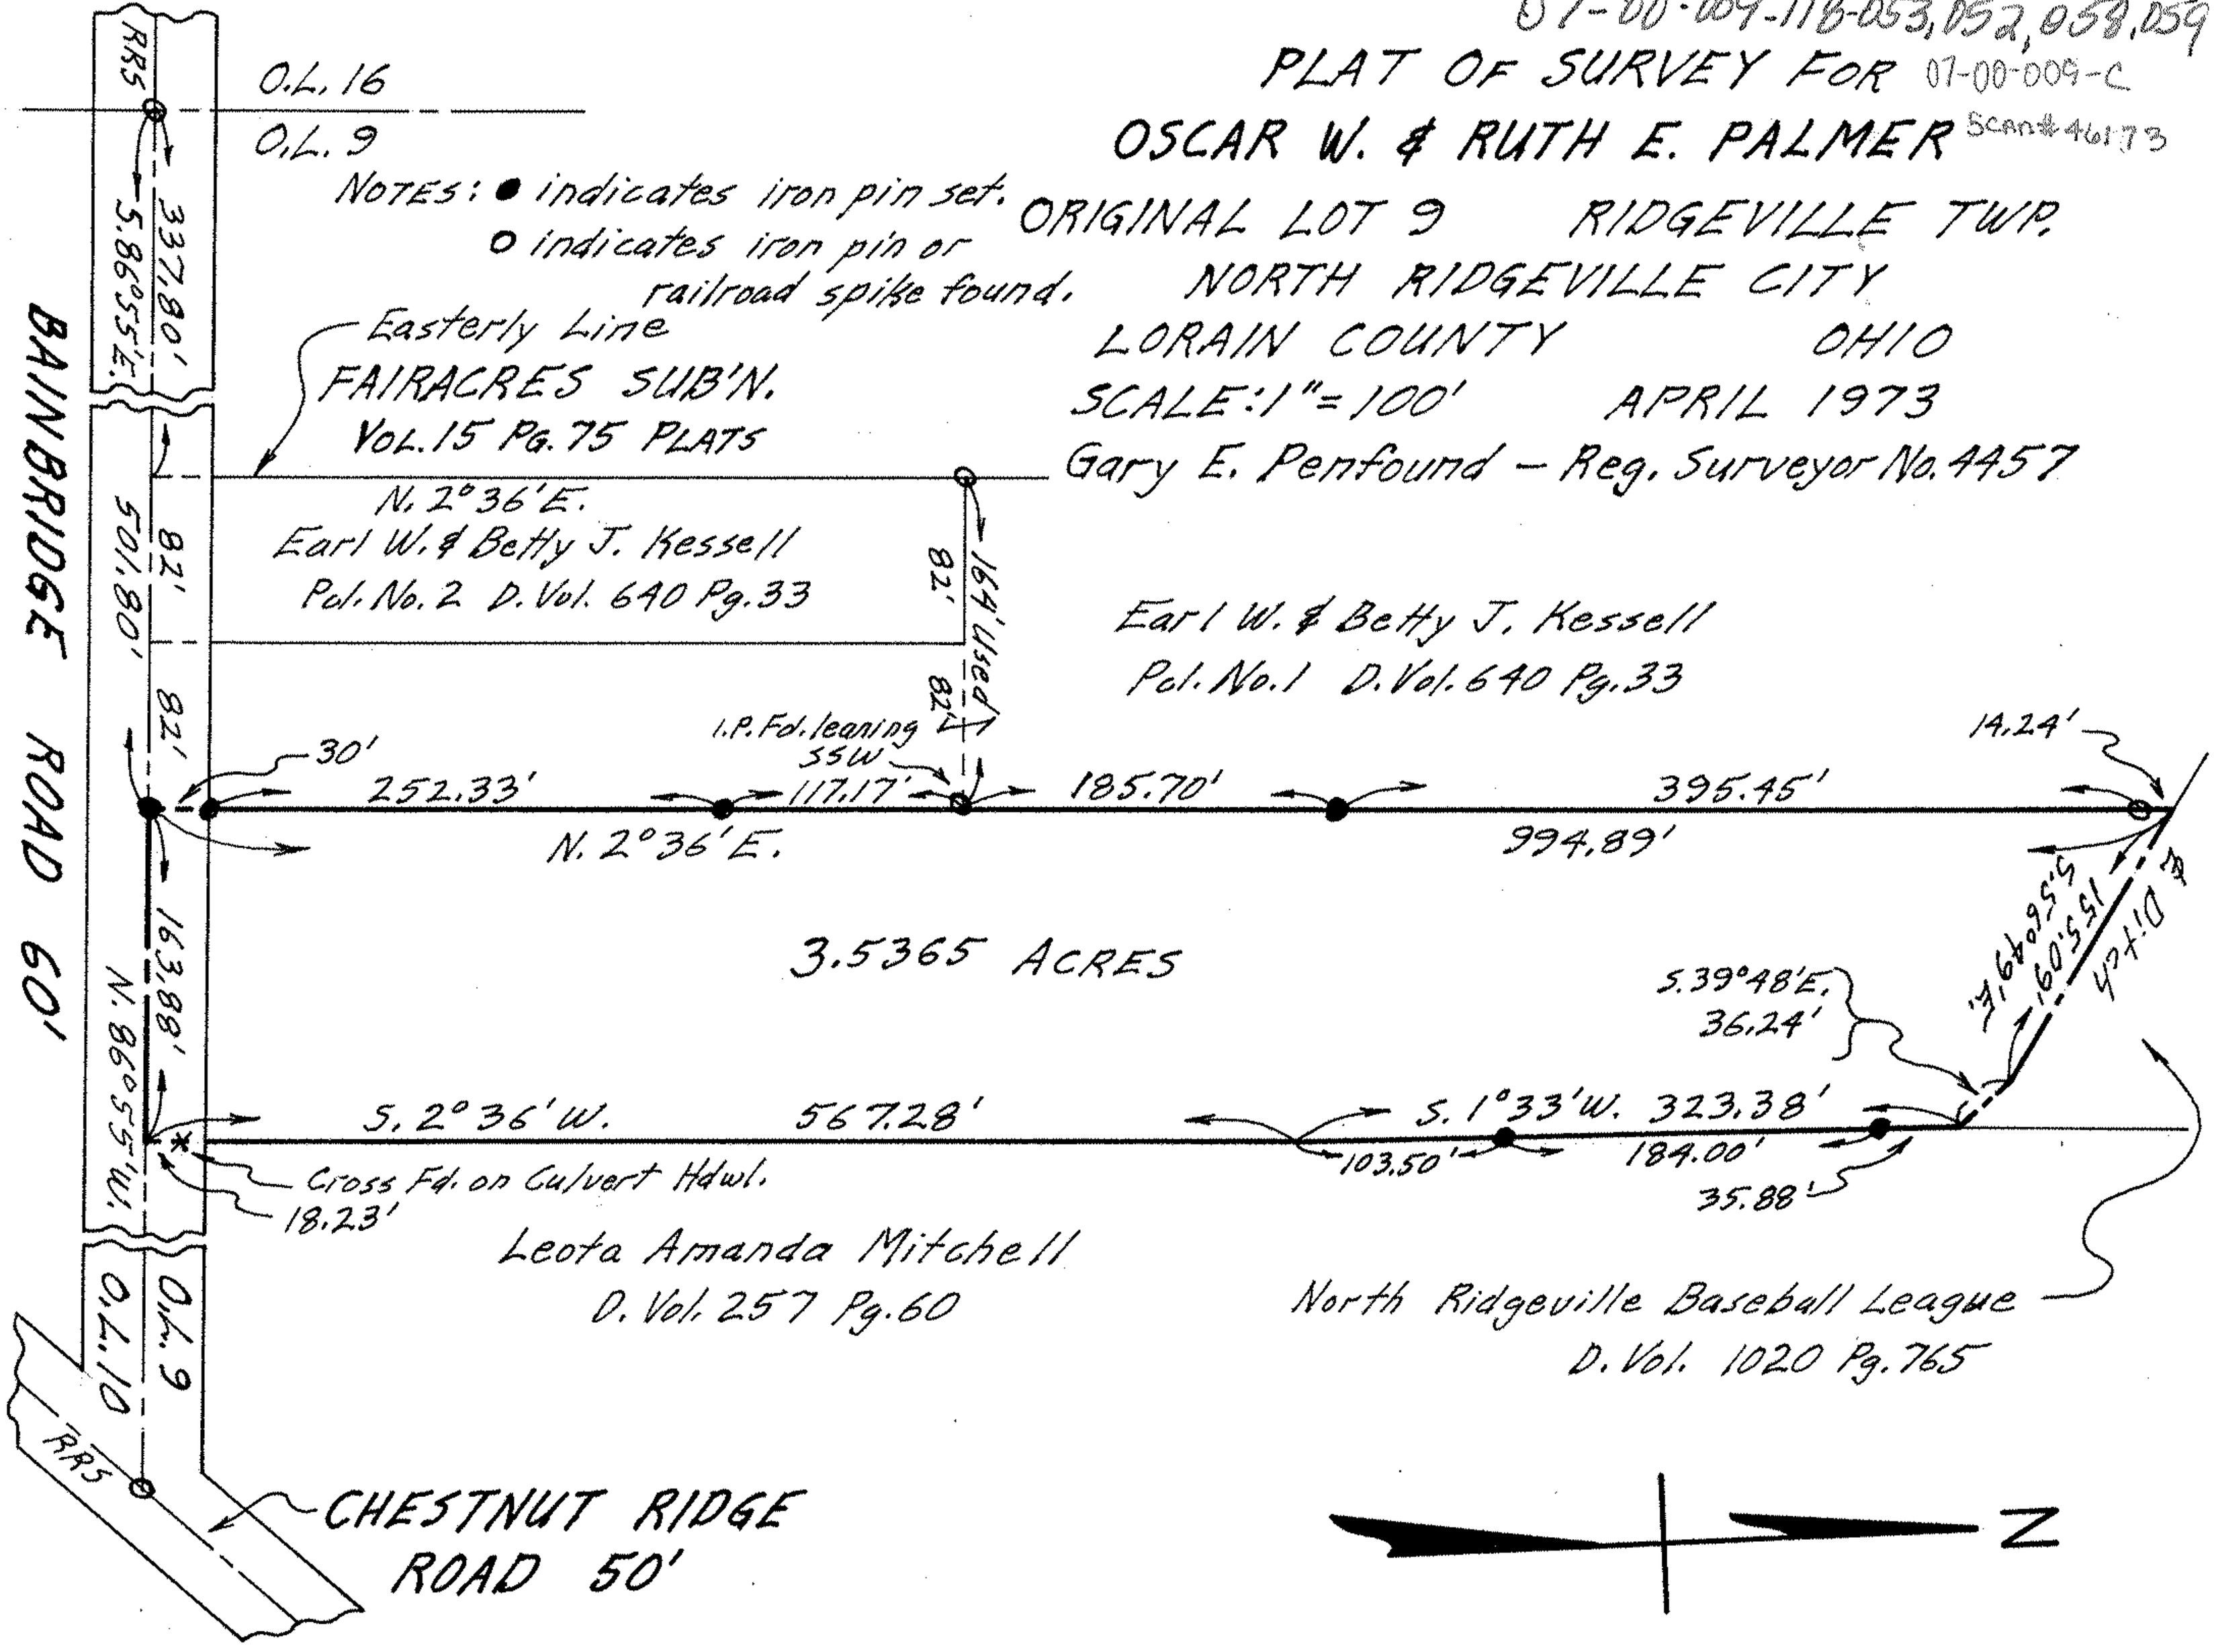
NOTES: ● indicates iron pin set.
○ indicates iron pin or railroad spike found.