PLAT OF SURVEY FOR
CLARENCE F. & CATHERINE E. HAMKER
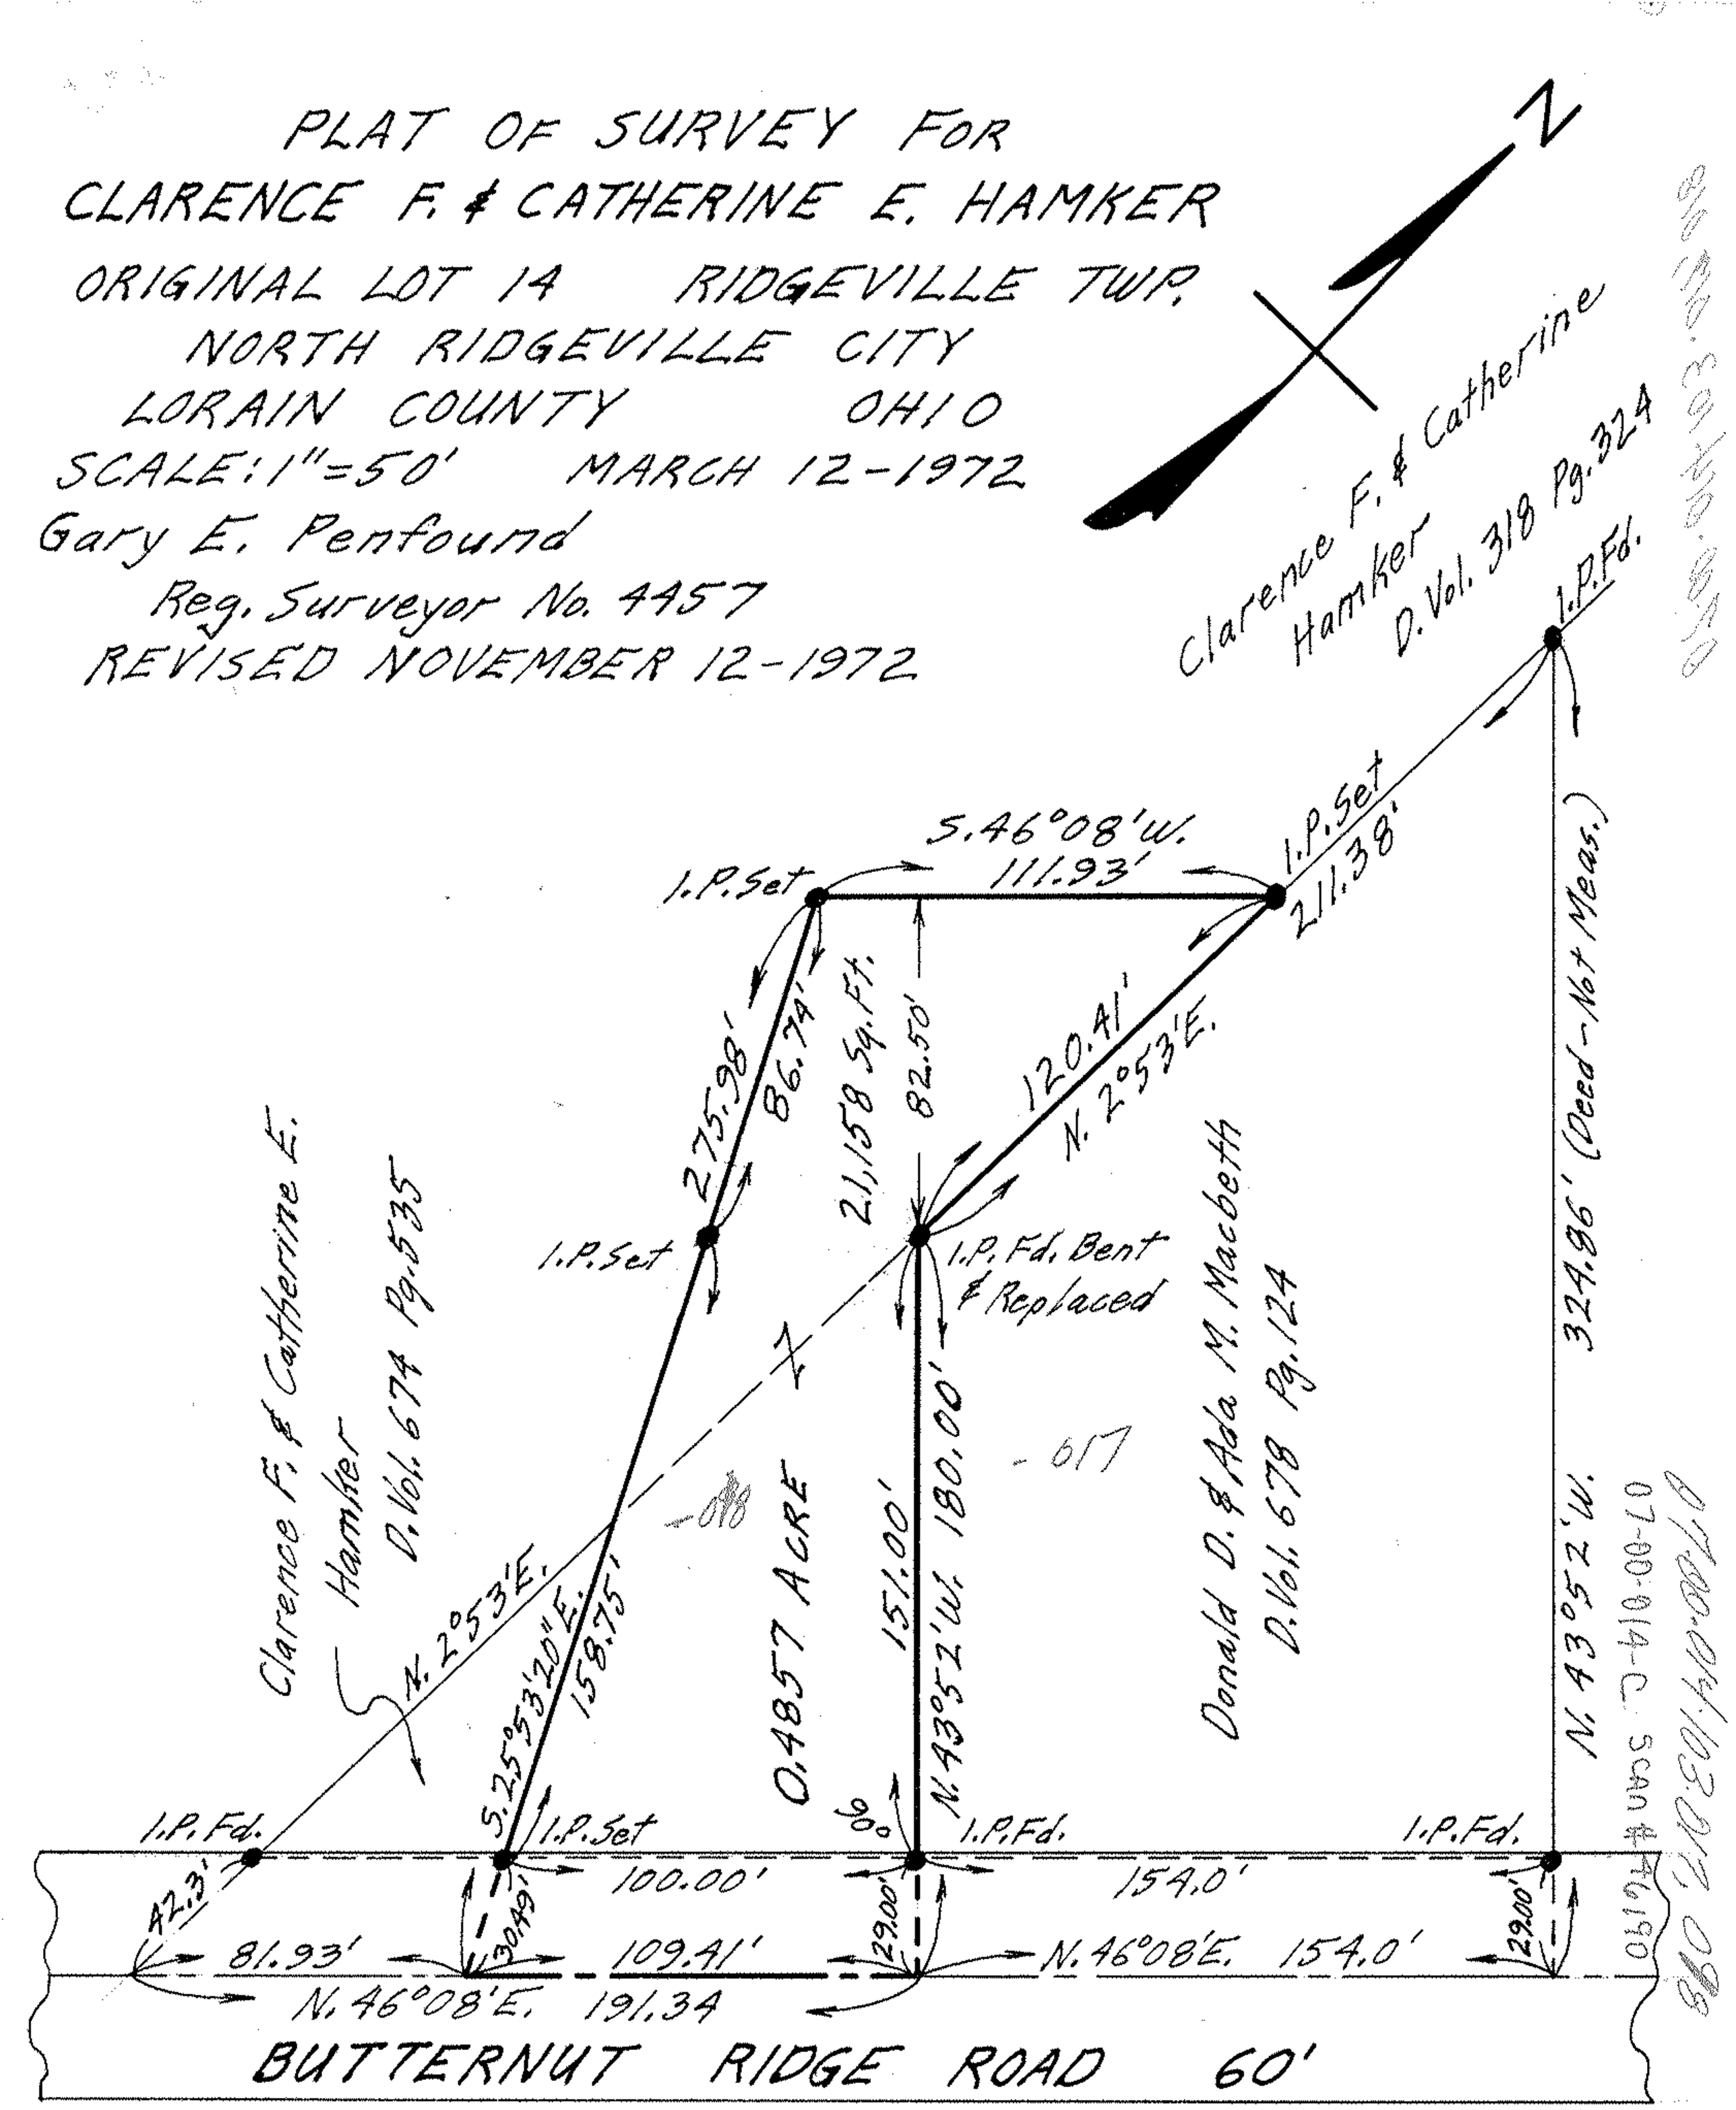
ORIGINAL LOT 14 RIDGEVILLE TWP.
NORTH RIDGEVILLE CITY
LORAIN COUNTY OHIO
SCALE: 1"=50' MARCH 12-1972
Gary E. Penfound
Reg. Surveyor No. 4457
REVISED NOVEMBER 12-1972