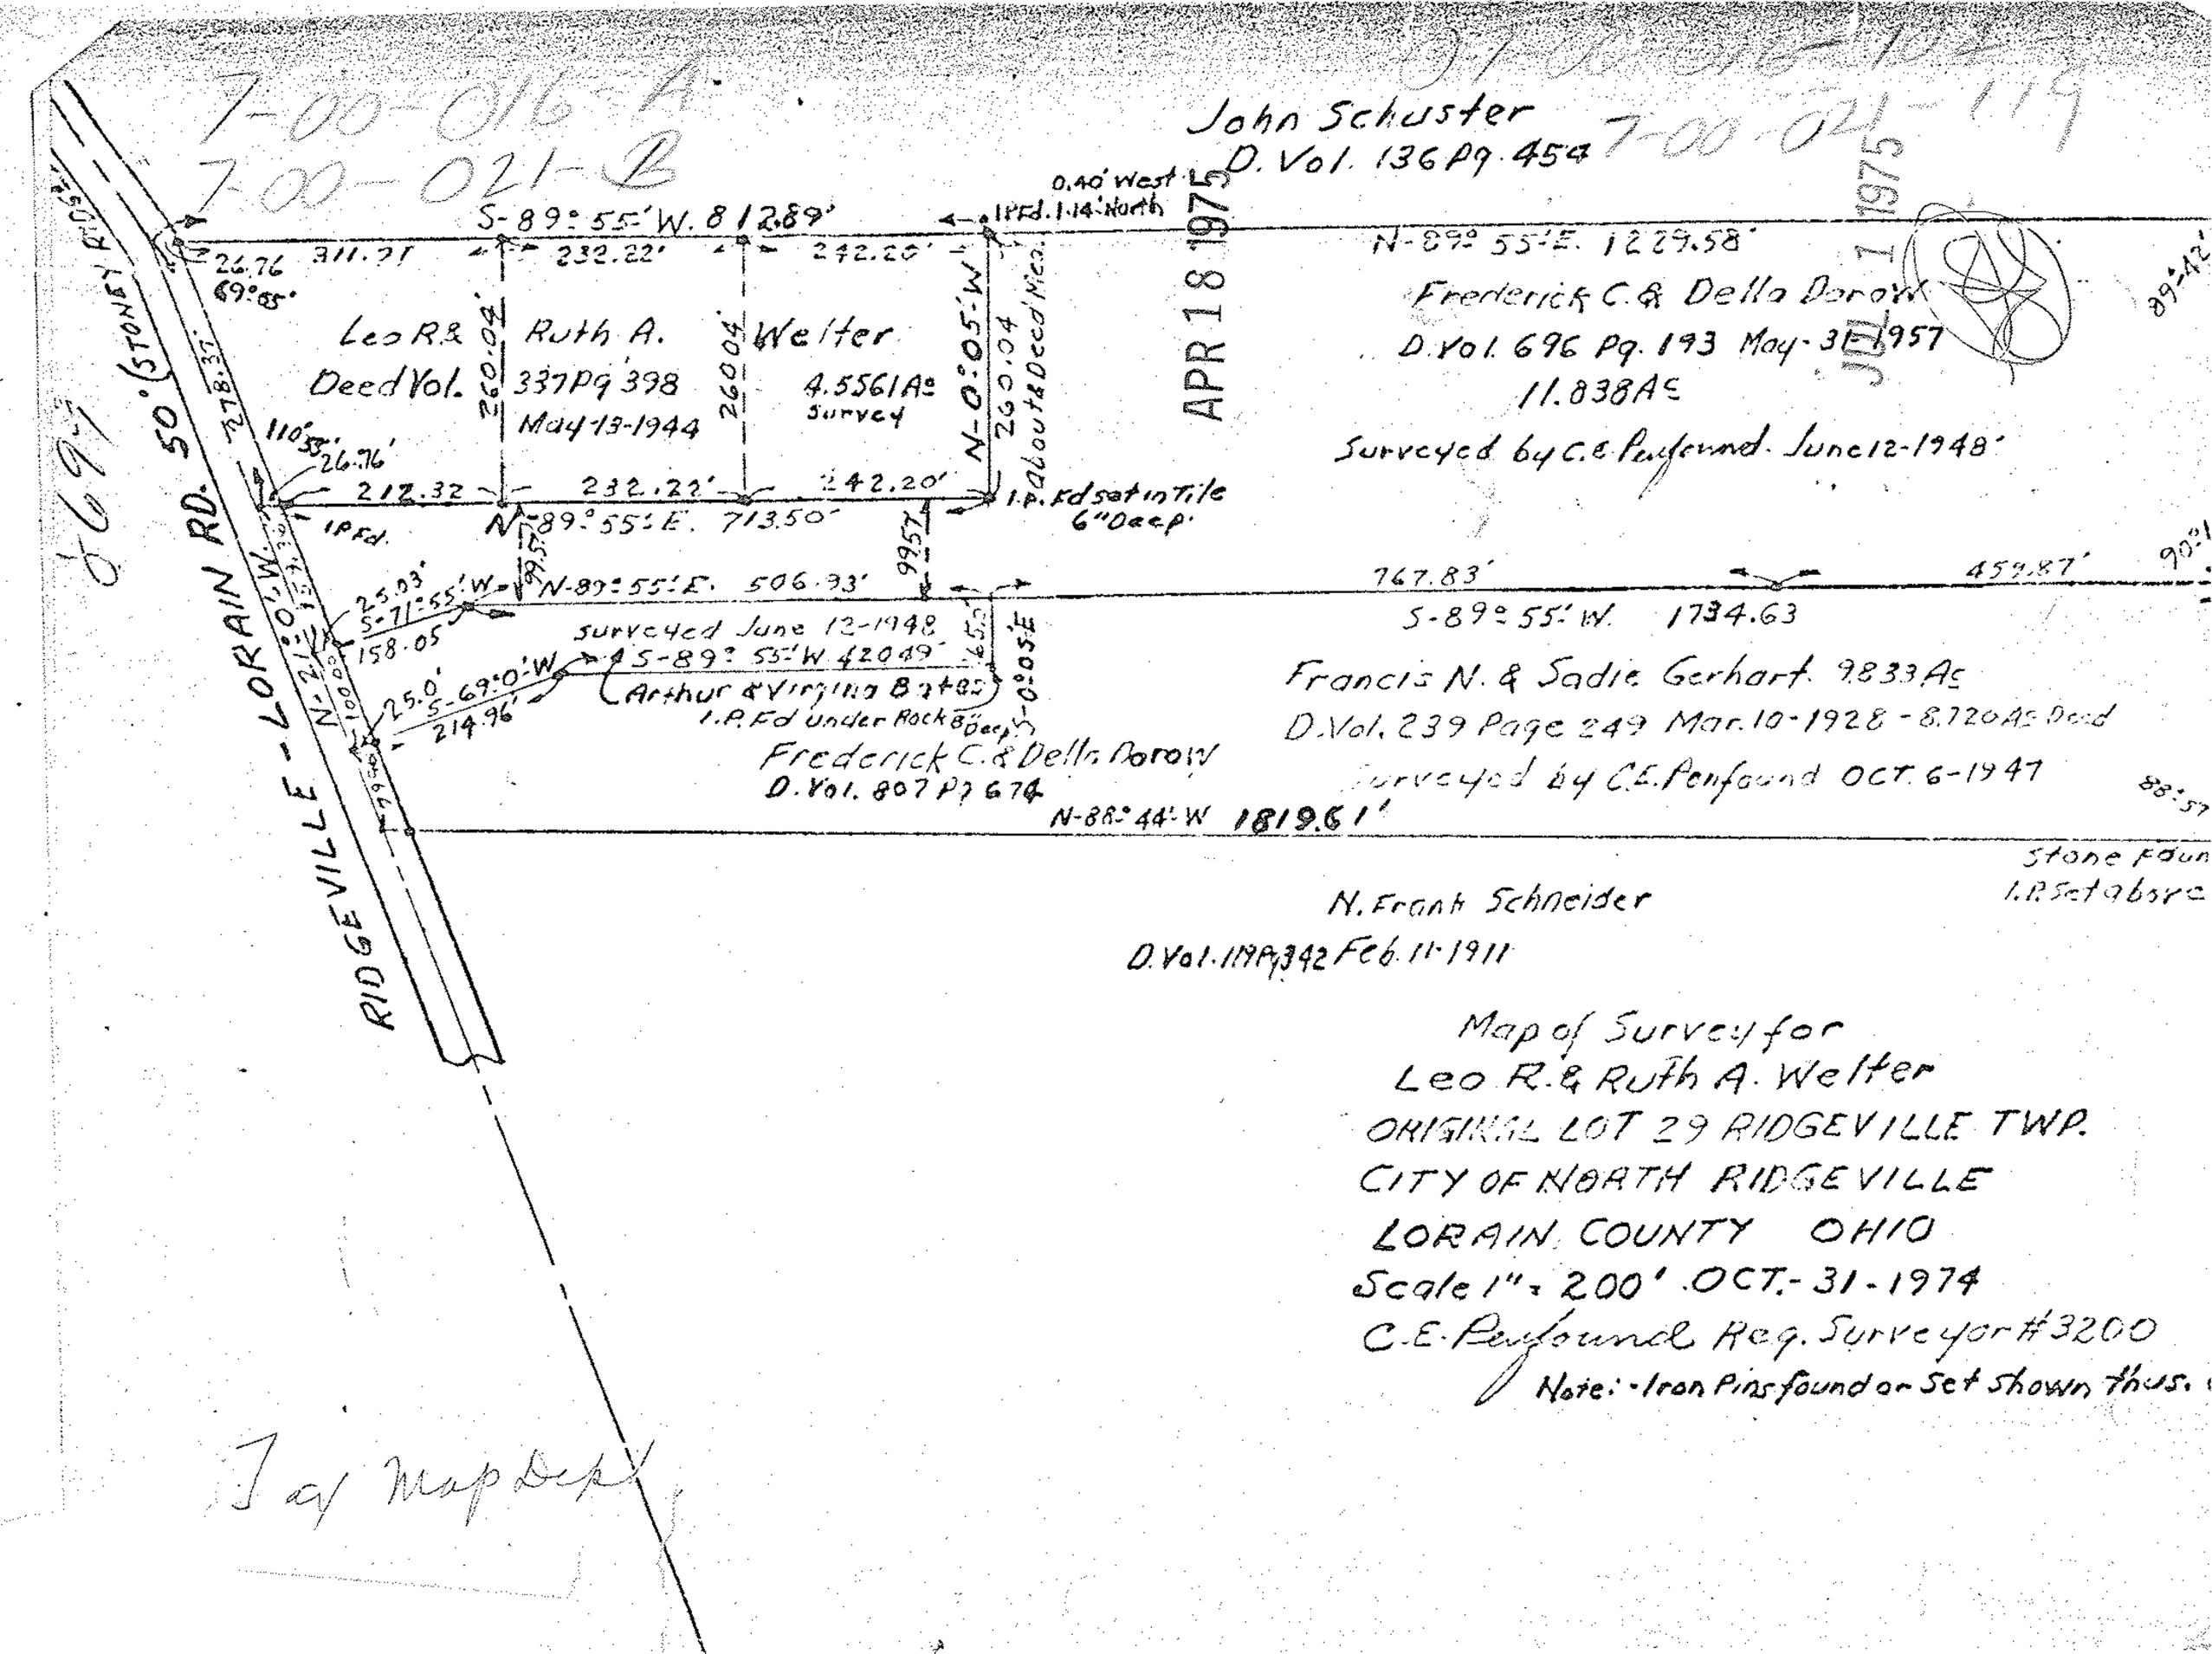

7-00-016-A
7-00-021-B
7-00-016-104
7-00-021-119
John Schuster
D. Vol. 136 Pg. 454
APR 18 1975
JUL 1 1975
S-89° 55' W. 812.89'
0.40' West
1 Pfd. 1.14' North
N-89° 55' E. 1229.58'
Frederick C. & Della Dorow
D. Vol. 696 Pg. 193 May-31-1957
11.838 Ac
Surveyed by C.E. Penfound June 12-1948
Leo R. & Ruth A. Welter
Deed Vol. 337 Pg 398
May-13-1944
4.5561 Ac Survey
260.04
N-0° 05' W
260.04 about & Deed Mea.
26.76
69° 05'
311.71
232.22'
242.20'
278.37
110° 55'
26.76'
212.32
232.22'
242.20'
1 P. Fd set in Tile 6" Deep
1 P. Fd.
N-89° 55' E. 713.50'
99.57
N-89° 55' E. 506.93'
767.83'
459.87'
S-89° 55' W. 1734.63
25.03'
S-71° 55' W
158.05
Surveyed June 12-1948
S-89° 55' W 420.49'
Arthur & Virginia Bates
1 P. Fd under Rock 8" Deep
25.0'
S-69° 0' W
214.96'
S-0° 05' E
Frederick C. & Della Dorow
D. Vol. 807 Pg 674
Francis N. & Sadie Gerhart 9.833 Ac
D. Vol. 239 Page 249 Mar. 10-1928 - 8.720 Ac Deed
Surveyed by C.E. Penfound OCT. 6-1947
N-88° 44' W 1819.61'
Stone Found
1 P. Set above
N. Frank Schneider
D. Vol. 119 Pg 342 Feb. 11-1911
RIDGEVILLE - LORAIN RD. 50' (STONEY RD.)
Map of Survey for
Leo R. & Ruth A. Welter
ORIGINAL LOT 29 RIDGEVILLE TWP.
CITY OF NORTH RIDGEVILLE
LORAIN COUNTY OHIO
Scale 1" = 200' OCT.-31-1974
C.E. Penfound Reg. Surveyor #3200
Note: - Iron Pins found or Set shown thus.
Tax Map Dept