07-00-017-106-012-015
07-00-017-C
Scan # 46207

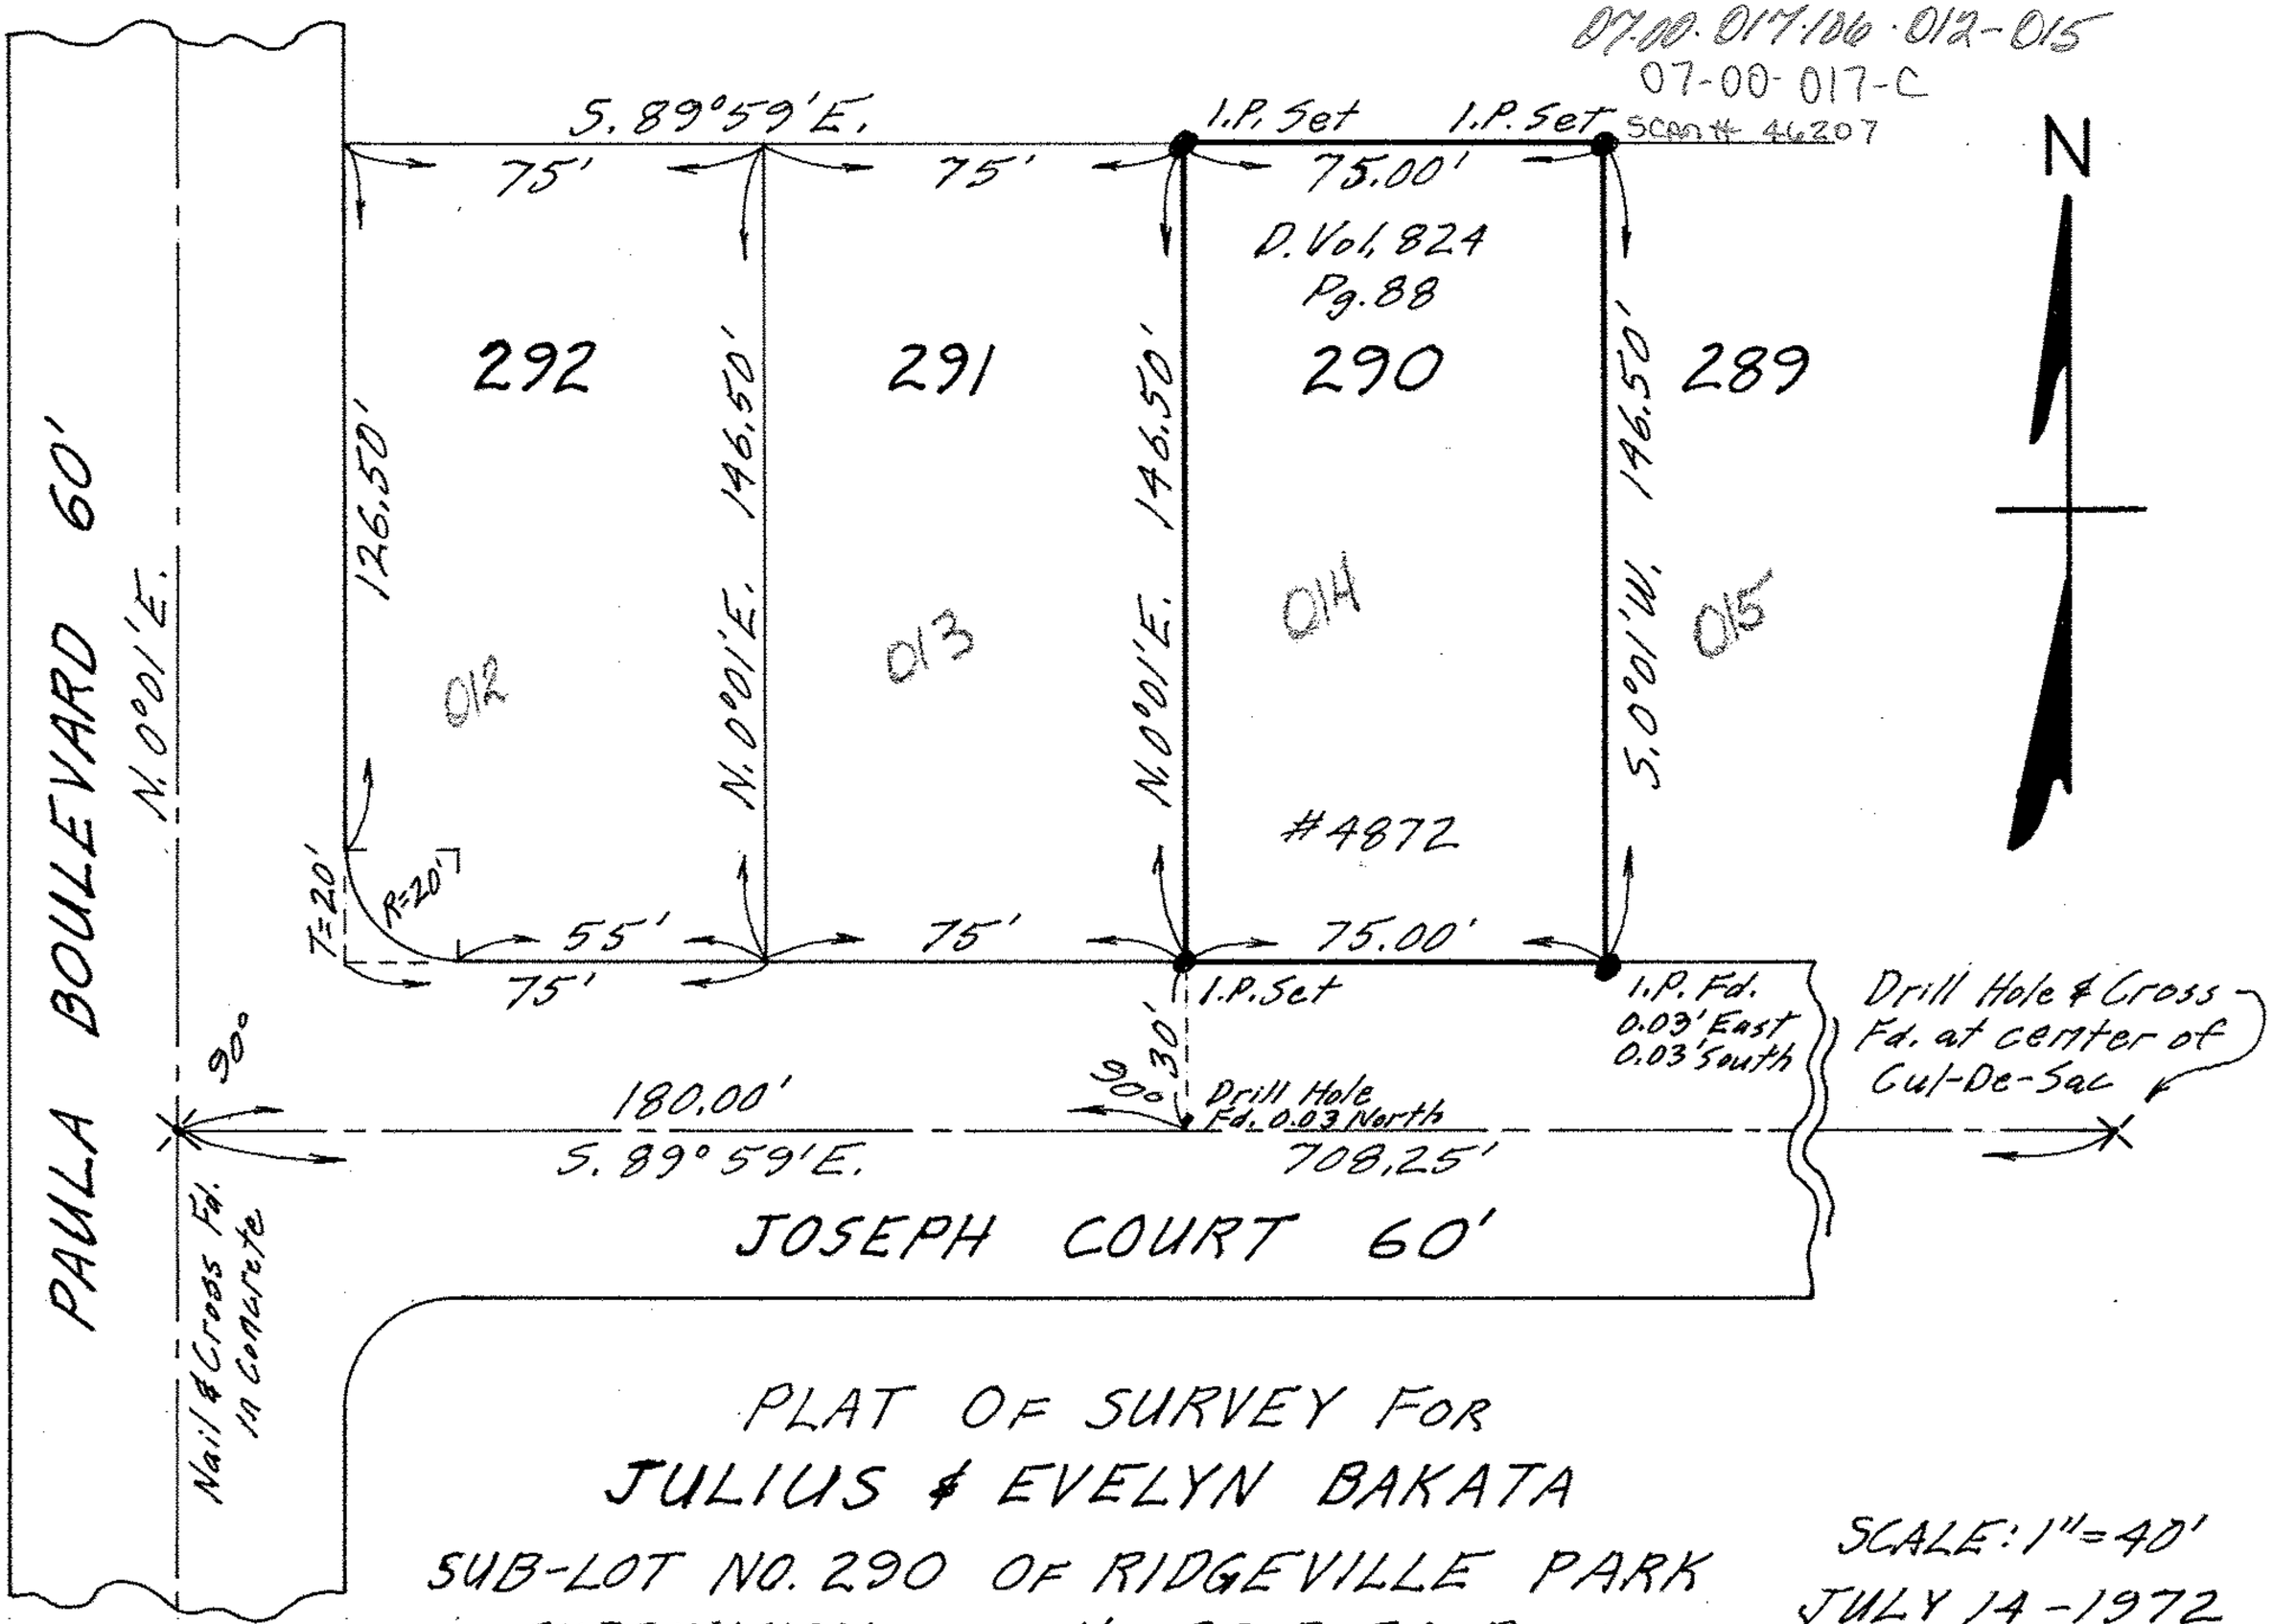

PLAT OF SURVEY FOR
JULIUS & EVELYN BAKATA
SUB-LOT NO. 290 OF RIDGEVILLE PARK
SUBDIVISION VOL. 20 PG. 20 PLATS
ORIGINAL LOT 17 RIDGEVILLE TWP.
NORTH RIDGEVILLE CITY
LORAIN COUNTY OHIO

SCALE: 1" = 40'
JULY 14 - 1972
Gary E. Penfound
Reg. Surveyor No. 4457