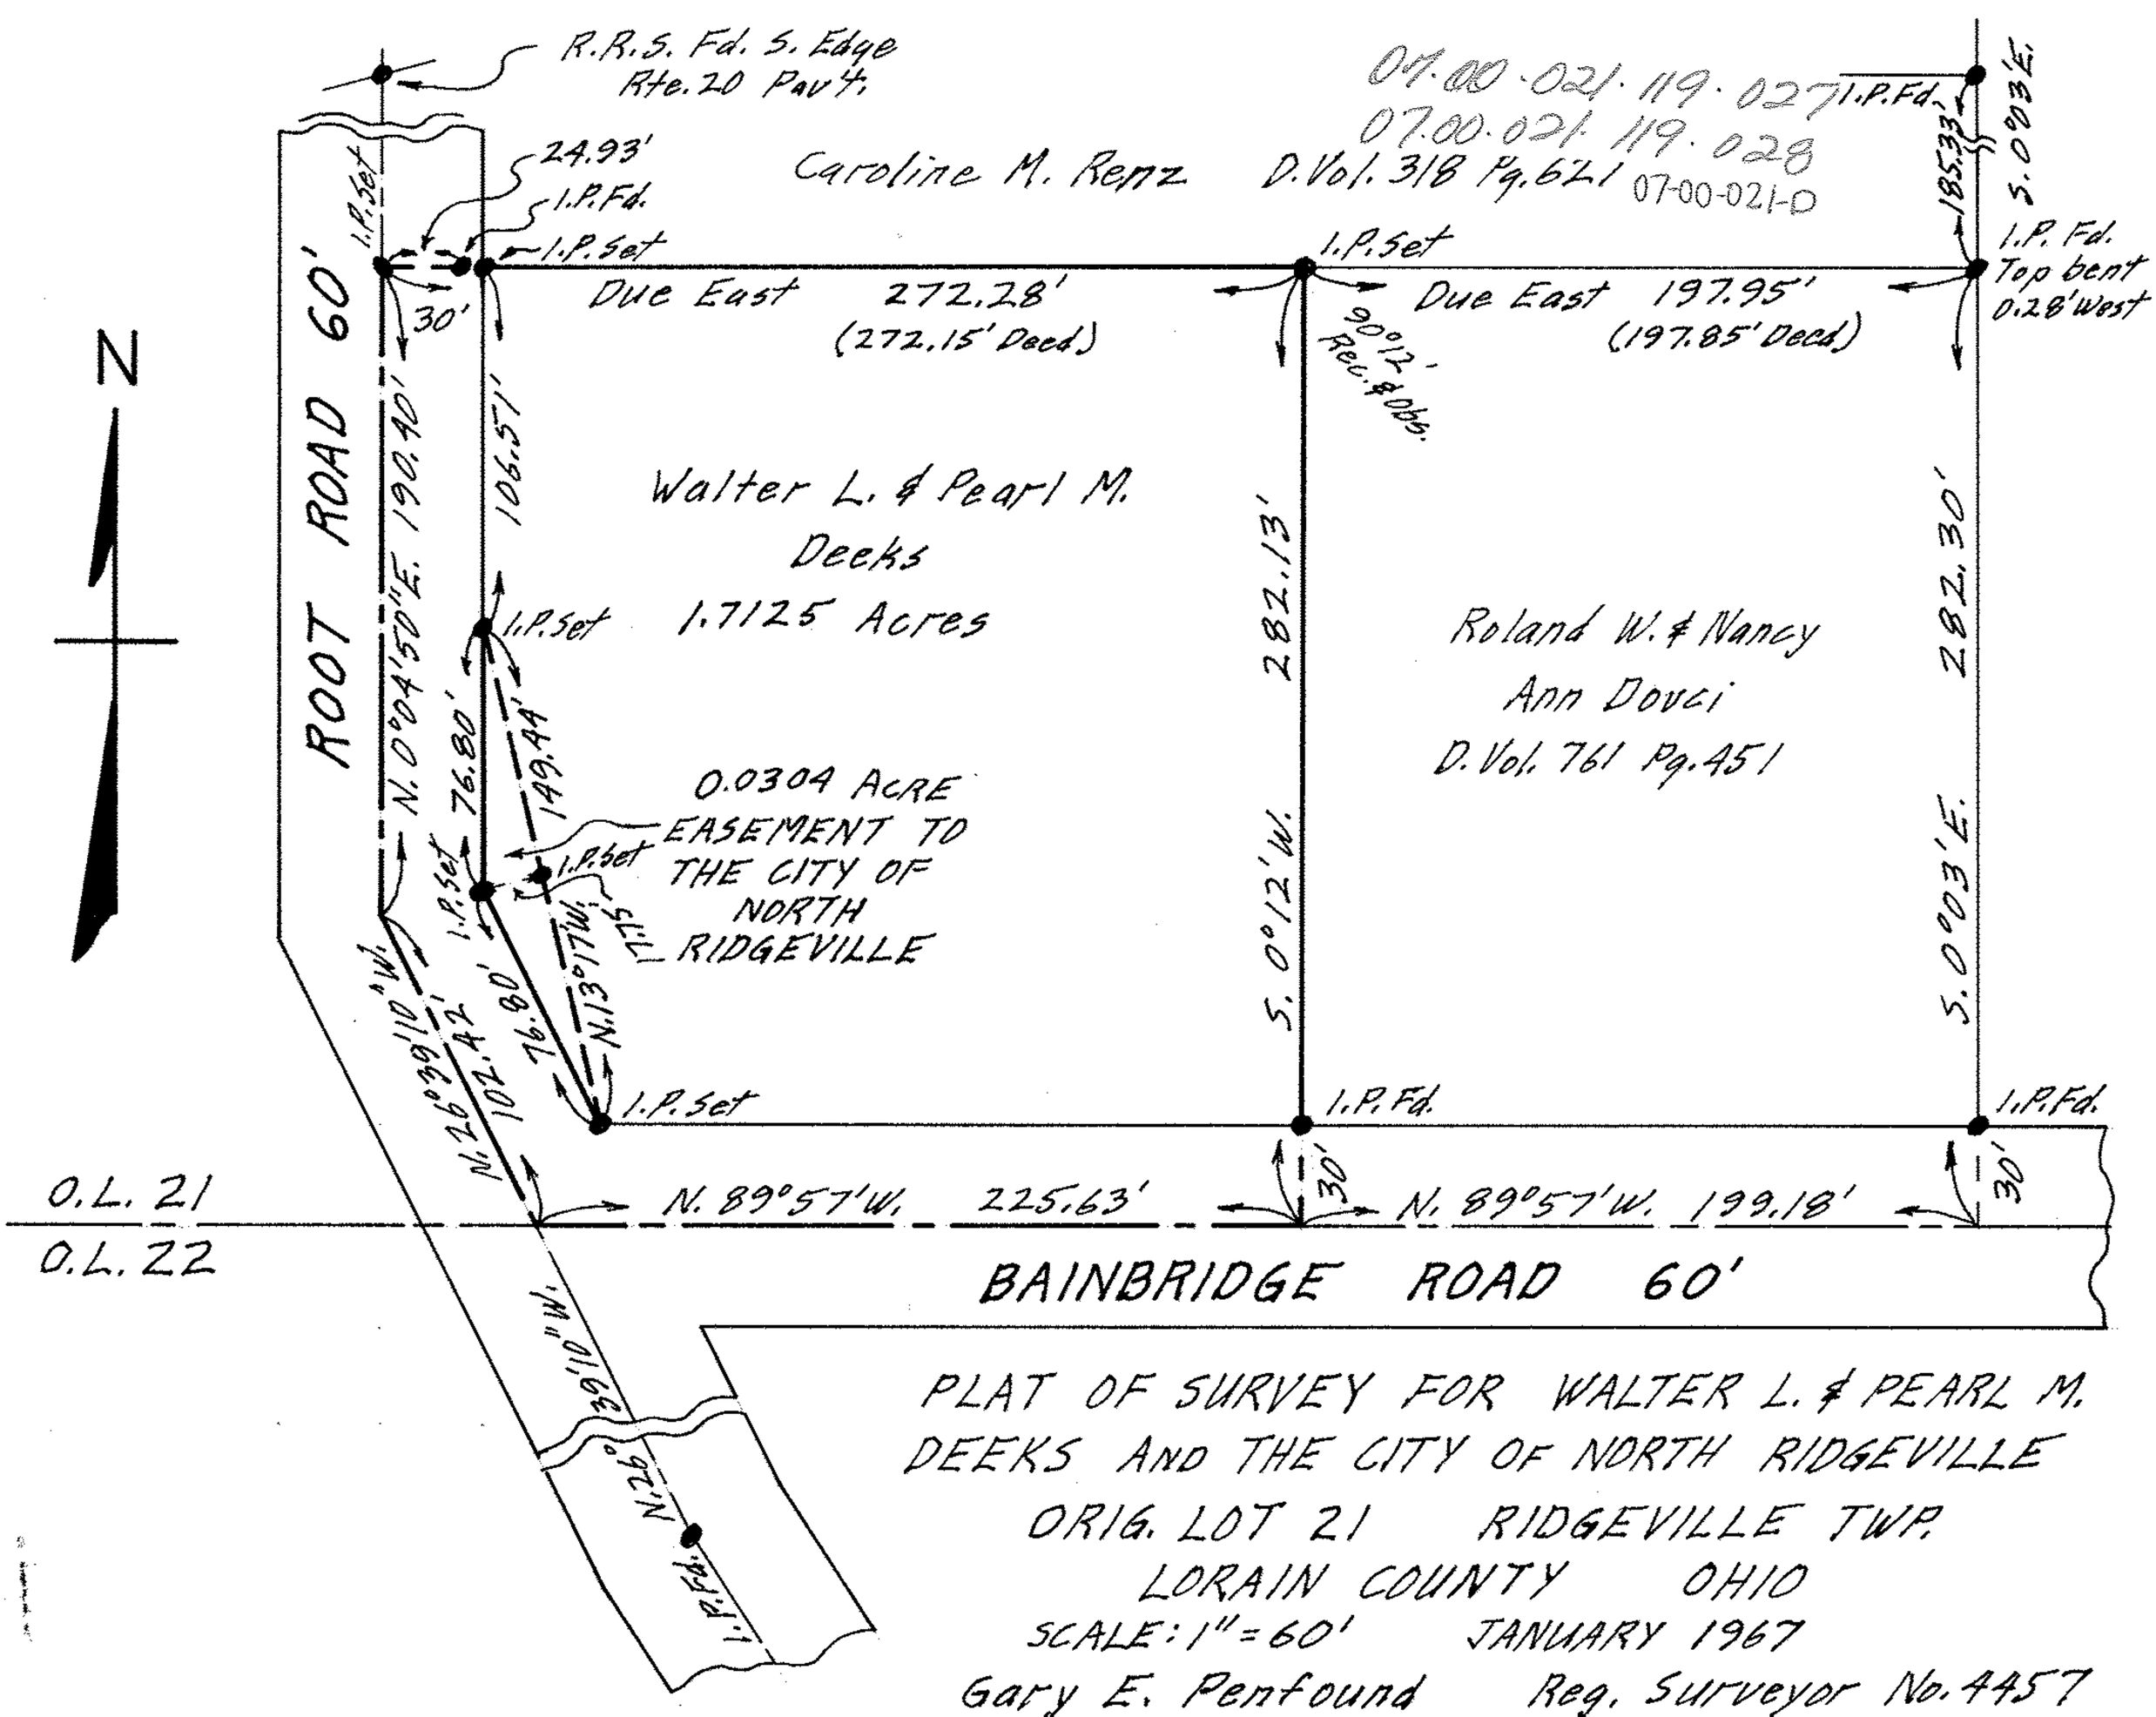

PLAT OF SURVEY FOR WALTER L. & PEARL M. DEEKS AND THE CITY OF NORTH RIDGEVILLE

ORIG. LOT 21 RIDGEVILLE TWP.

LORAIN COUNTY OHIO

SCALE: 1" = 60' JANUARY 1967

Gary E. Penfound Reg. Surveyor No. 4457