PLAT OF SURVEY

STATE OF OHIO, COUNTY OF LORAIN

CITY / ~~VILLAGE~~ NORTH RIDGEVILLE TOWNSHIP ORIGINAL RIDGEVILLE

LOT 22 SECTION _____ TRACT _____ RANGE _____ O.L. _____

MADE FOR WINTERFIELD BY Donald E. Himes DONALD E. HIMES, REG. SUR. NO. 6163, STRONGSVILLE, OHIO
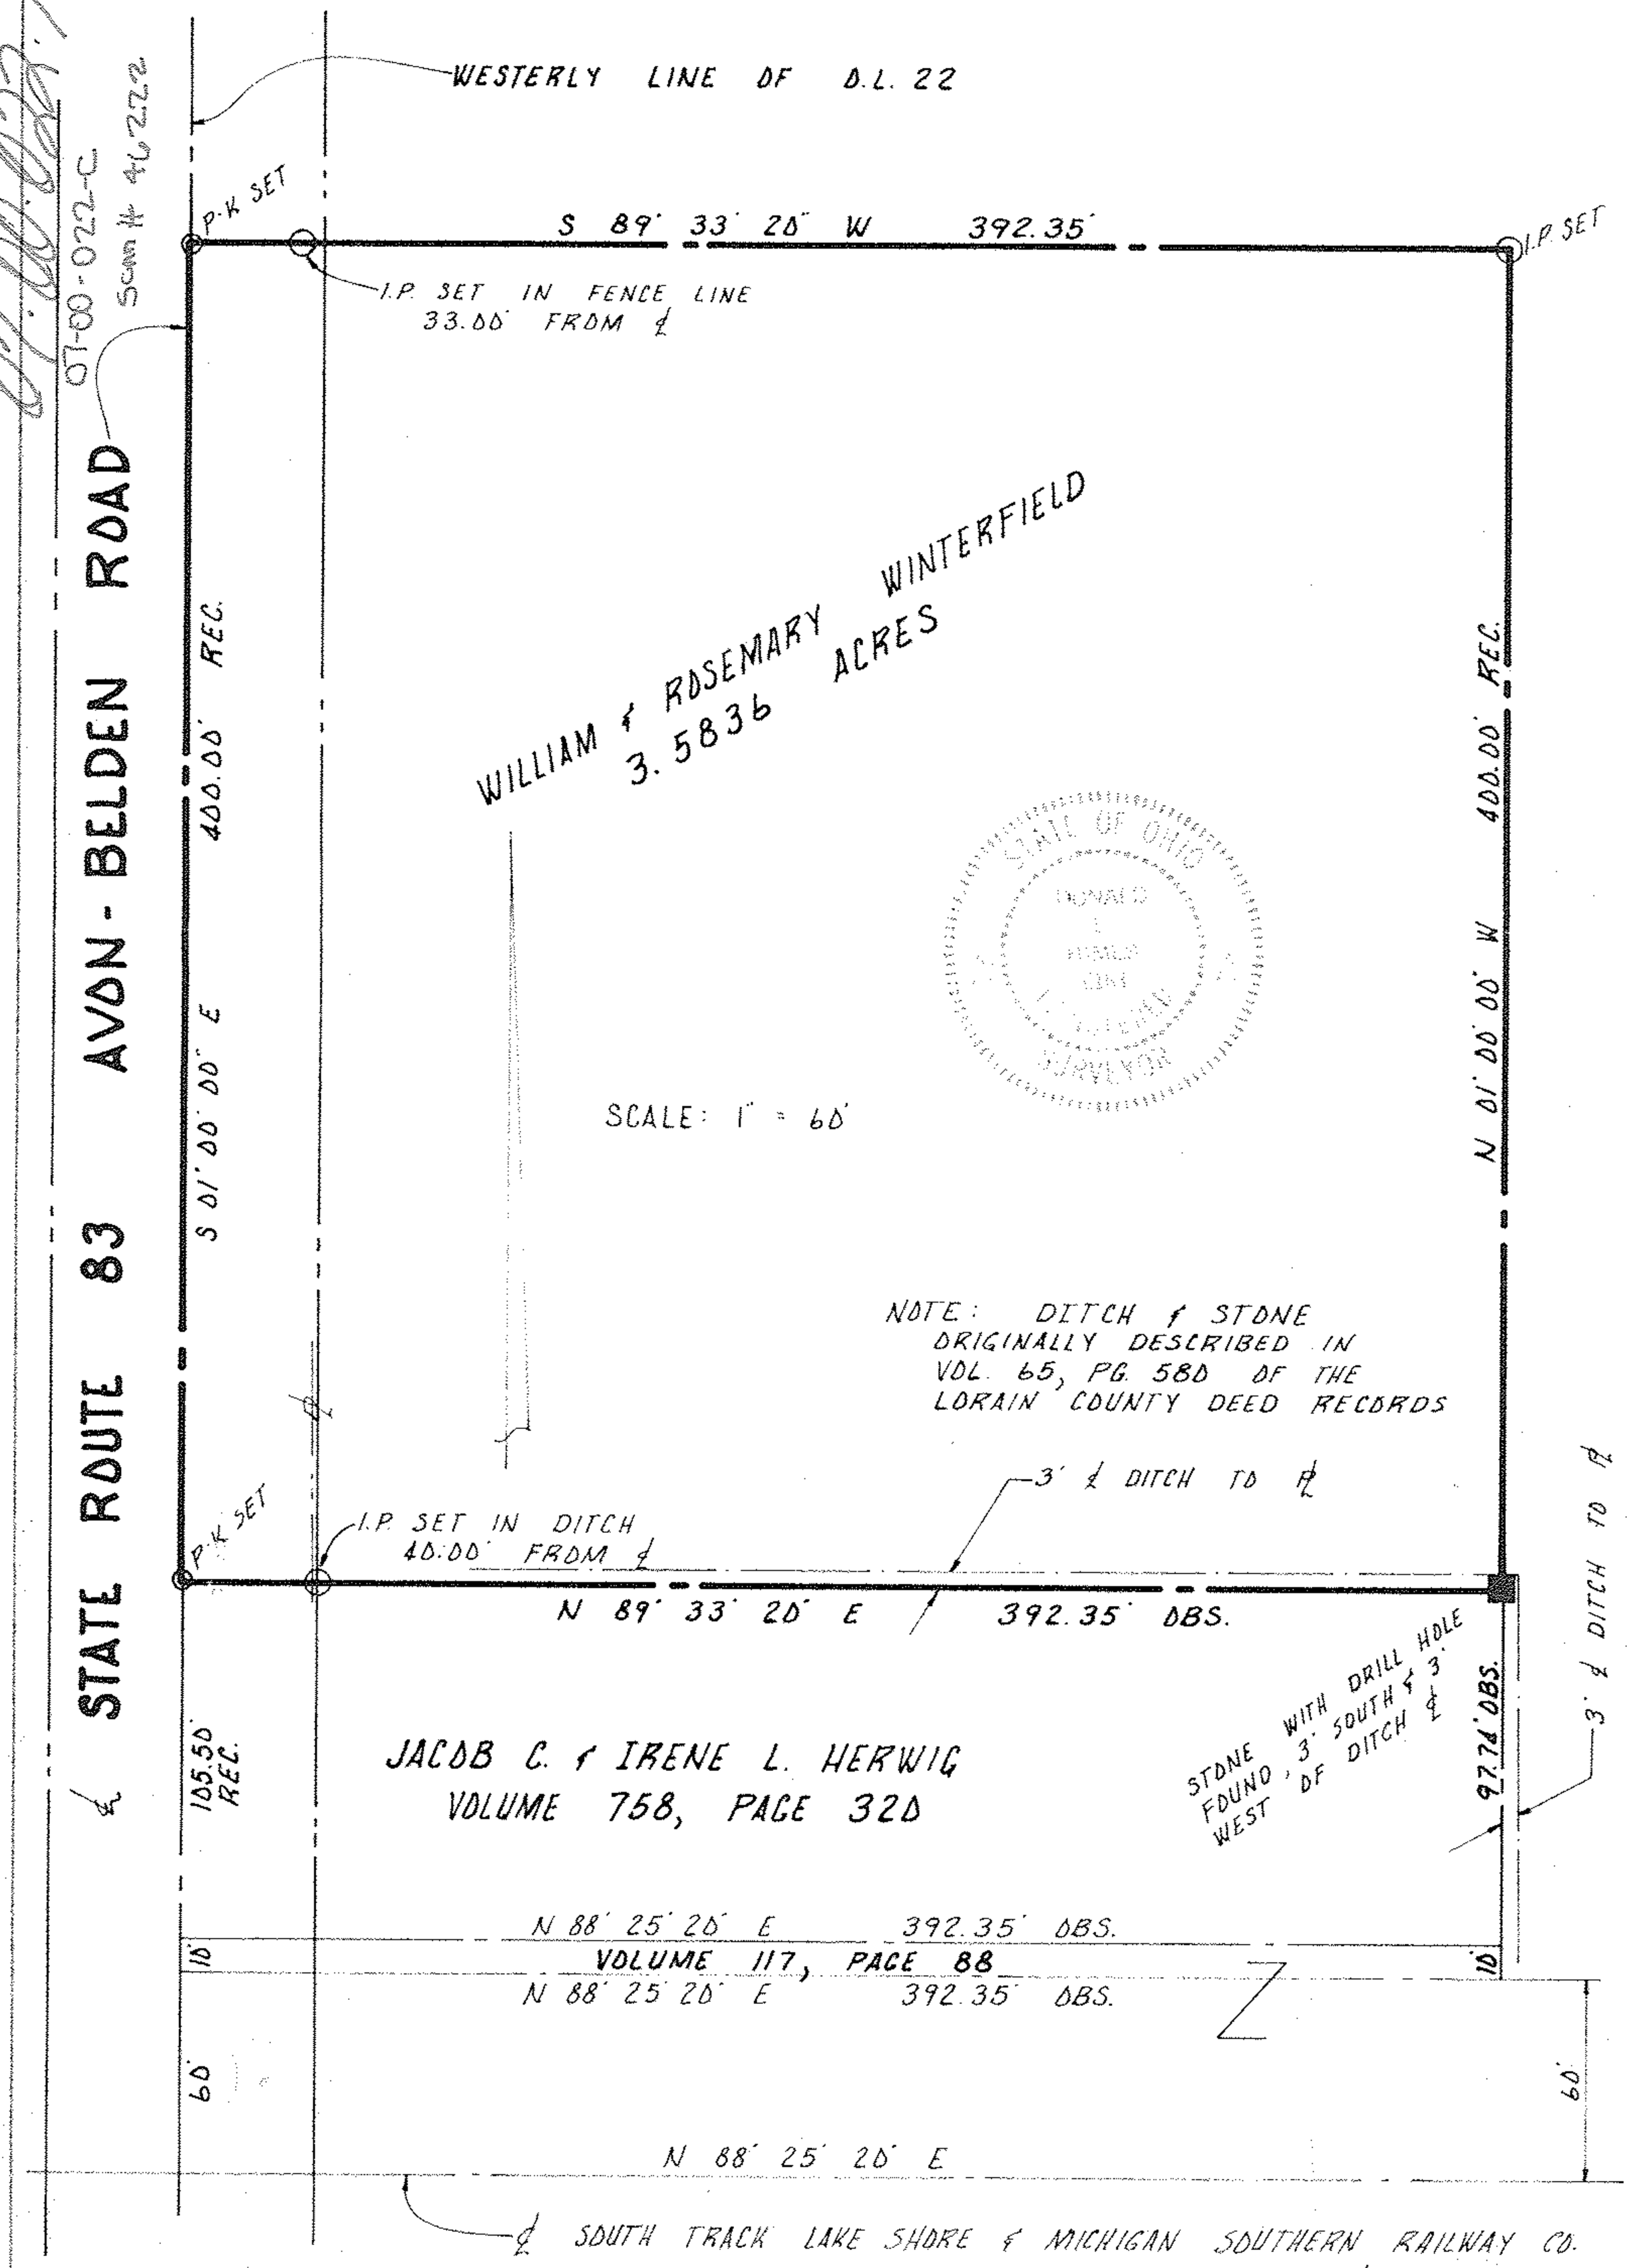
07-00-022-C
Scan # 46222