


Scan # 46223
 07-00-023-101-0222
 07-00-024-101-049 07-00-023-C
 07-00-023-101-0222
 07-00-024-101-049

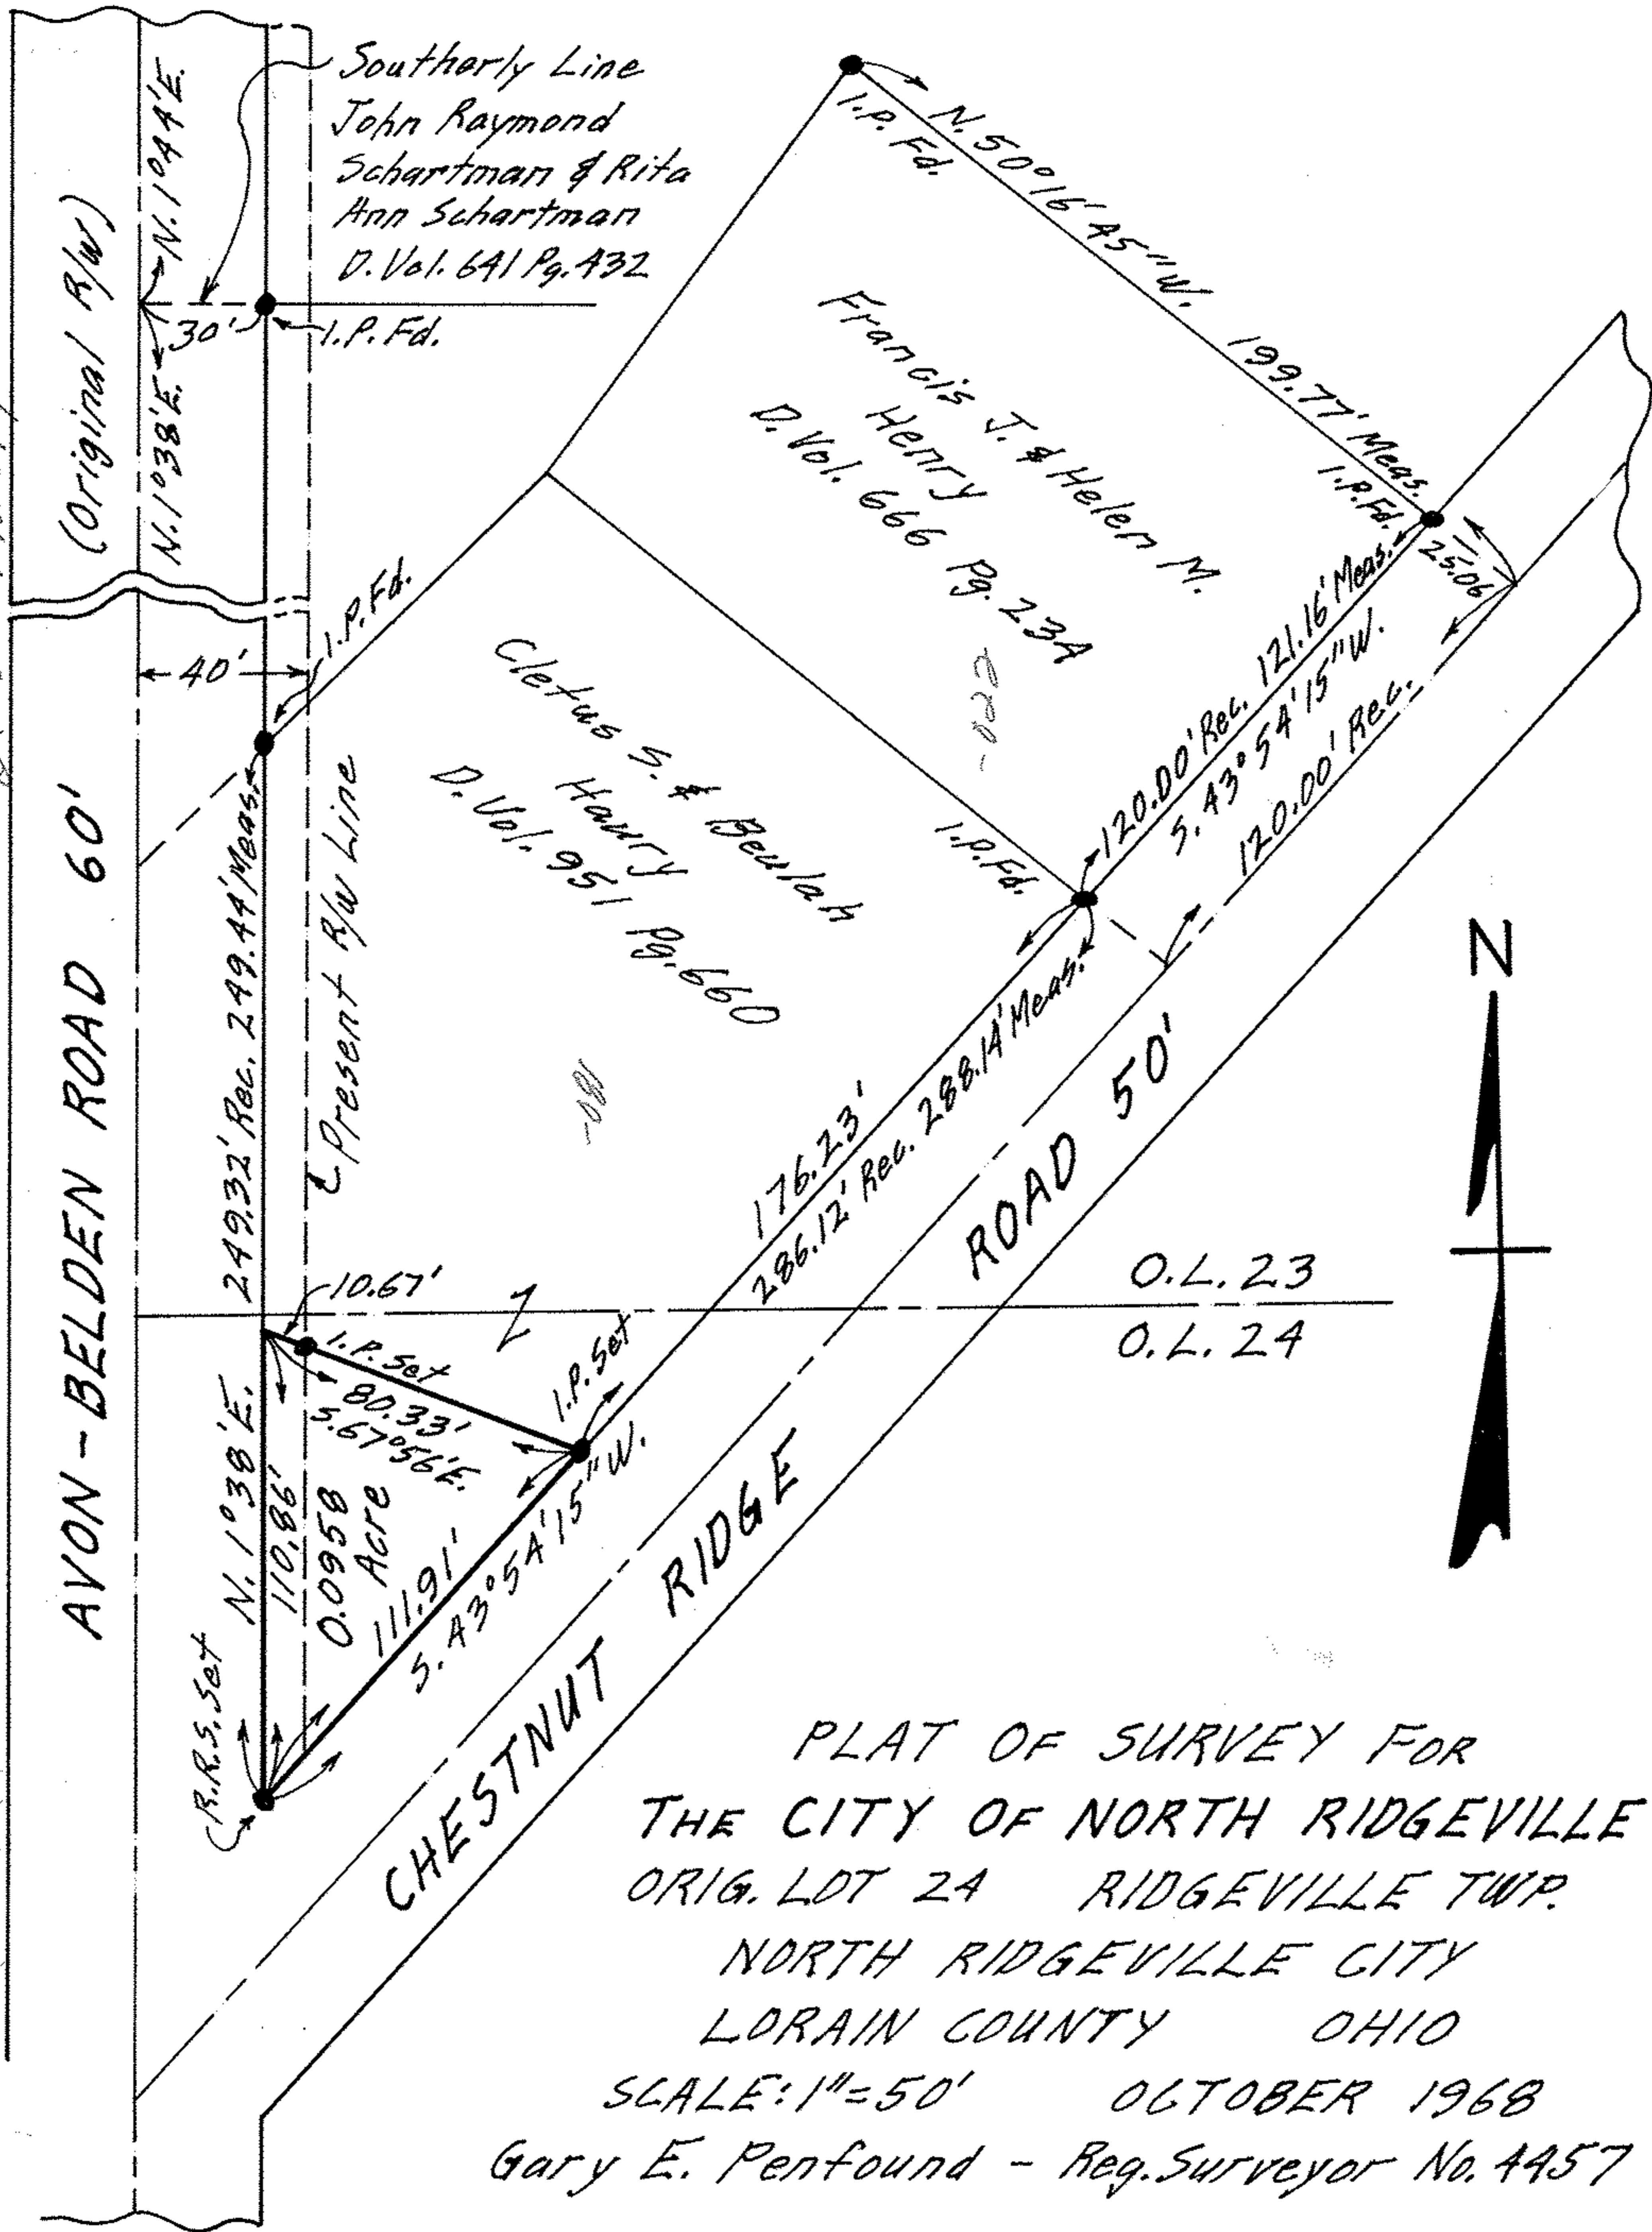

Southerly Line
 John Raymond
 Schartman & Rita
 Ann Schartman
 D. Vol. 641 Pg. 432

Francis J. & Helen M.
 Henry
 D. Vol. 666 Pg. 23A

Cletus S. & Beulah
 Henry
 D. Vol. 951 Pg. 660

O.L. 23
 O.L. 24

PLAT OF SURVEY FOR
 THE CITY OF NORTH RIDGEVILLE
 ORIG. LOT 24 RIDGEVILLE TWP.
 NORTH RIDGEVILLE CITY
 LORAIN COUNTY OHIO
 SCALE: 1"=50' OCTOBER 1968
 Gary E. Penfound - Reg. Surveyor No. 4457