Scan # 46224 07.00.023.101.027 07-00-023-B

Diederick & Myrtle Von Kamp Oct. 10-1919 D. Vol. 162 Pg. 227

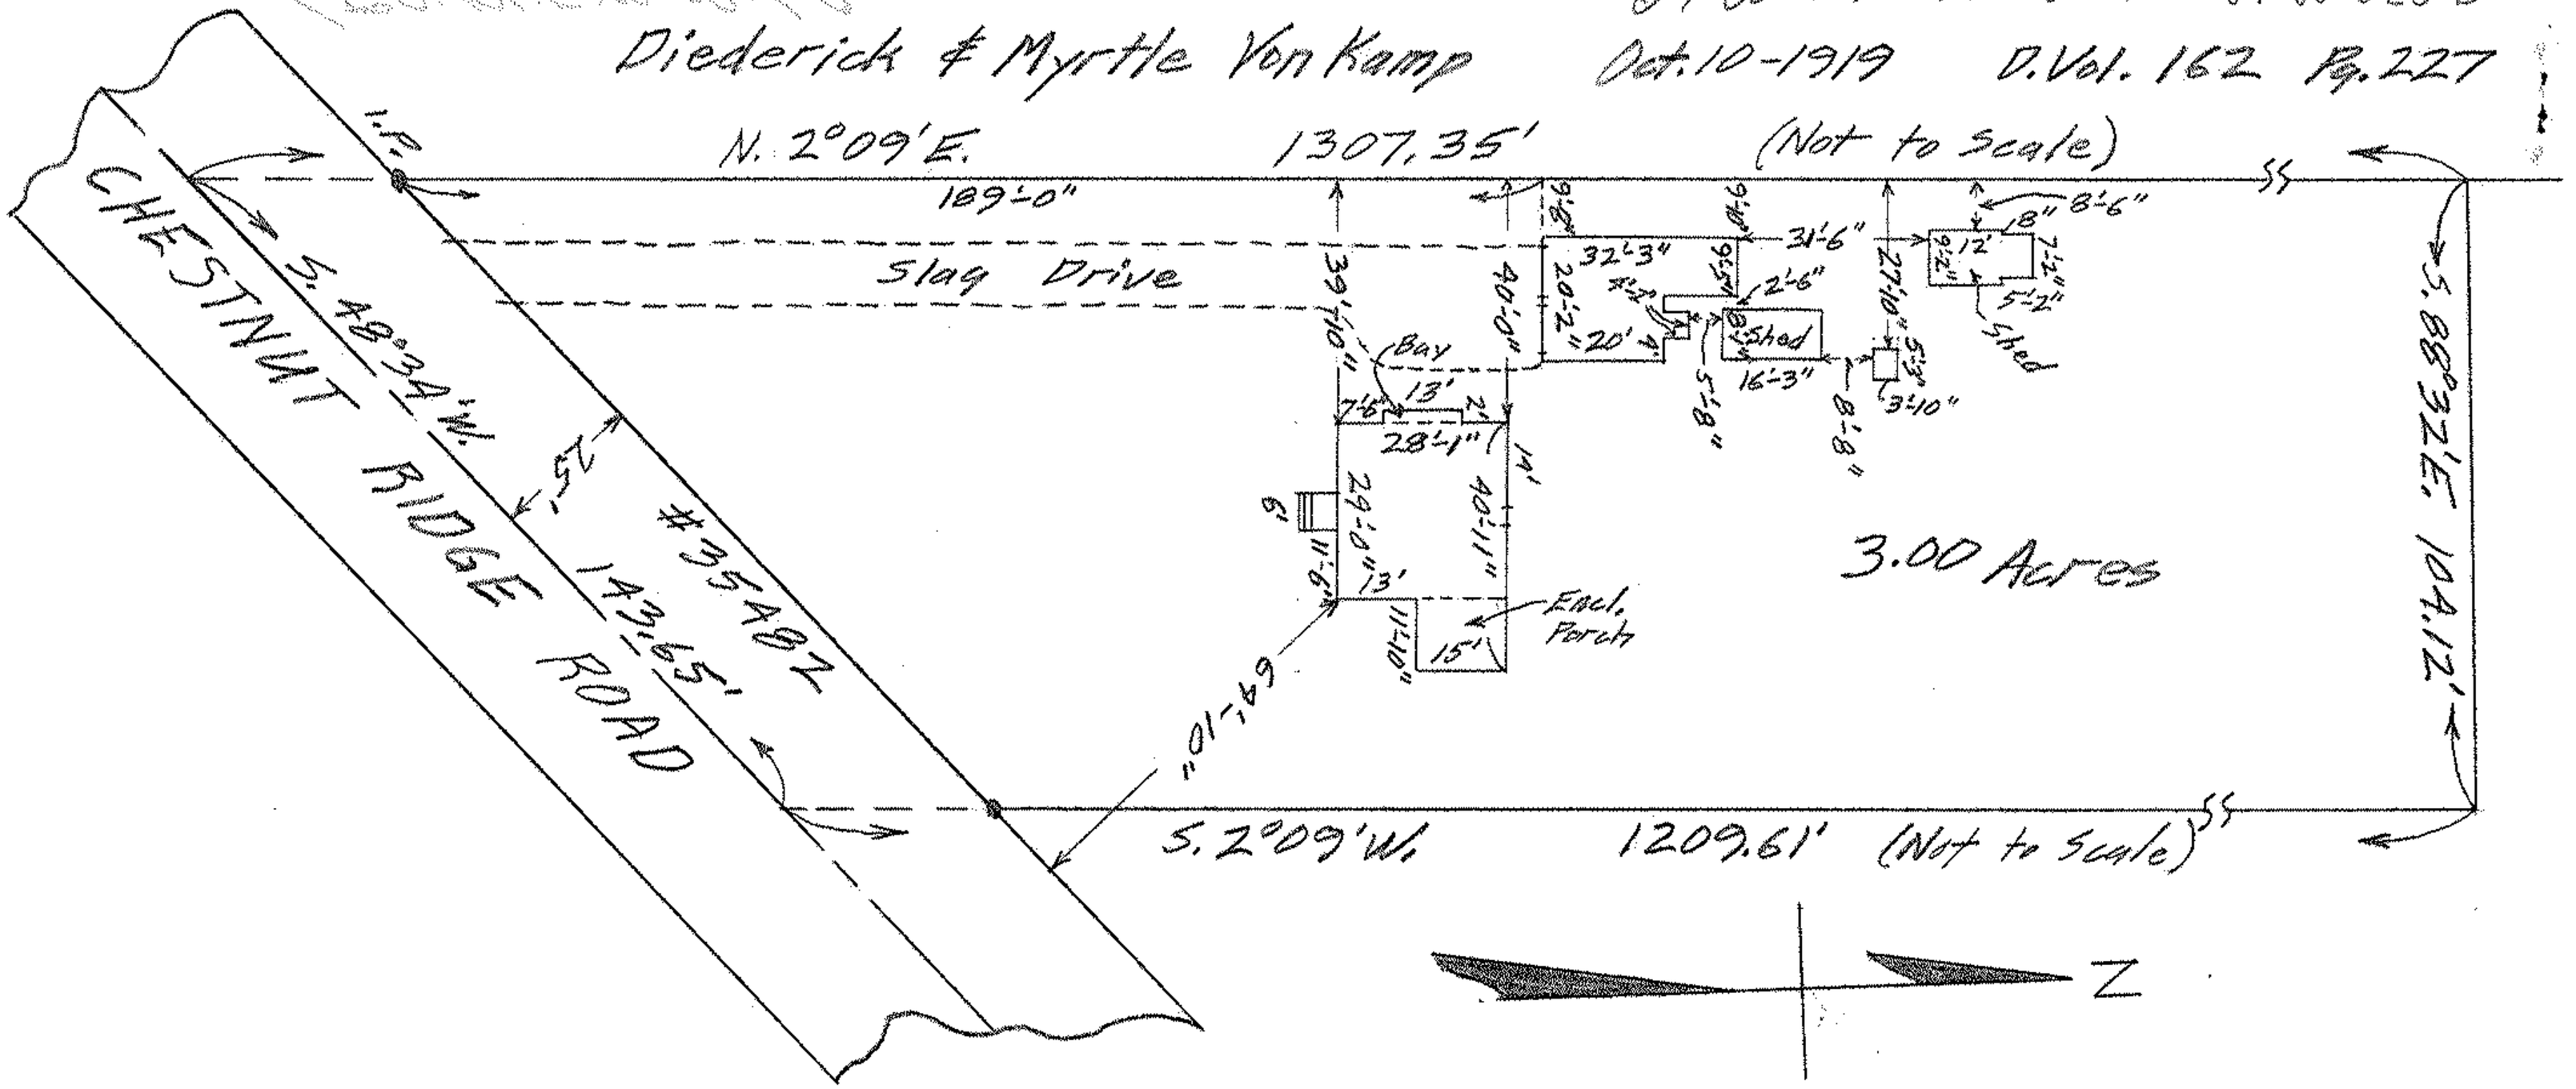

MAP OF PART OF ORIG. LOT NO. 23

RIDGEVILLE TWP. NORTH RIDGEVILLE CITY

LORAIN COUNTY OHIO

SCALE: 1"=40' DEC. 21-1963 11:45 A.M.

Gary E. Penfound REG. SURVEYOR

William A. & Estelle C. Schrauf

W W