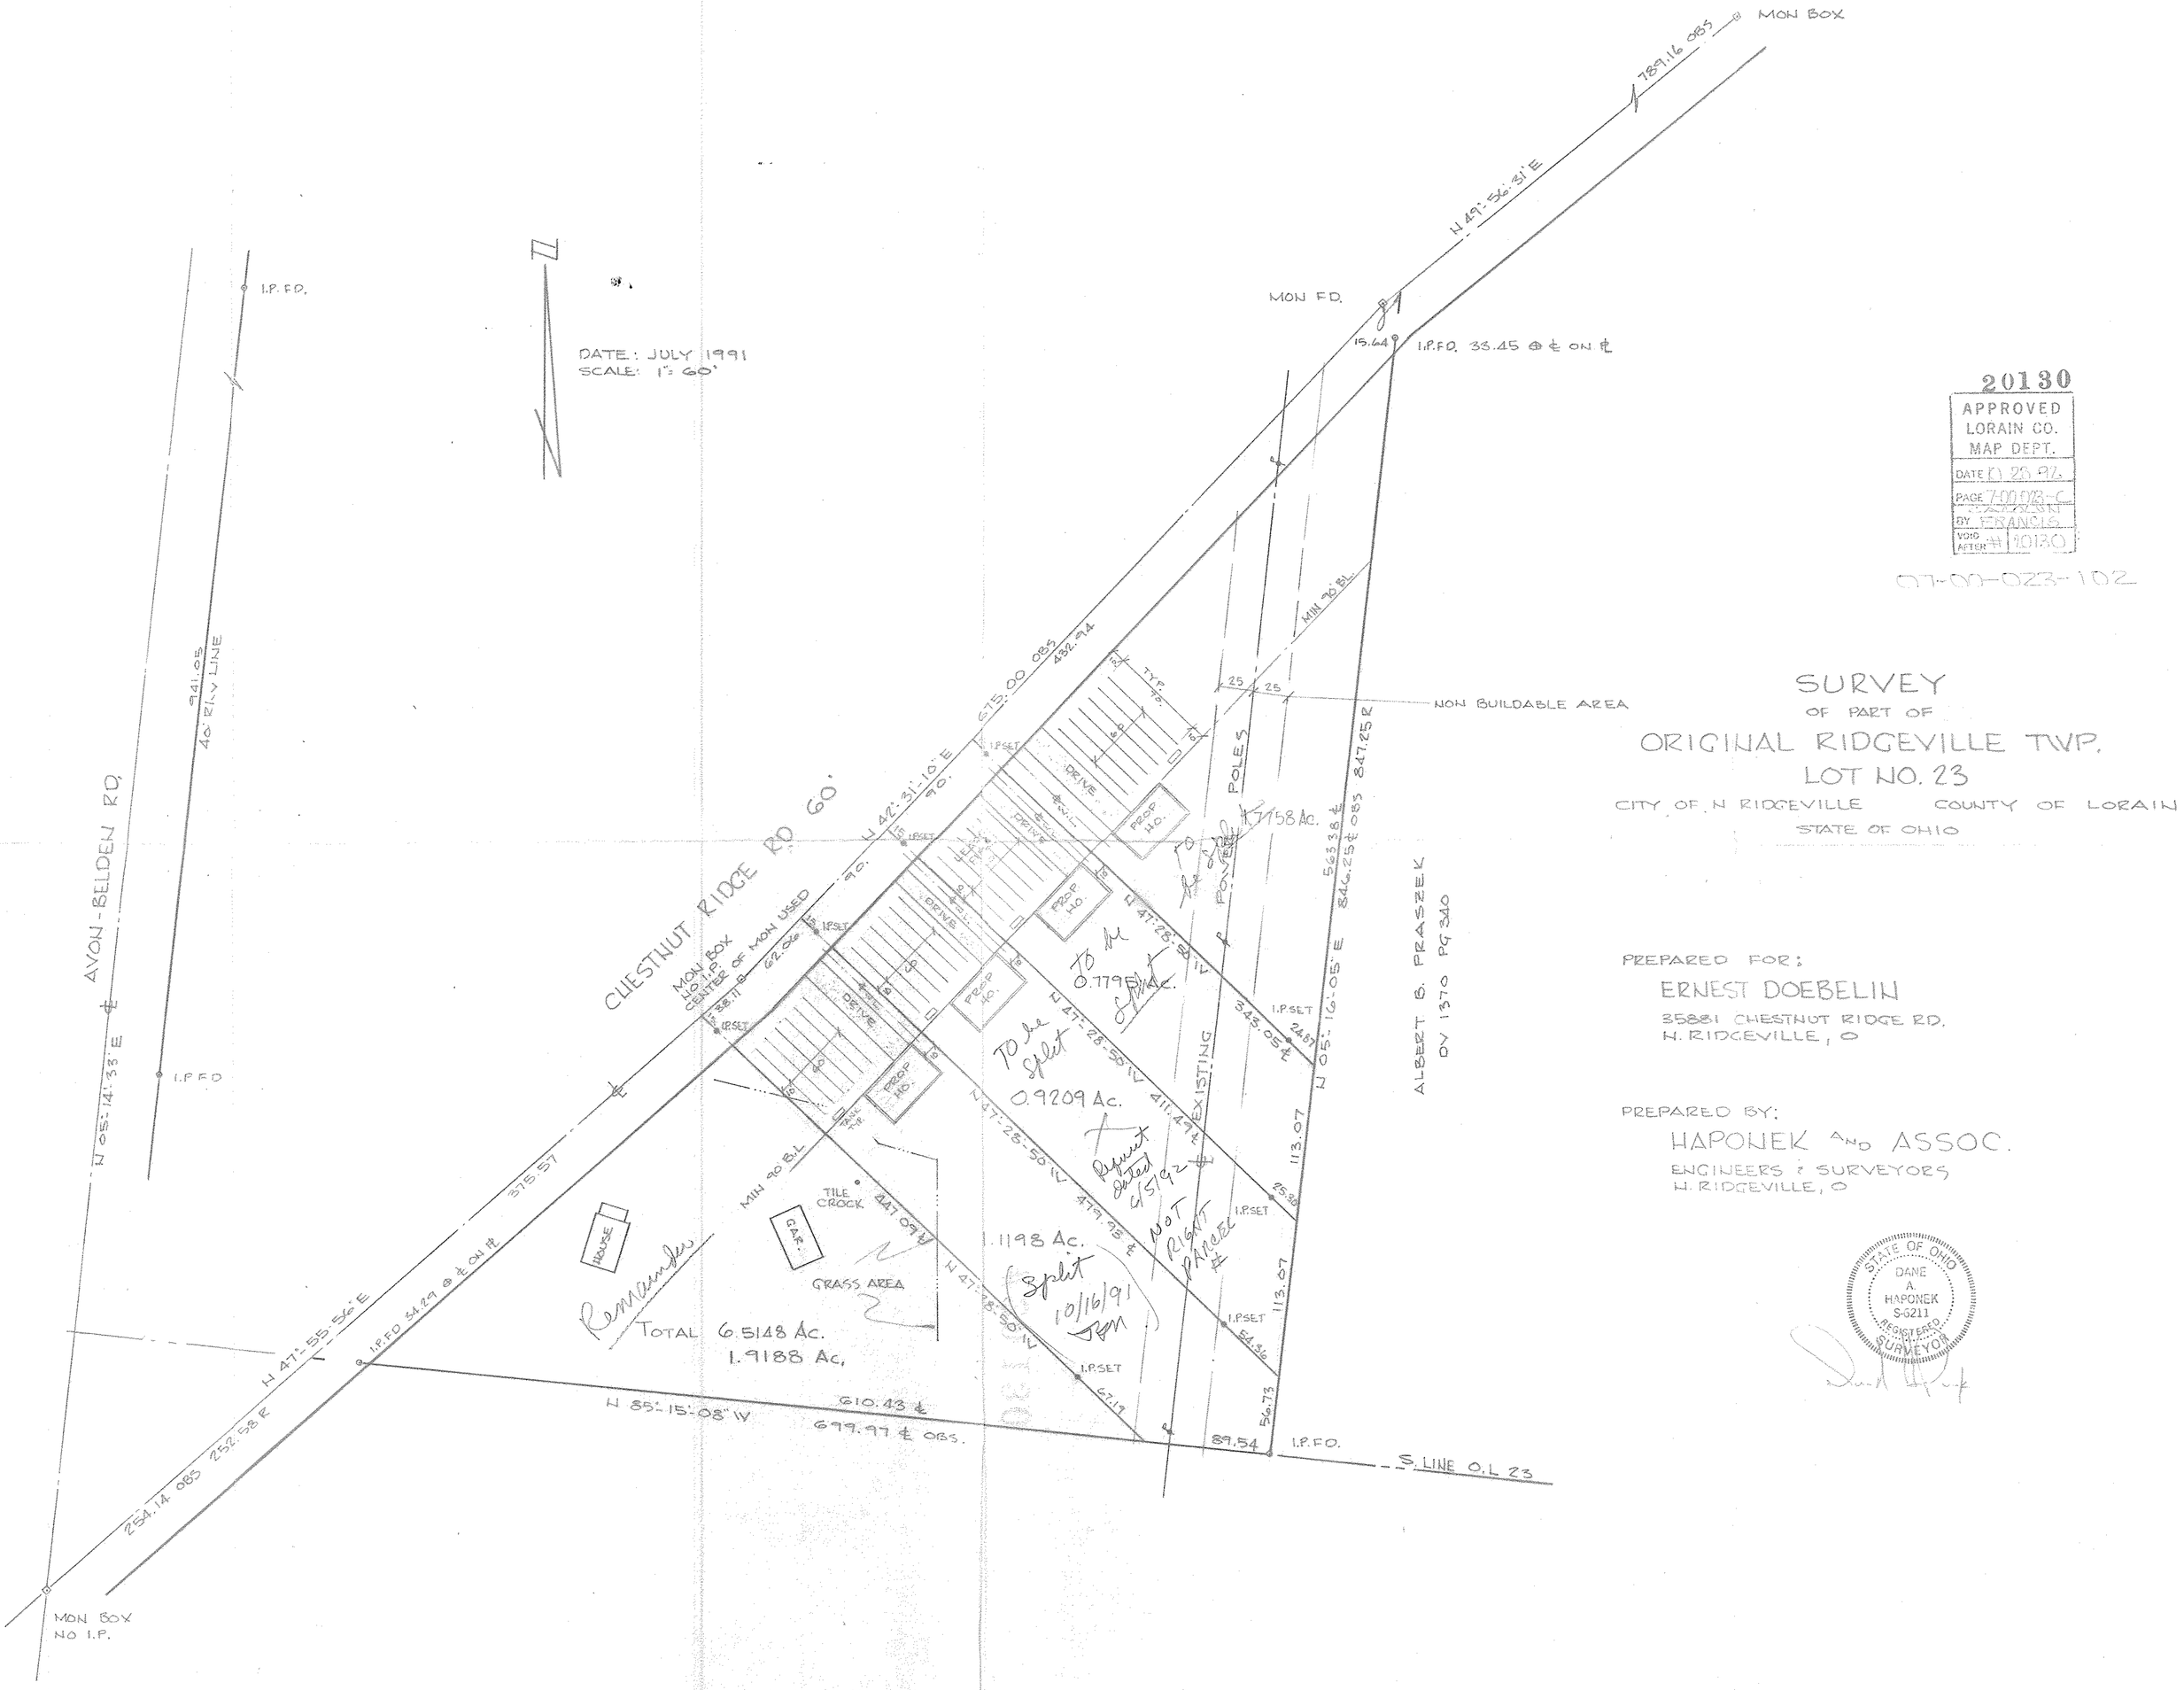

20130
APPROVED
LORAIN CO.
MAP DEPT.
DATE 10 28 92
PAGE 7-00 023-C
BY E.FRANCIS
VOID AFTER 10130

07-00-023-102

SURVEY
OF PART OF
ORIGINAL RIDGEVILLE TWP.
LOT NO. 23

CITY OF N. RIDGEVILLE COUNTY OF LORAIN
STATE OF OHIO

PREPARED FOR:
ERNEST DOEBELIN
35881 CHESTNUT RIDGE RD.
N. RIDGEVILLE, O

PREPARED BY:
HAPONEK AND ASSOC.
ENGINEERS & SURVEYORS
N. RIDGEVILLE, O

STATE OF OHIO
DANE A. HAPONEK
S-6211
REGISTERED SURVEYOR