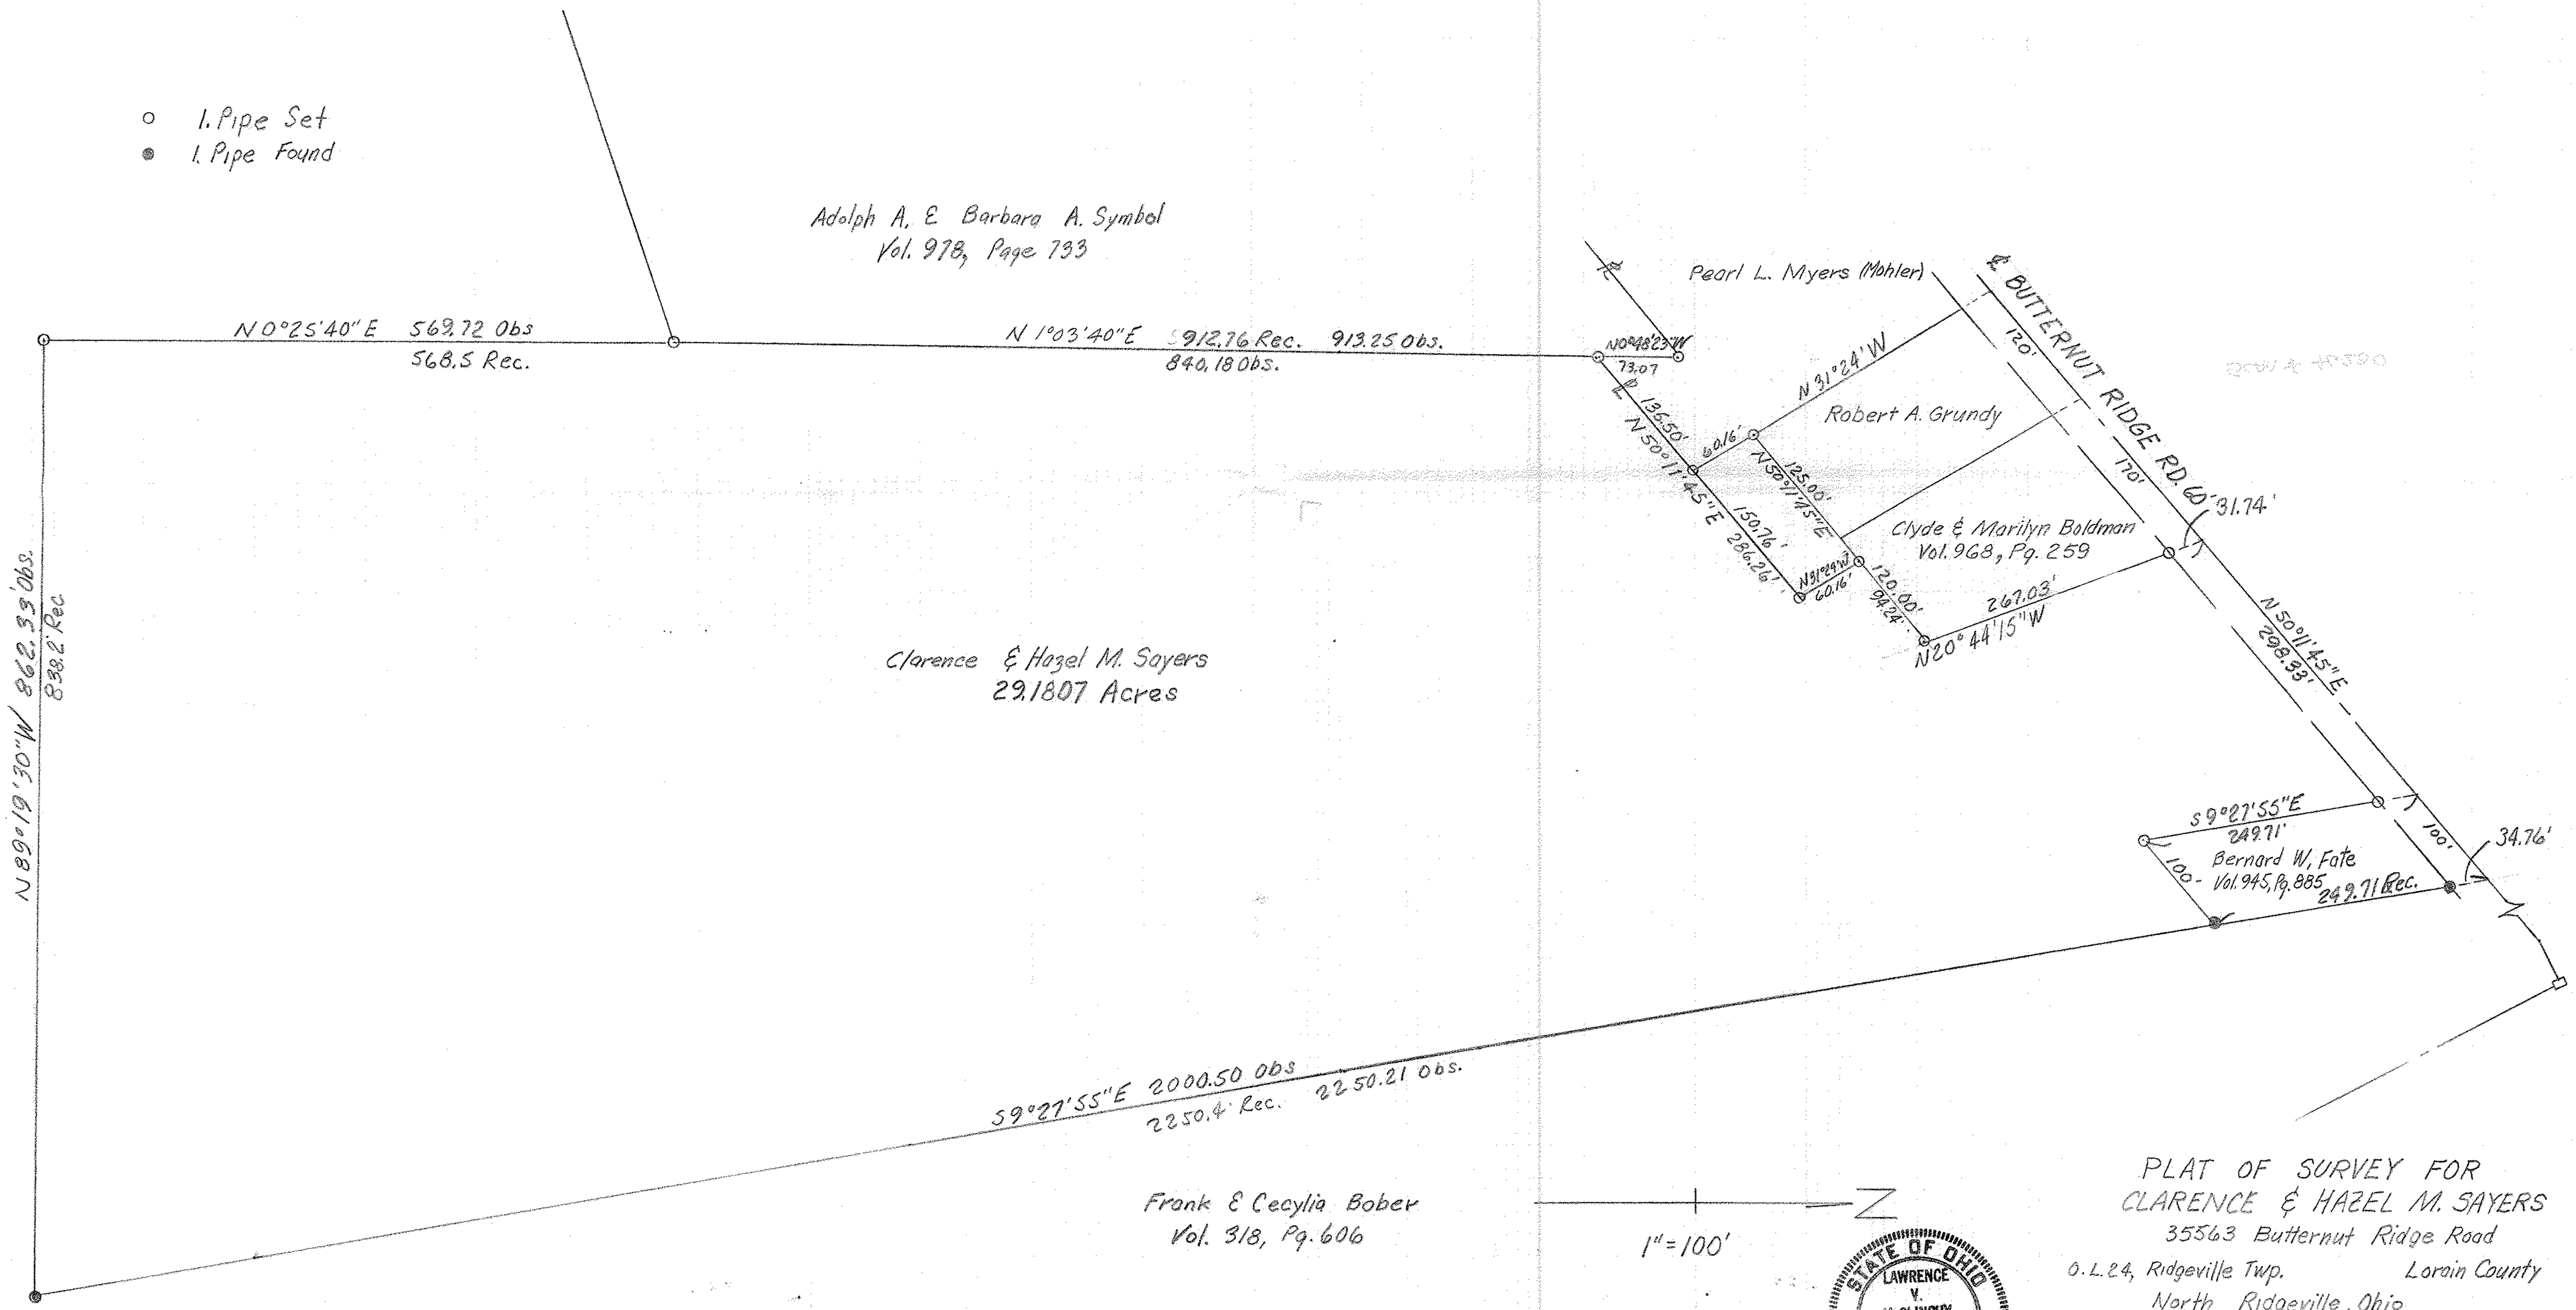

STATE OF OHIO
LAWRENCE V. McGLINCHY
4970
REGISTERED
SURVEYOR

PLAT OF SURVEY FOR
CLARENCE & HAZEL M. SAYERS
35563 Butternut Ridge Road
O.L. 24, Ridgeville Twp. Lorain County
North Ridgeville, Ohio

McGLINCHY & ASSOCIATES
Professional Engineers & Surveyors
538 West Broad Street Elyria, Ohio
Job. No 74147
May, 1975
Rev July, 1975