07-00-026-108-055

07-00-026-D

SCAN # 46240

SURVEY FOR

FRIEDA & THEODORE TOTH

SubLots 212-213-214-215-264-265

HOME CREST PARK SUBDIVISION

O.L. 26 RIDGEVILLE TWP. LORAIN COUNTY OHIO
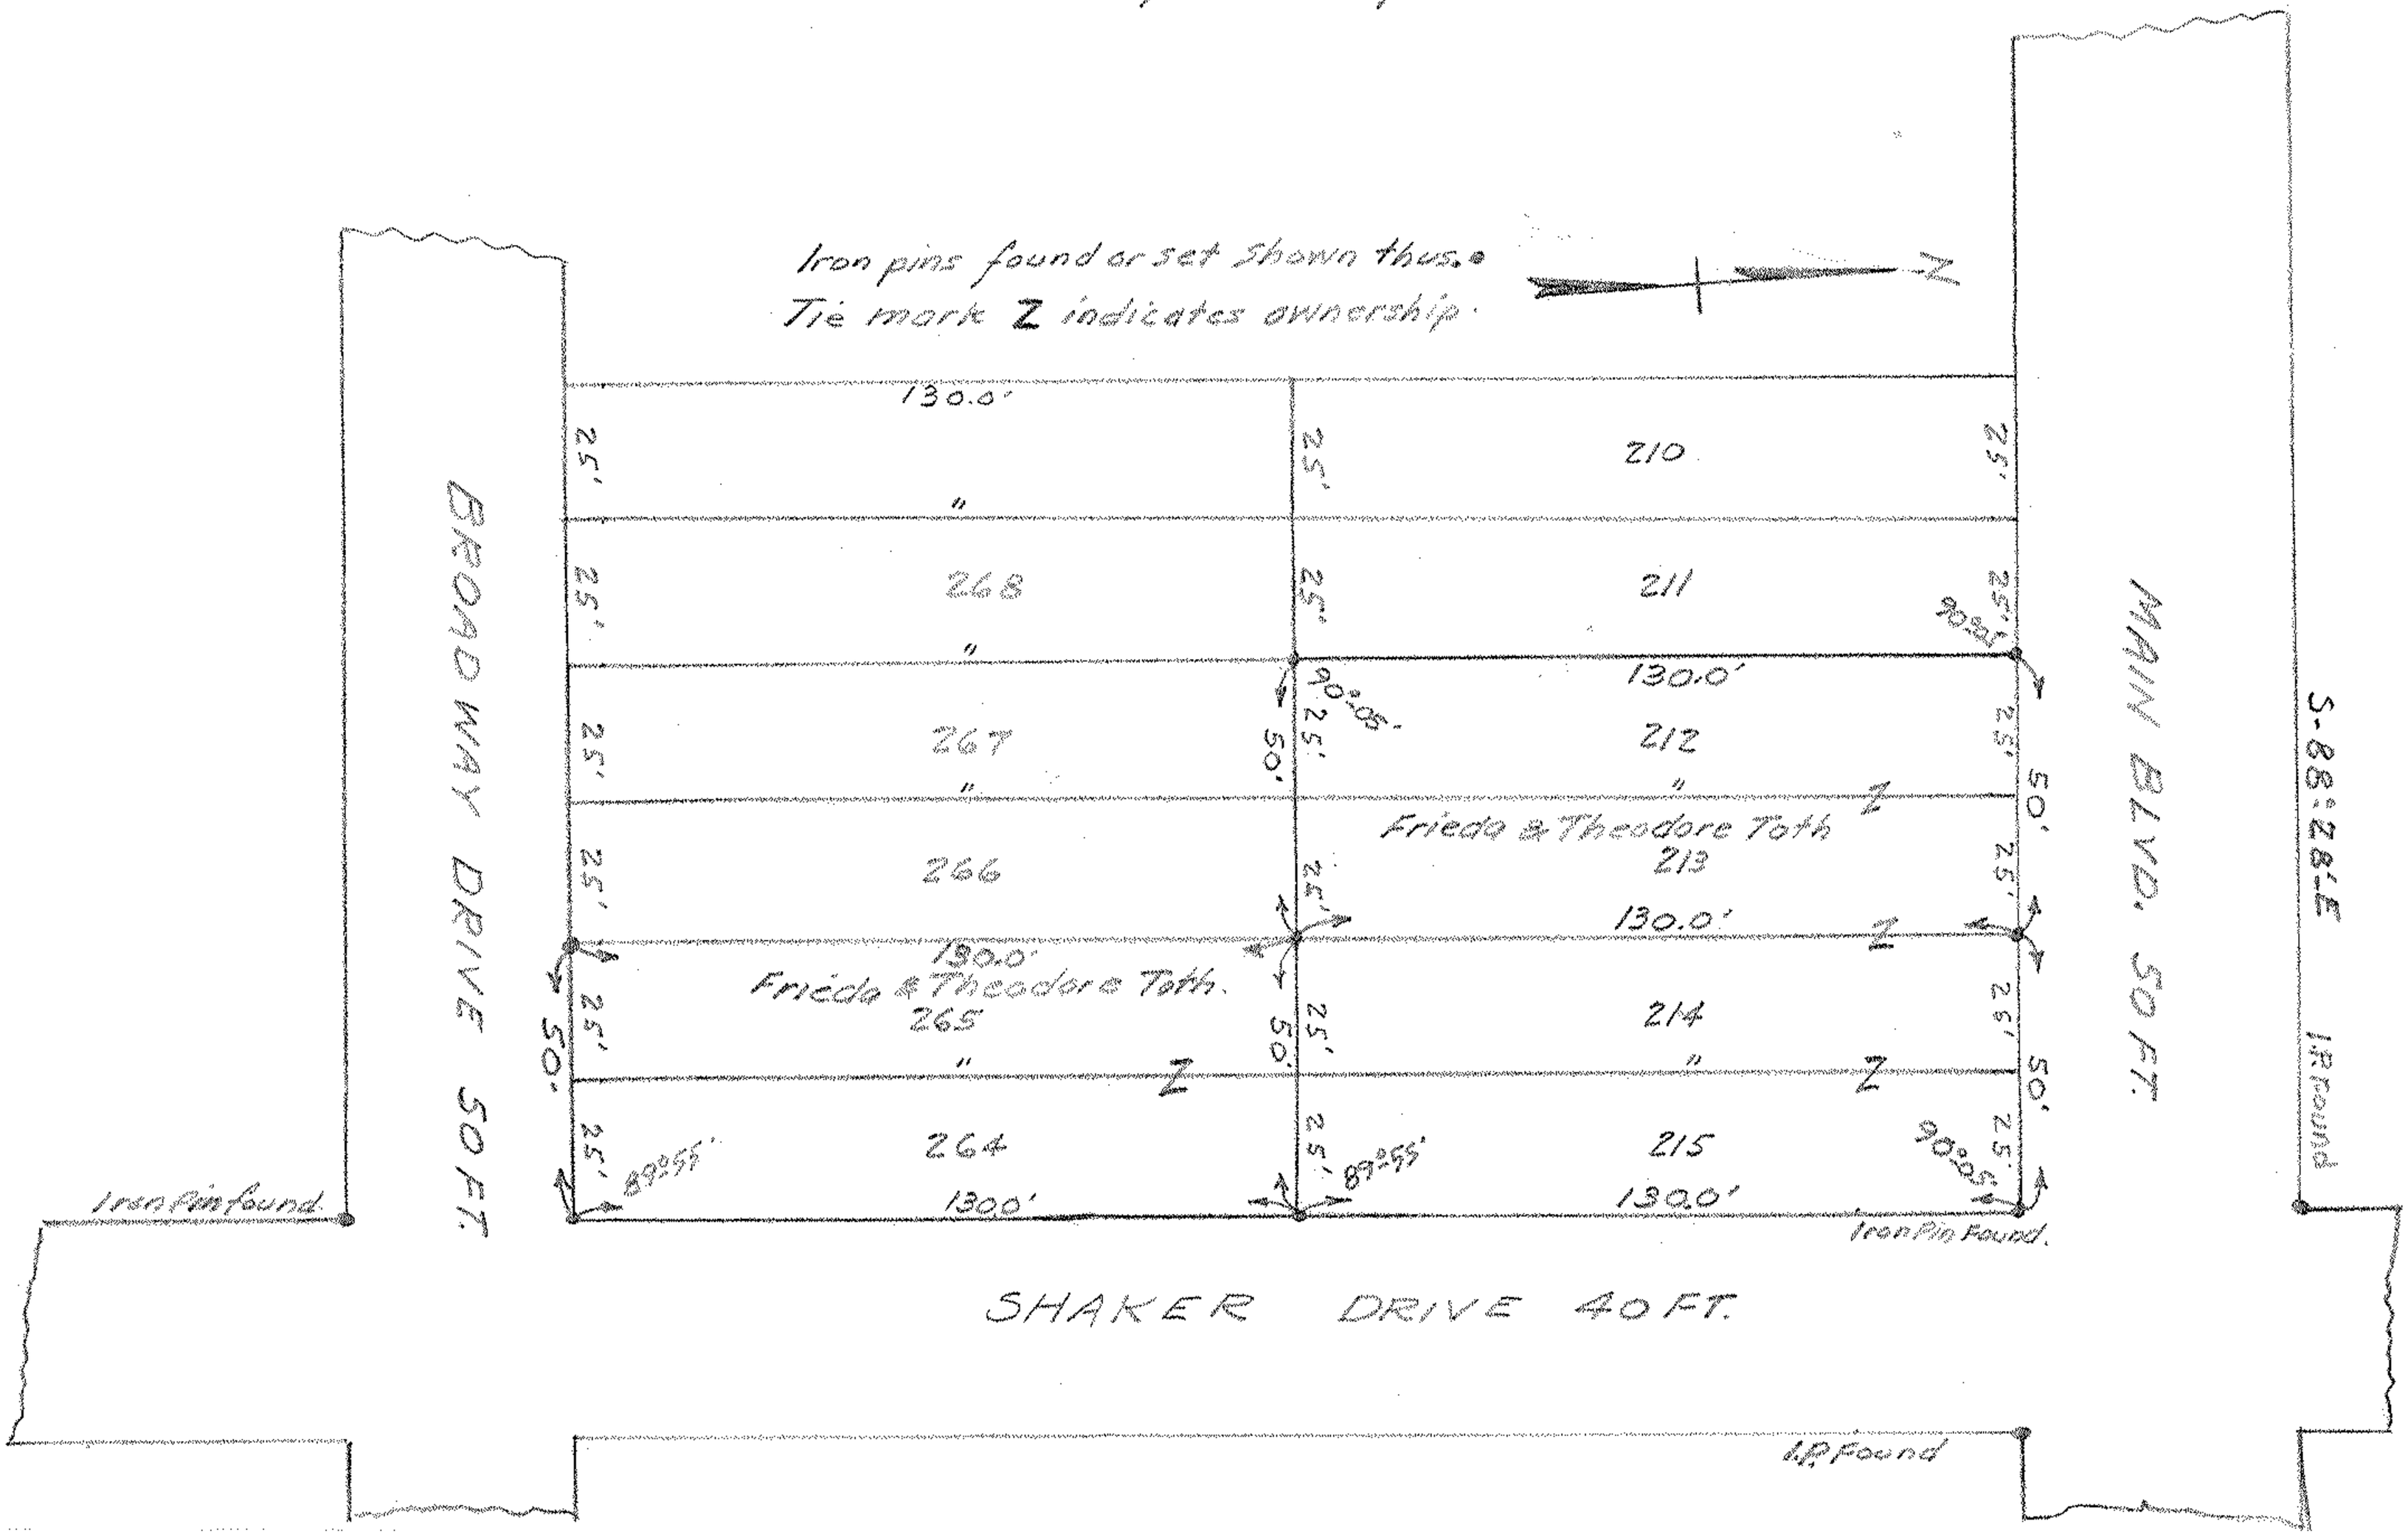
C.E. Penfound Registered Surveyor.