07-00-028-101-092
07-00-028-C

MAP OF PART OF ORIGINAL LOT 28
RIDGEVILLE TWP. NORTH RIDGEVILLE VILLAGE
LORAIN COUNTY OHIO
SCALE: 1" = 40' JULY 16-1959 3:30 P.M.
GARY E. PENFOUND REG. SURVEYOR NO. 4457
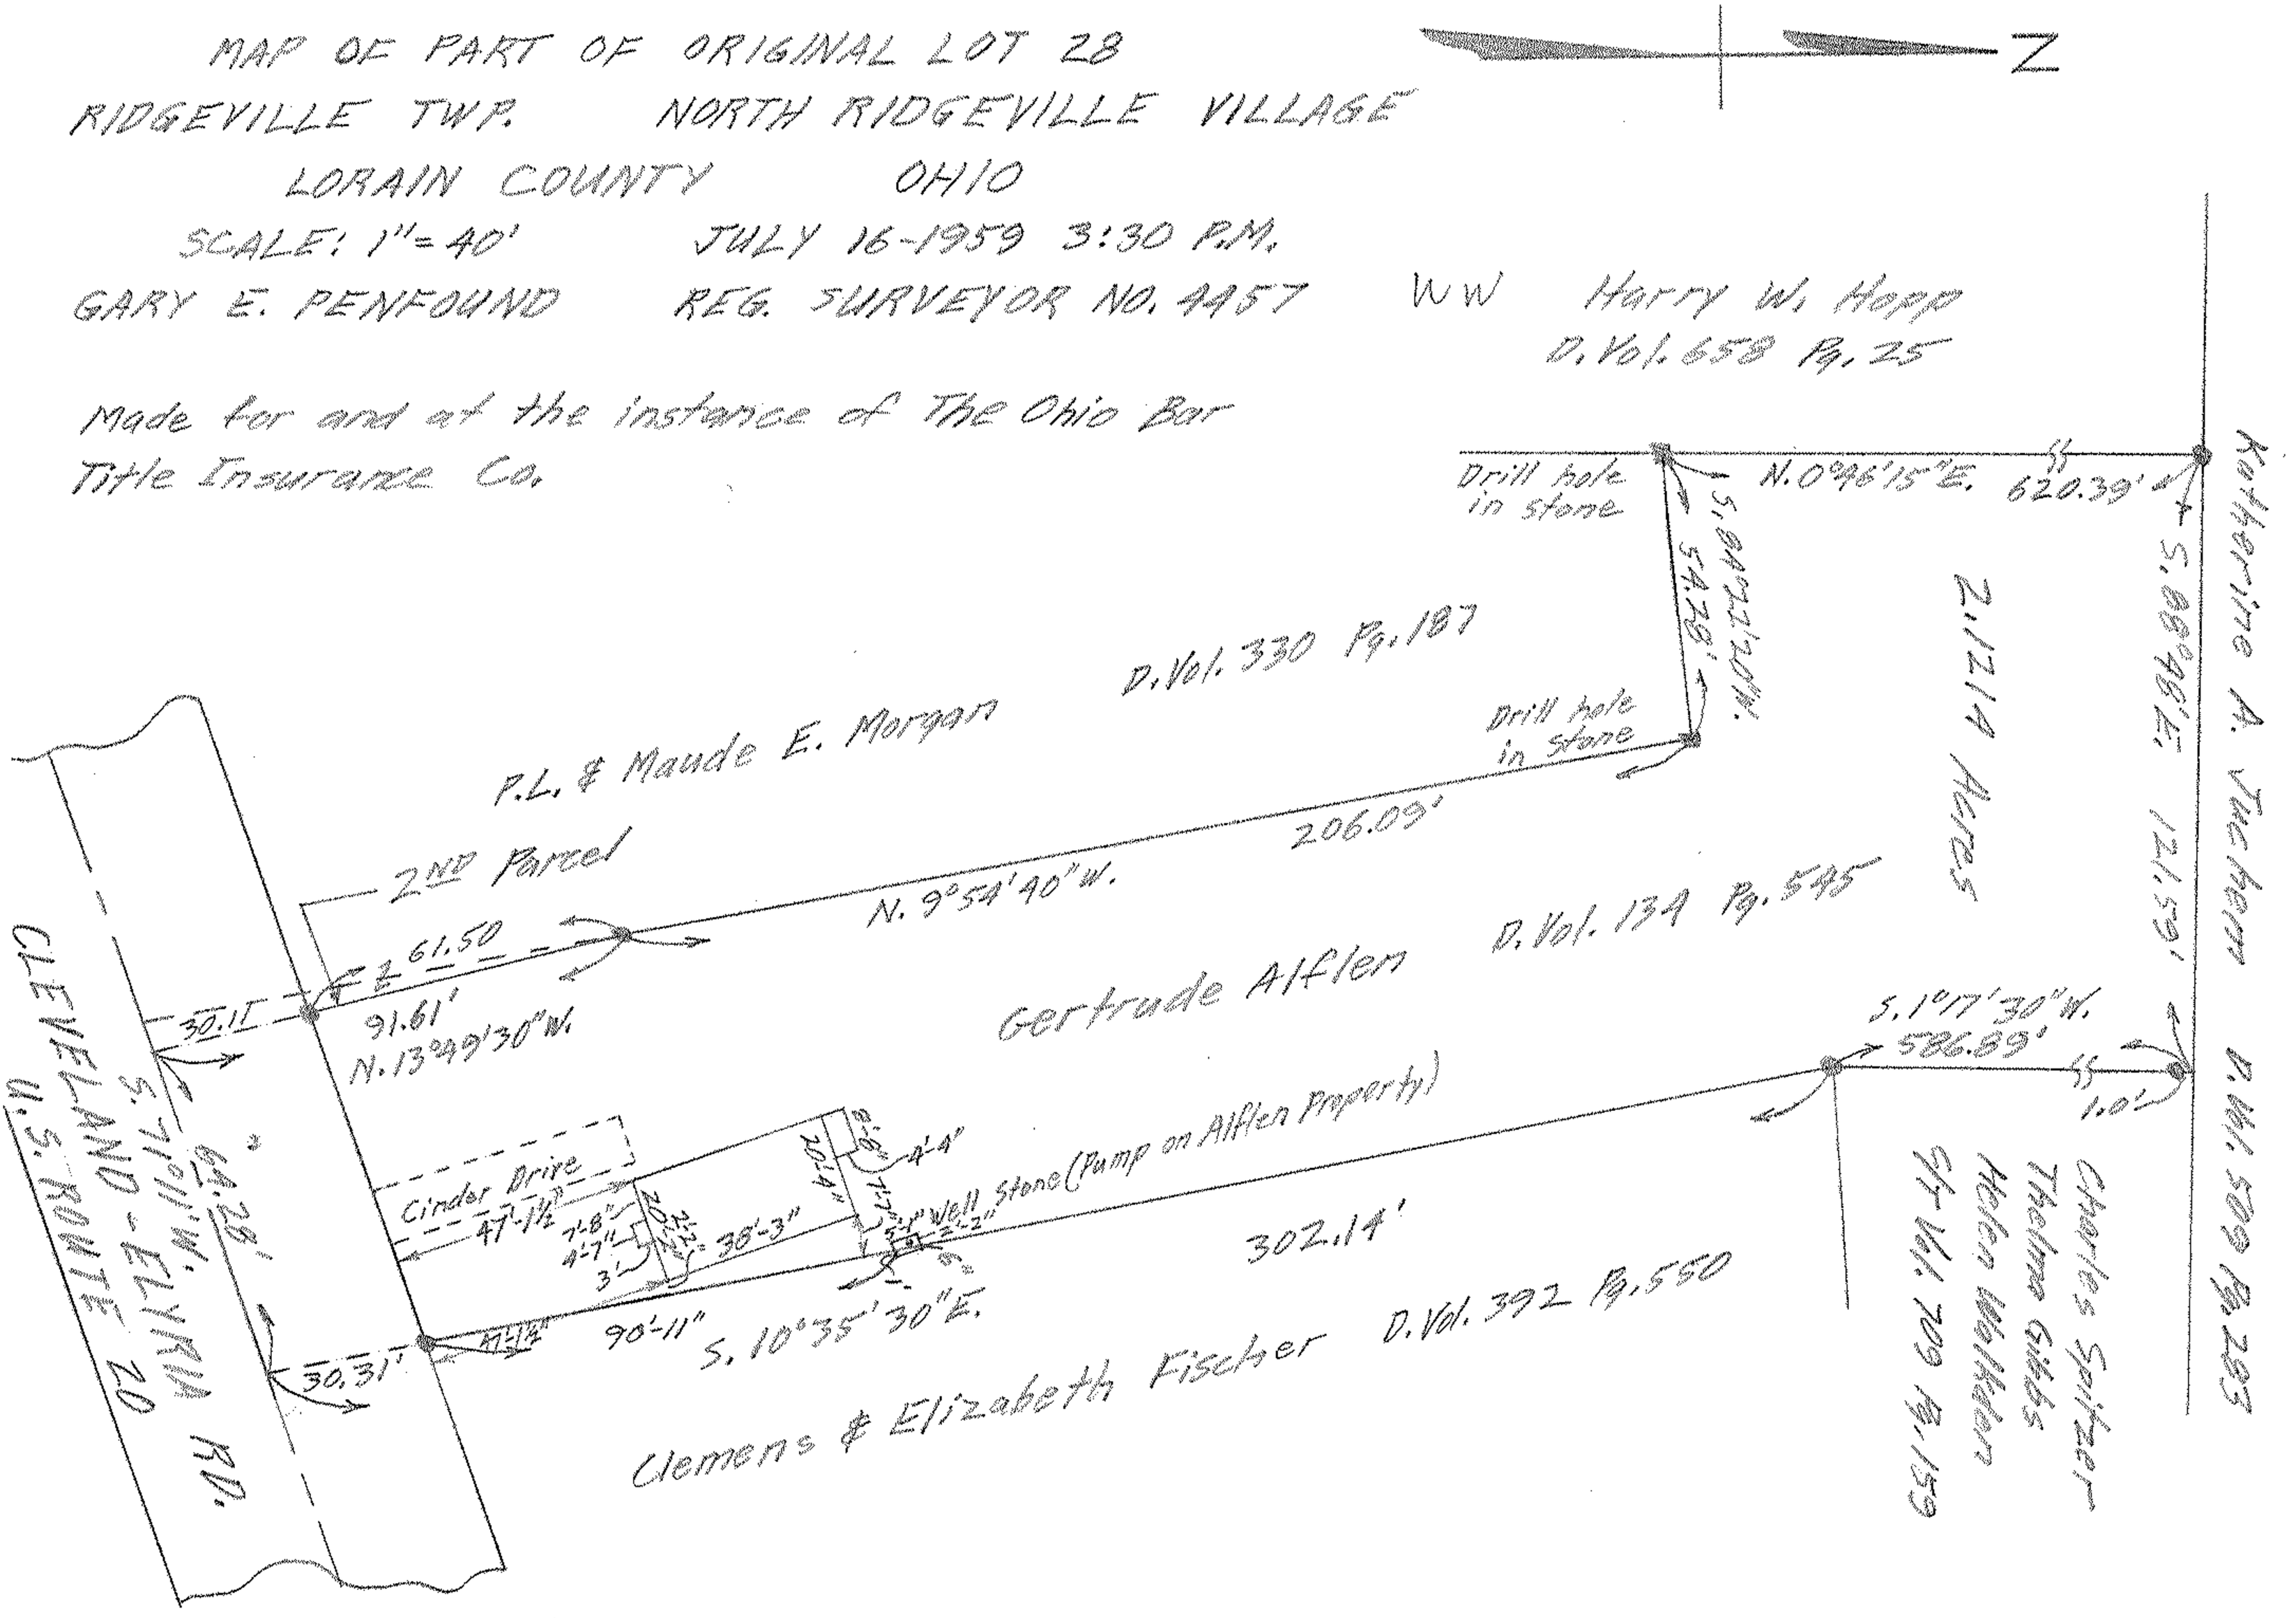
Made for and at the instance of The Ohio Bar Title Insurance Co.