


7-00-029-D

07-00-029-000

#



EDWARD C. & ALBERTA WYSOCKI
Feb. 8, 1943 V. 336 P. 233

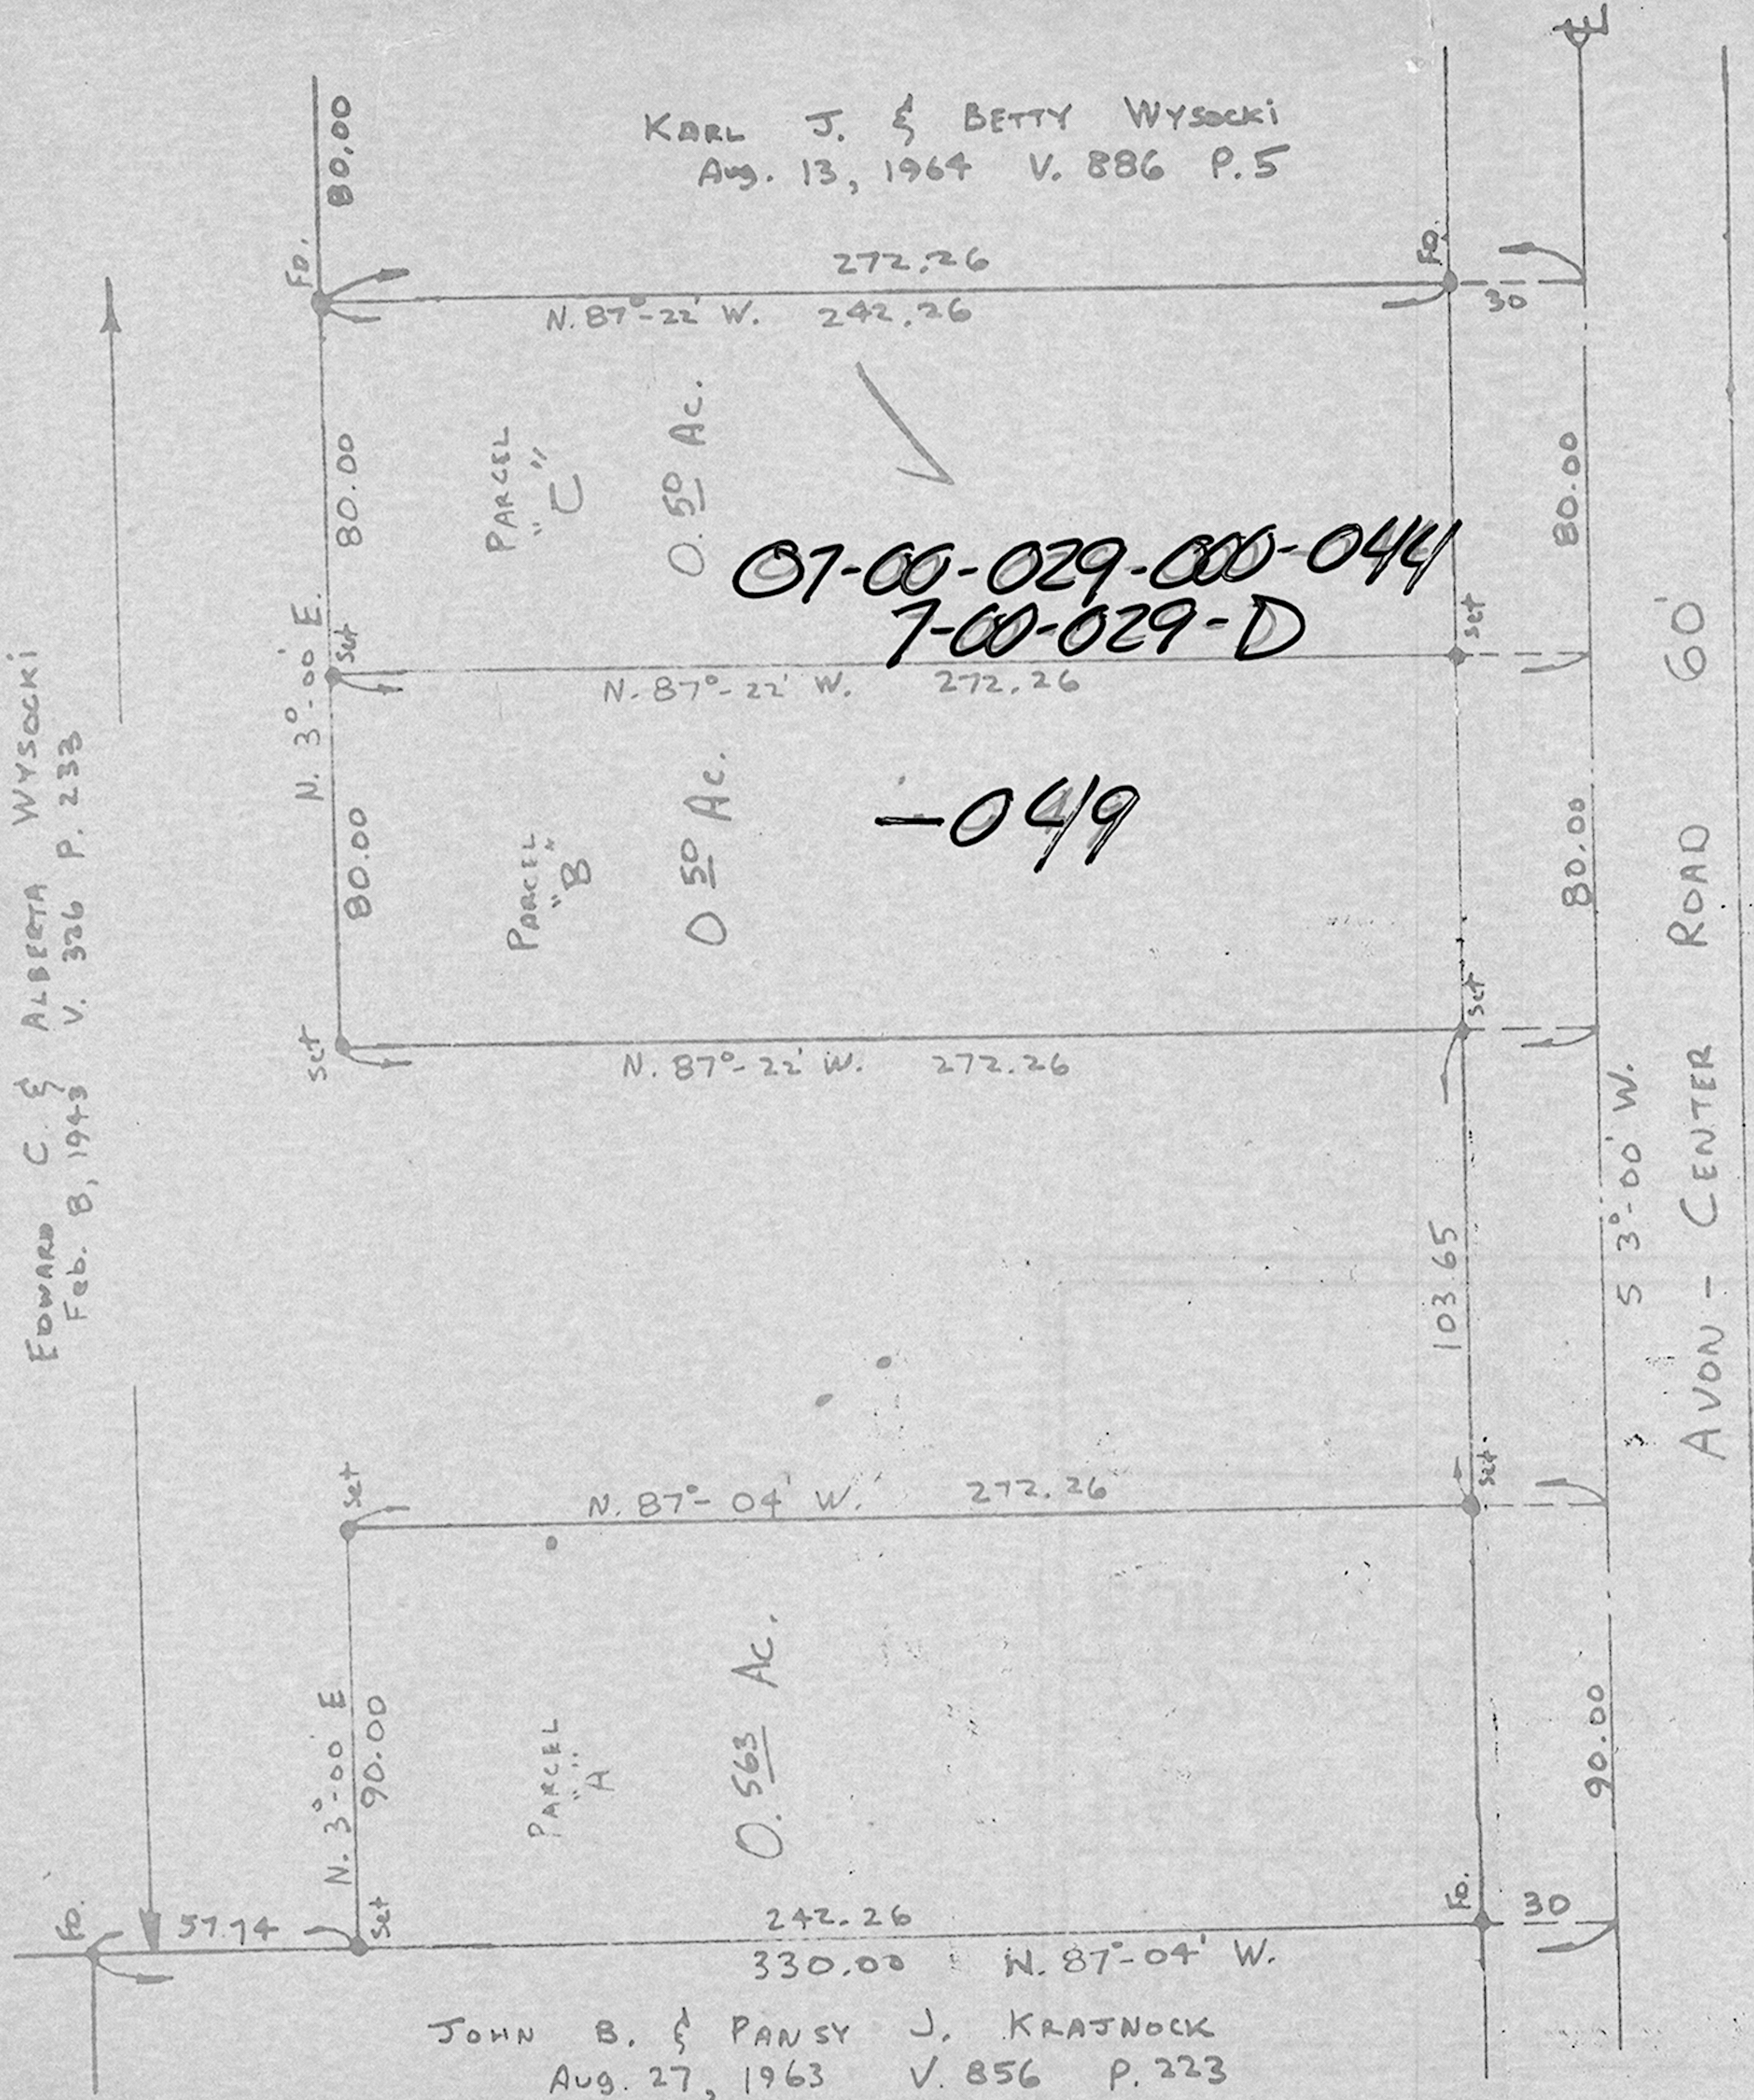

KARL J. & BETTY WYSOCKI
Aug. 13, 1964 V. 886 P. 5

JOHN B. & PANSY J. KRATNOCK
Aug. 27, 1963 V. 856 P. 223

Survey of land in O.L. 29, Ridgeville
Twp., Lorain County, Ohio, now in
the City of North Ridgeville.

Scale 1" = 60'
Charles F. Jacobs - Reg. Surveyor # 4779
March 24, 1965

07-00-029-000-044-019

7-00-029