LOCATION SURVEY

OF PART OF

ORIGINAL RIDGEVILLE TWP. LOTS 31

CITY OF N. RIDGEVILLE COUNTY OF LORAIN

STATE OF OHIO

DATE: SEPT 1994

SCALE: 1" = 40'

PREPARED BY:

HAPONEK AND ASSOC.

SURVEYORS AND ENGINEERS

N. RIDGEVILLE, OH.

STATE OF OHIO
DANE A. HAPONEK
S-6211
REGISTERED SURVEYOR

PREPARED FOR:

DETTORE FARMS

N. RIDGEVILLE, OH.

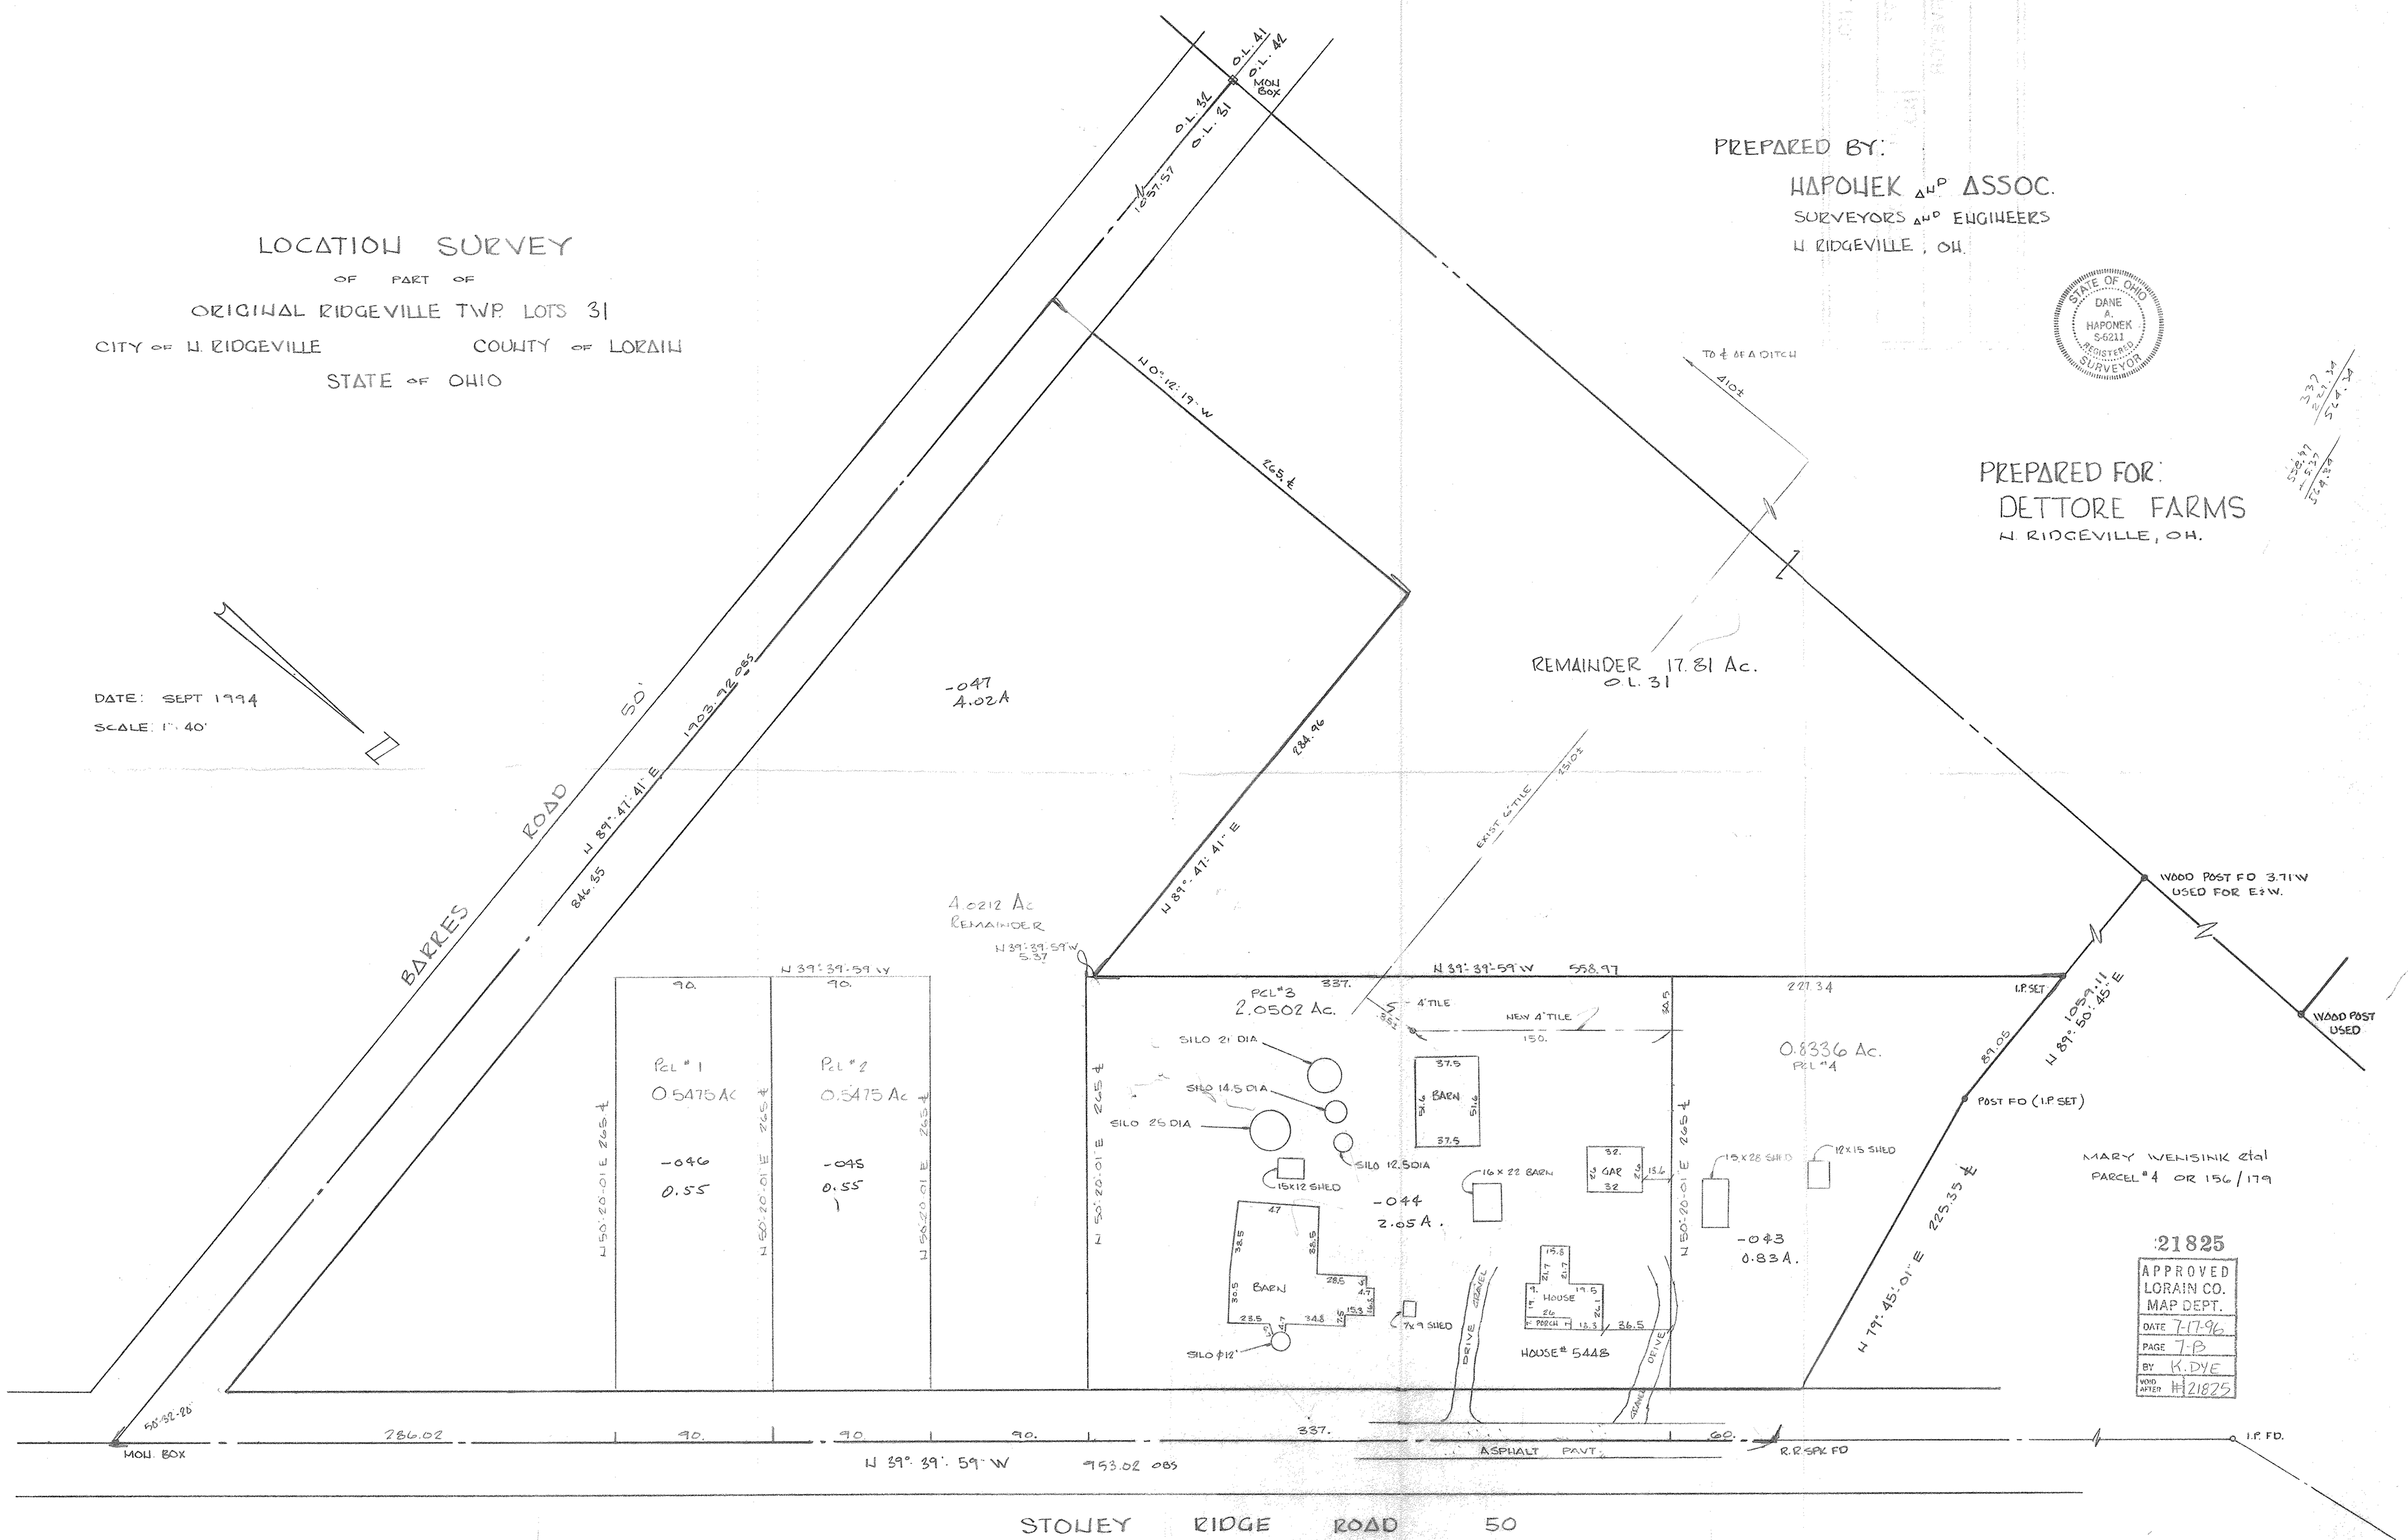

21825

APPROVED
LORAIN CO.
MAP DEPT.
DATE 7-17-96
PAGE 7-B
BY K. DYE
VOID AFTER # 21825

REVISED 5-24-96 ADDED SPLITS
REVISED 3-24-96 ADDED SPLITS

94-45