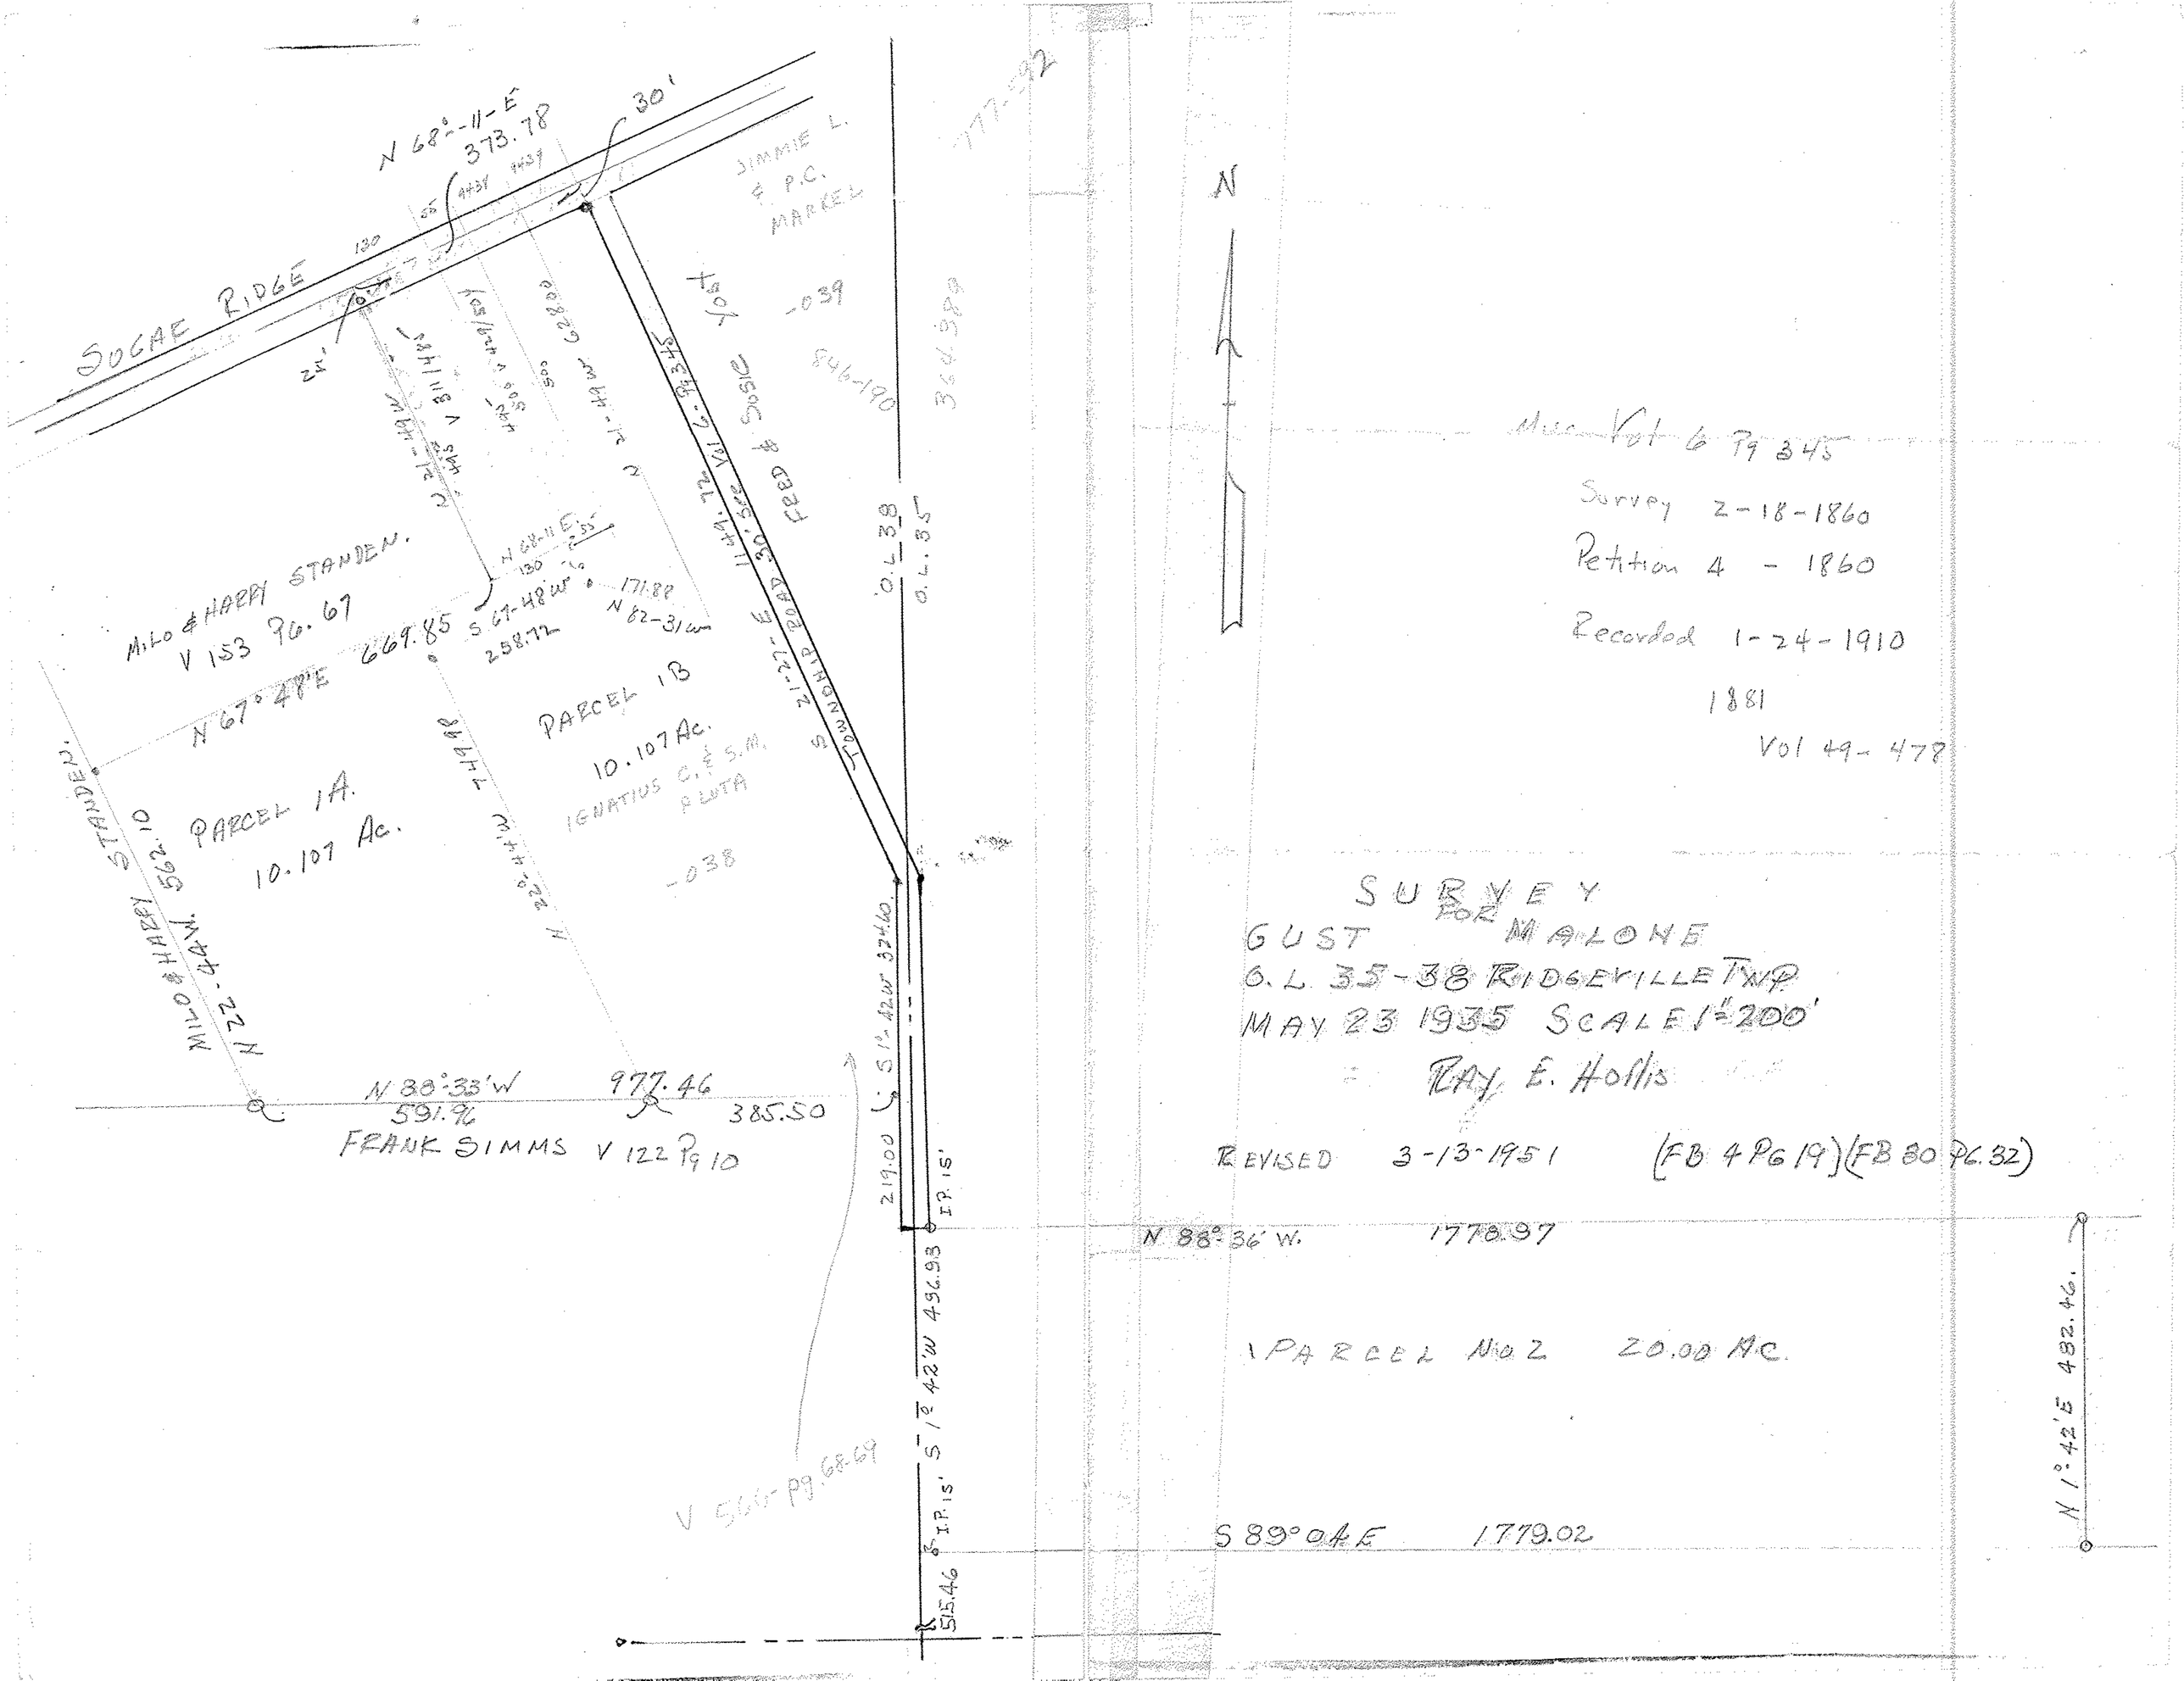

SUGAR RIDGE
N 68°-11-E
373.78
30'
JIMMIE L. & P.C. MARKEL
-039
846-190
364.389
777-592
FRED & SUSIE Yost
S 21-27-E 11 49.72 Vol 6 Pg 345
TOWNSHIP ROAD 30' See
O.L. 38
O.L. 35
MILO & HARRY STANDEN.
V 153 Pg. 67
N 67° 48'E 669.85
S 67-48W 258.72
171.88
N 82-31W
PARCEL 1B
10.107 Ac.
IGNATIUS C. & S.M. PLUTA
-038
PARCEL 1A.
10.107 Ac.
MILO & HARRY STANDEN.
N 22-44W 562.10
N 22°-44'W 749.98
N 88°-33'W
591.96
977.46
385.50
FRANK SIMMS V 122 Pg 10
S 1°-42W 324.60
219.00
I.P. 15'
S 1° 42'W 496.93
I.P. 15'
515.46
V 566 Pg 68-69
N
Misc Vol 6 Pg 345
Survey 2-18-1860
Petition 4 - 1860
Recorded 1-24-1910
1881
Vol 49-478
SURVEY FOR MALONE
GUST
O.L. 35-38 RIDGEVILLE TWP
MAY 23 1935 SCALE 1"=200'
RAY E. Hollis
REVISED 3-13-1951 (FB 4 Pg 19)(FB 30 Pg. 32)
N 88°-36' W. 1778.97
PARCEL No 2 20.00 AC.
S 89° 04 E 1779.02
N 1° 42' E 482.46.