DATE: NOV. 1987
SCALE: 1" = 50'

SURVEY
OF PART OF
ORIGINAL RIDGEVILLE TWP.
LOT NO. 43
NOW IN
CITY OF N. RIDGEVILLE COUNTY OF LORAIN
STATE OF OHIO

PREPARED FOR:
DANE A. HAPONEK
2422 EAST 34TH. ST.
LORAIN, OHIO

PREPARED BY:
FOOR AND ASSOC.
ENGINEERS AND SURVEYORS
N. RIDGEVILLE, O

STATE OF OHIO JAMES R. FOOR REGISTERED SURVEYOR

JAMES R. FOOR NO. 5876

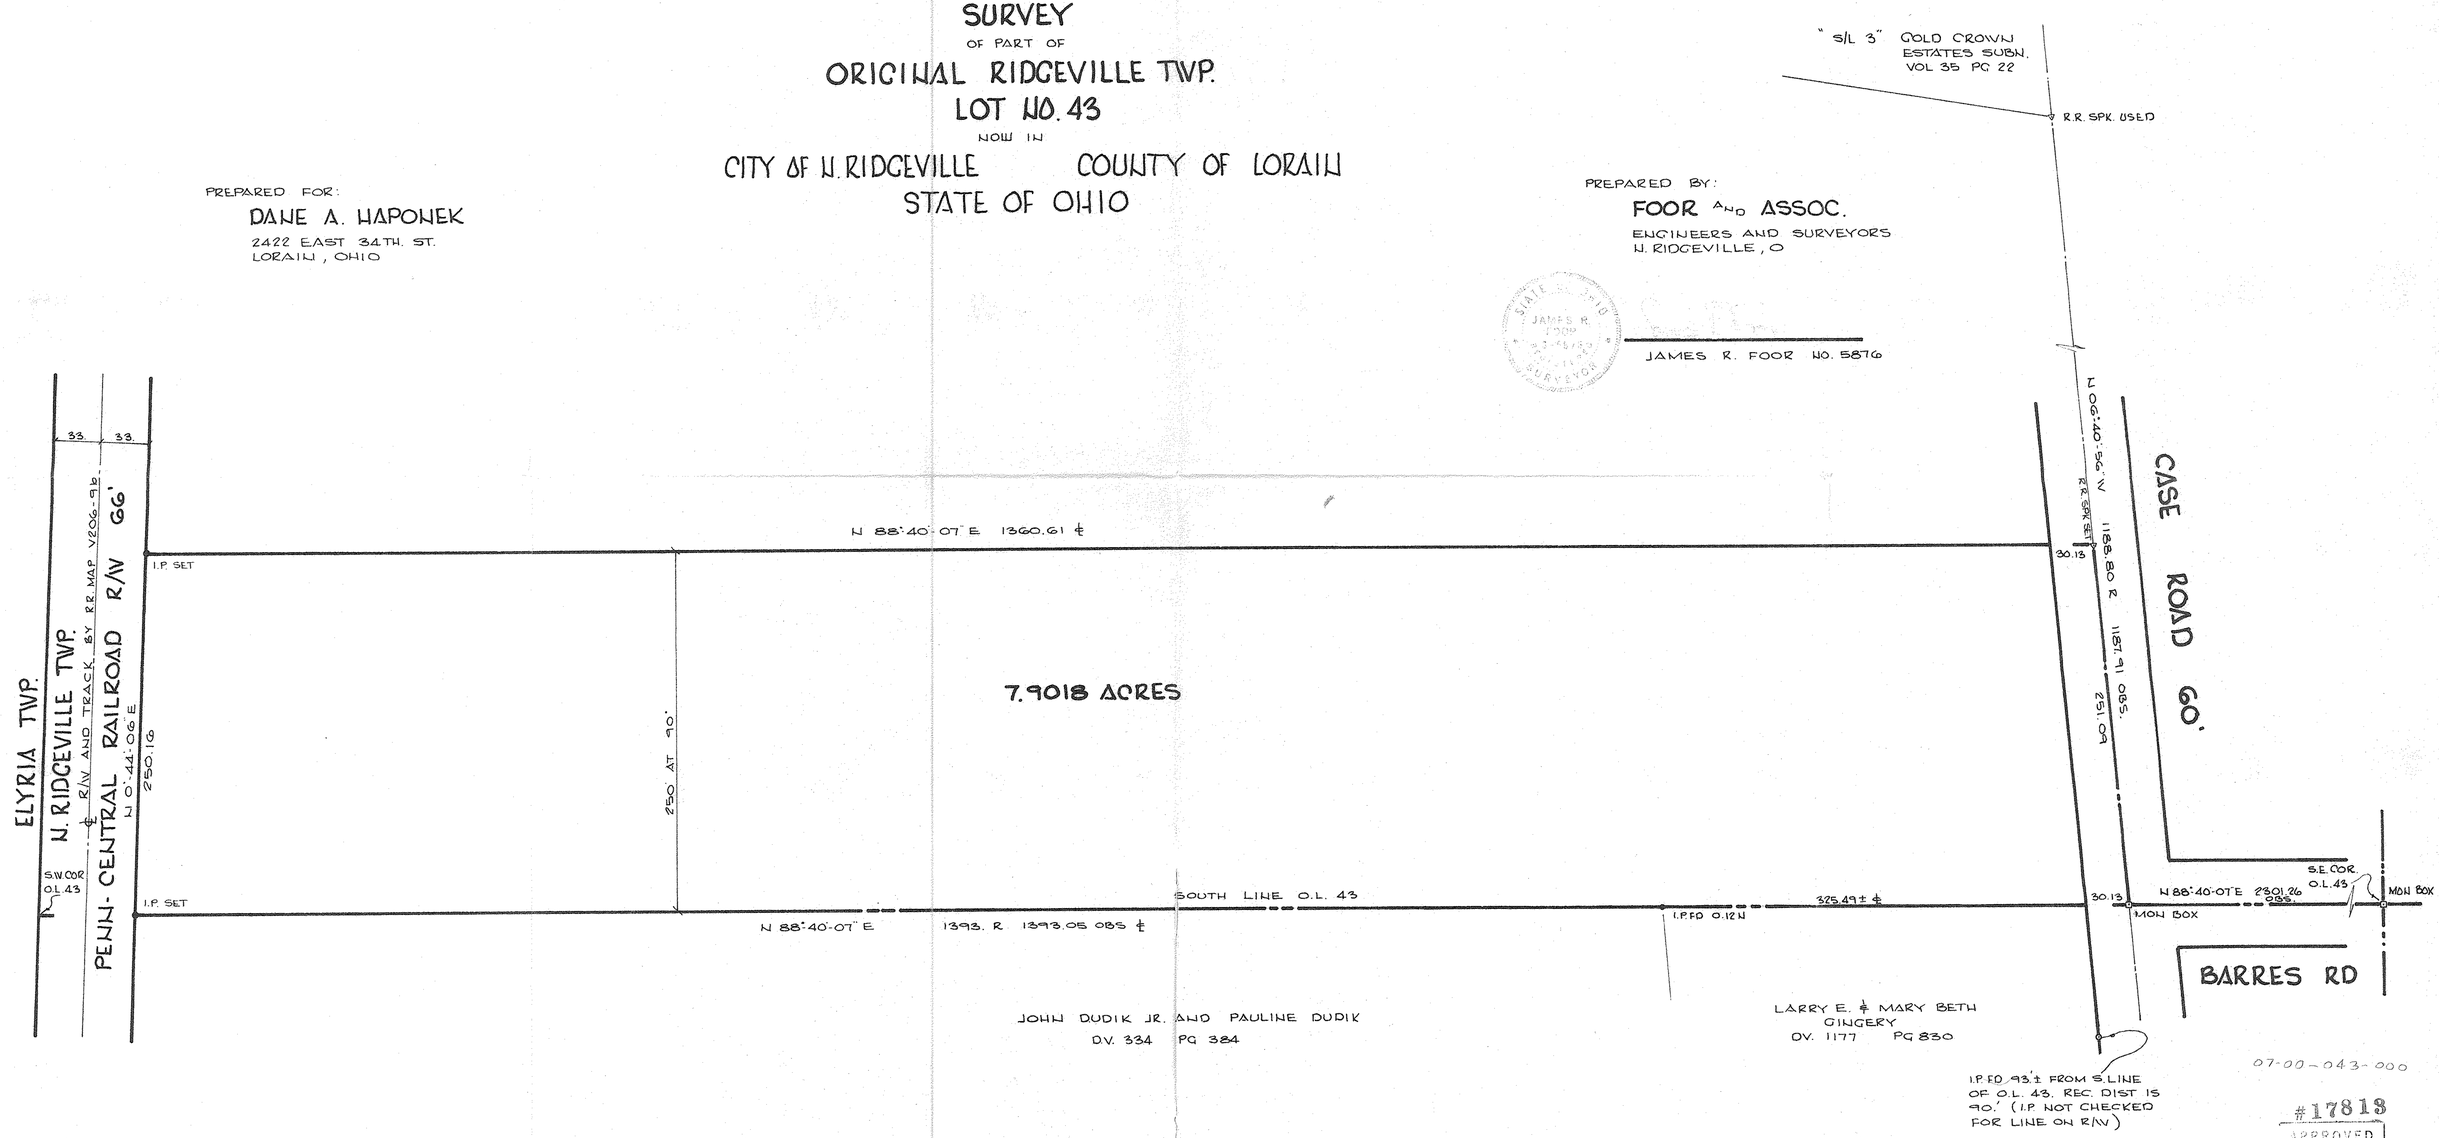

07-00-043-000

#17813
APPROVED
LORAIN CO.
MAP DEPT.
DATE 1-6-88
PARCEL 7-00-043-000
BY C. Francis
VOID AFTER 17813

78-136-2