


07-00-046-107-001, 003, 010
 11894 AUCS SCAN# 46311
 07-00-046-B

07-00-046-107-001, 003, 010
 11894 AUCS SCAN# 46311

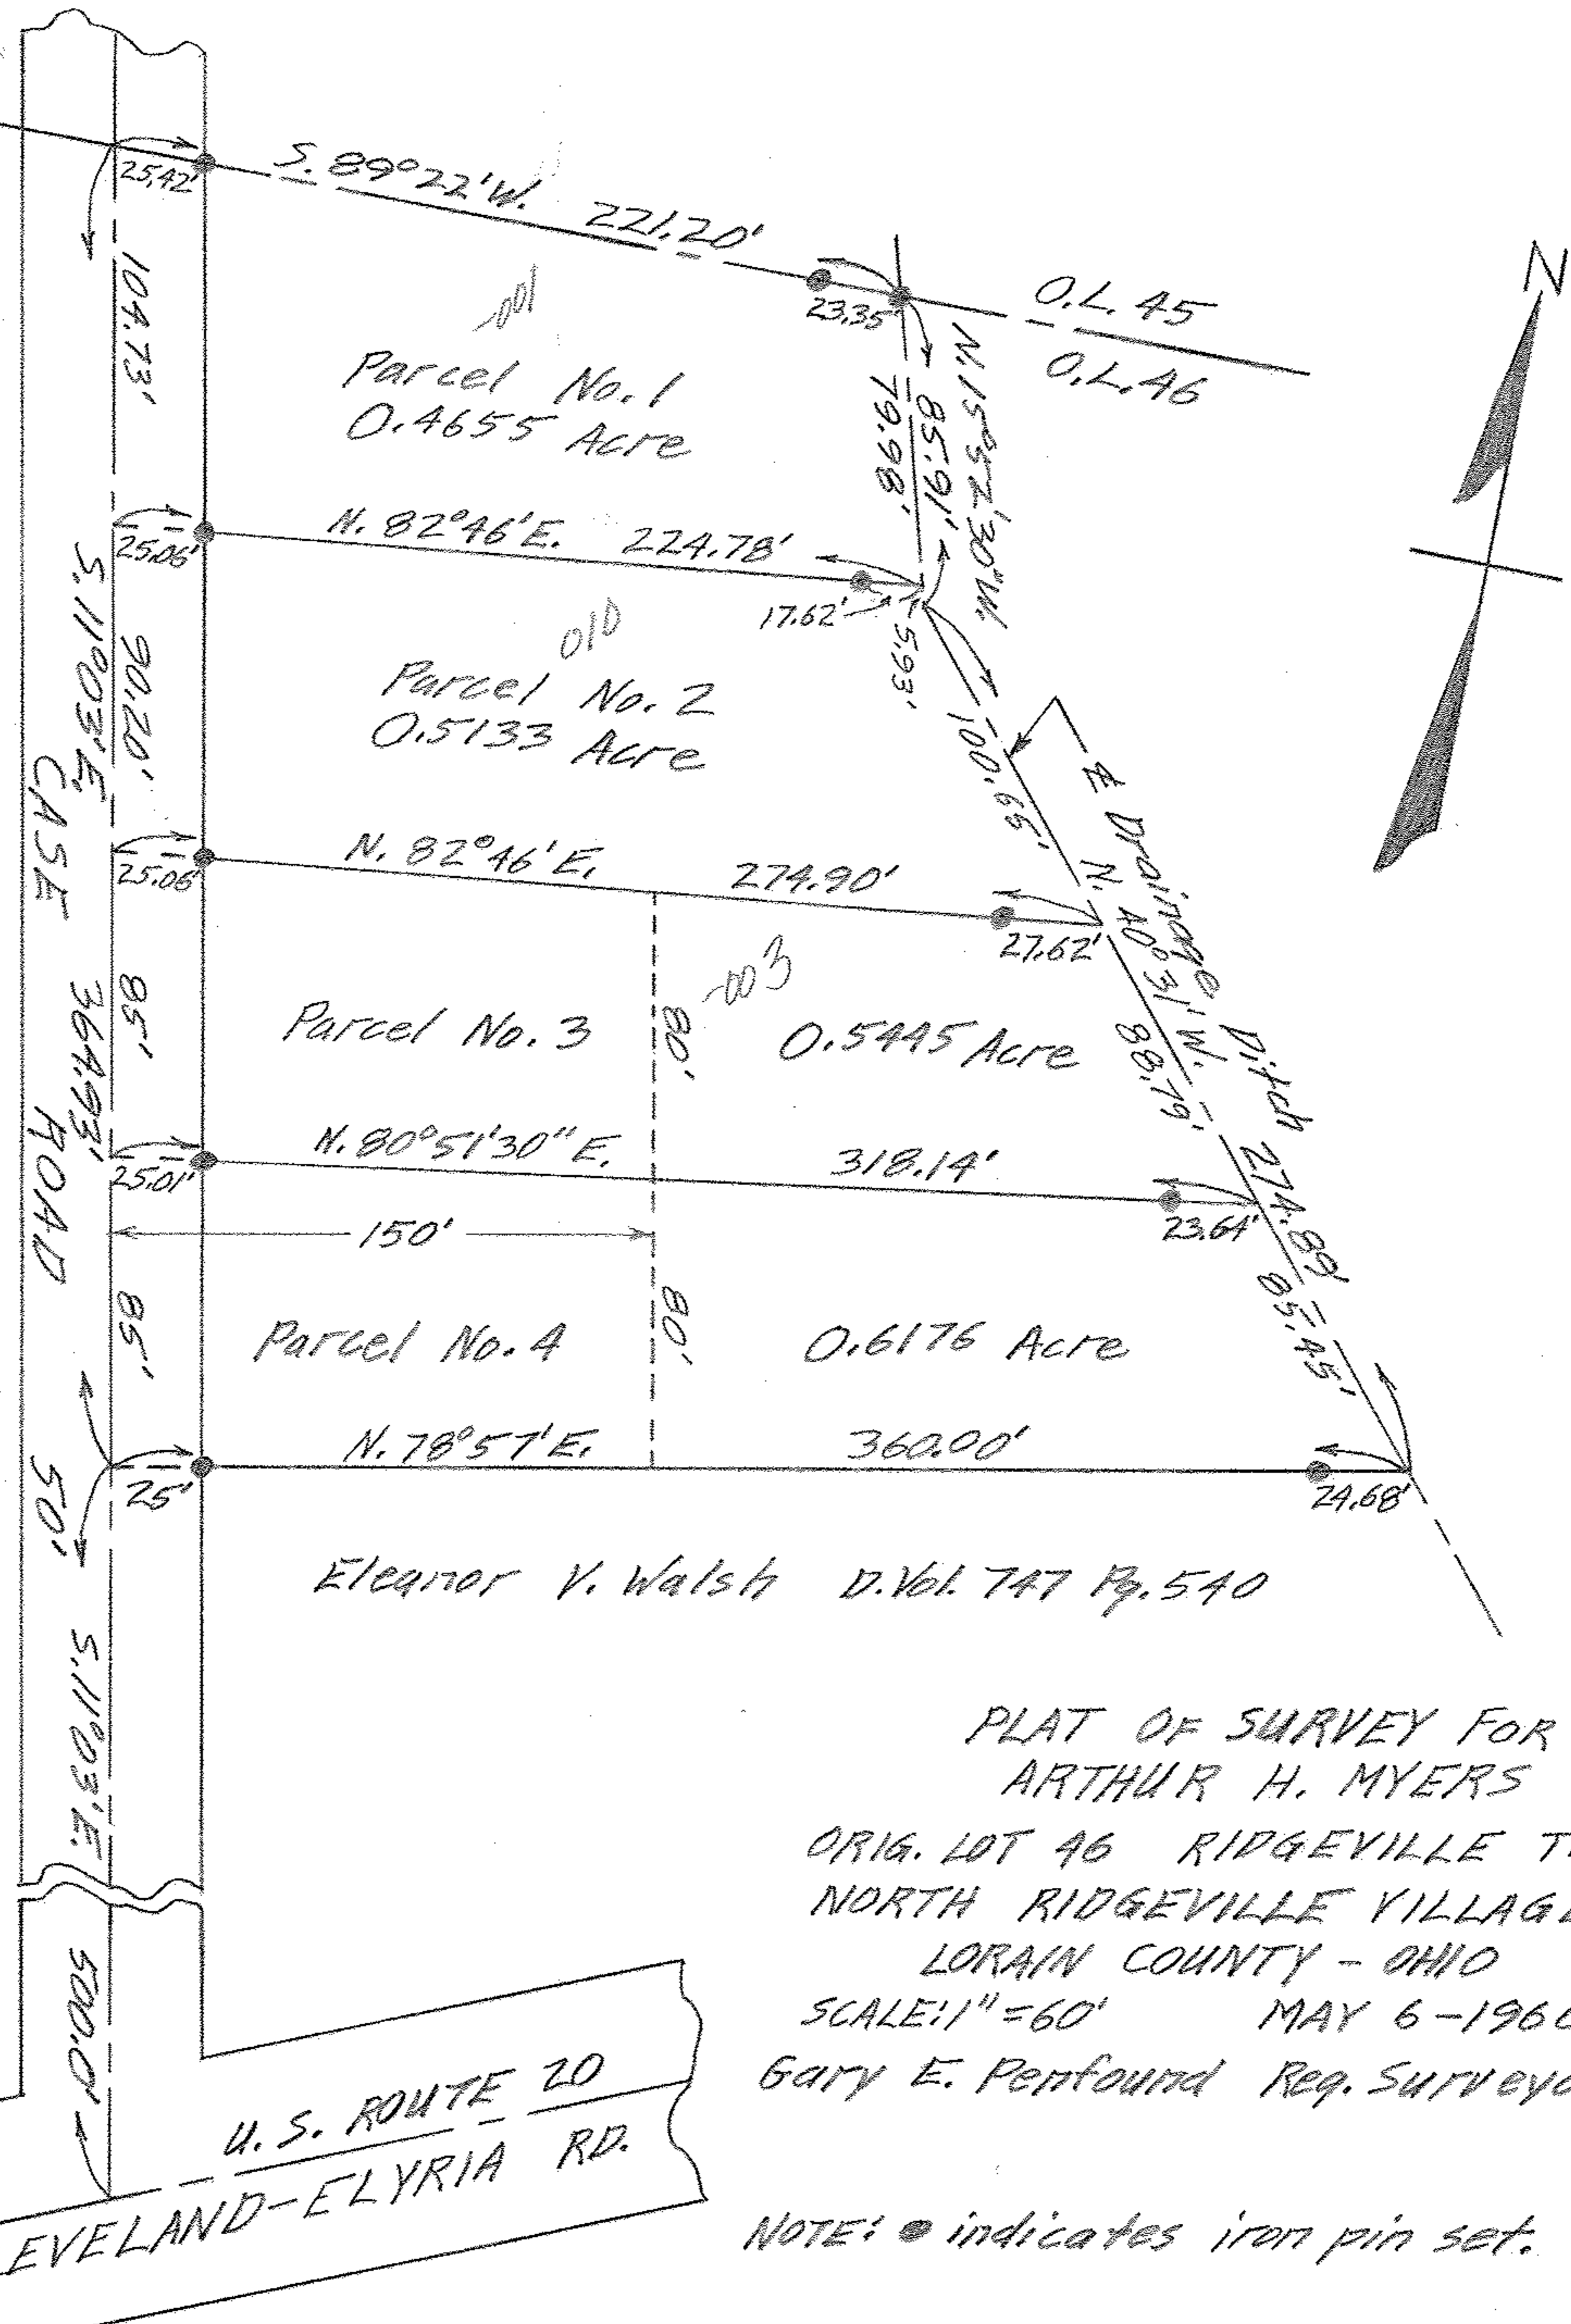

Eleanor V. Walsh D. Vol. 747 Pg. 540

PLAT OF SURVEY FOR
 ARTHUR H. MYERS
 ORIG. LOT 46 RIDGEVILLE TWP.
 NORTH RIDGEVILLE VILLAGE
 LORAIN COUNTY - OHIO
 SCALE: 1" = 60' MAY 6 - 1960
 Gary E. Penfound Reg. Surveyor

NOTE: ● indicates iron pin set.