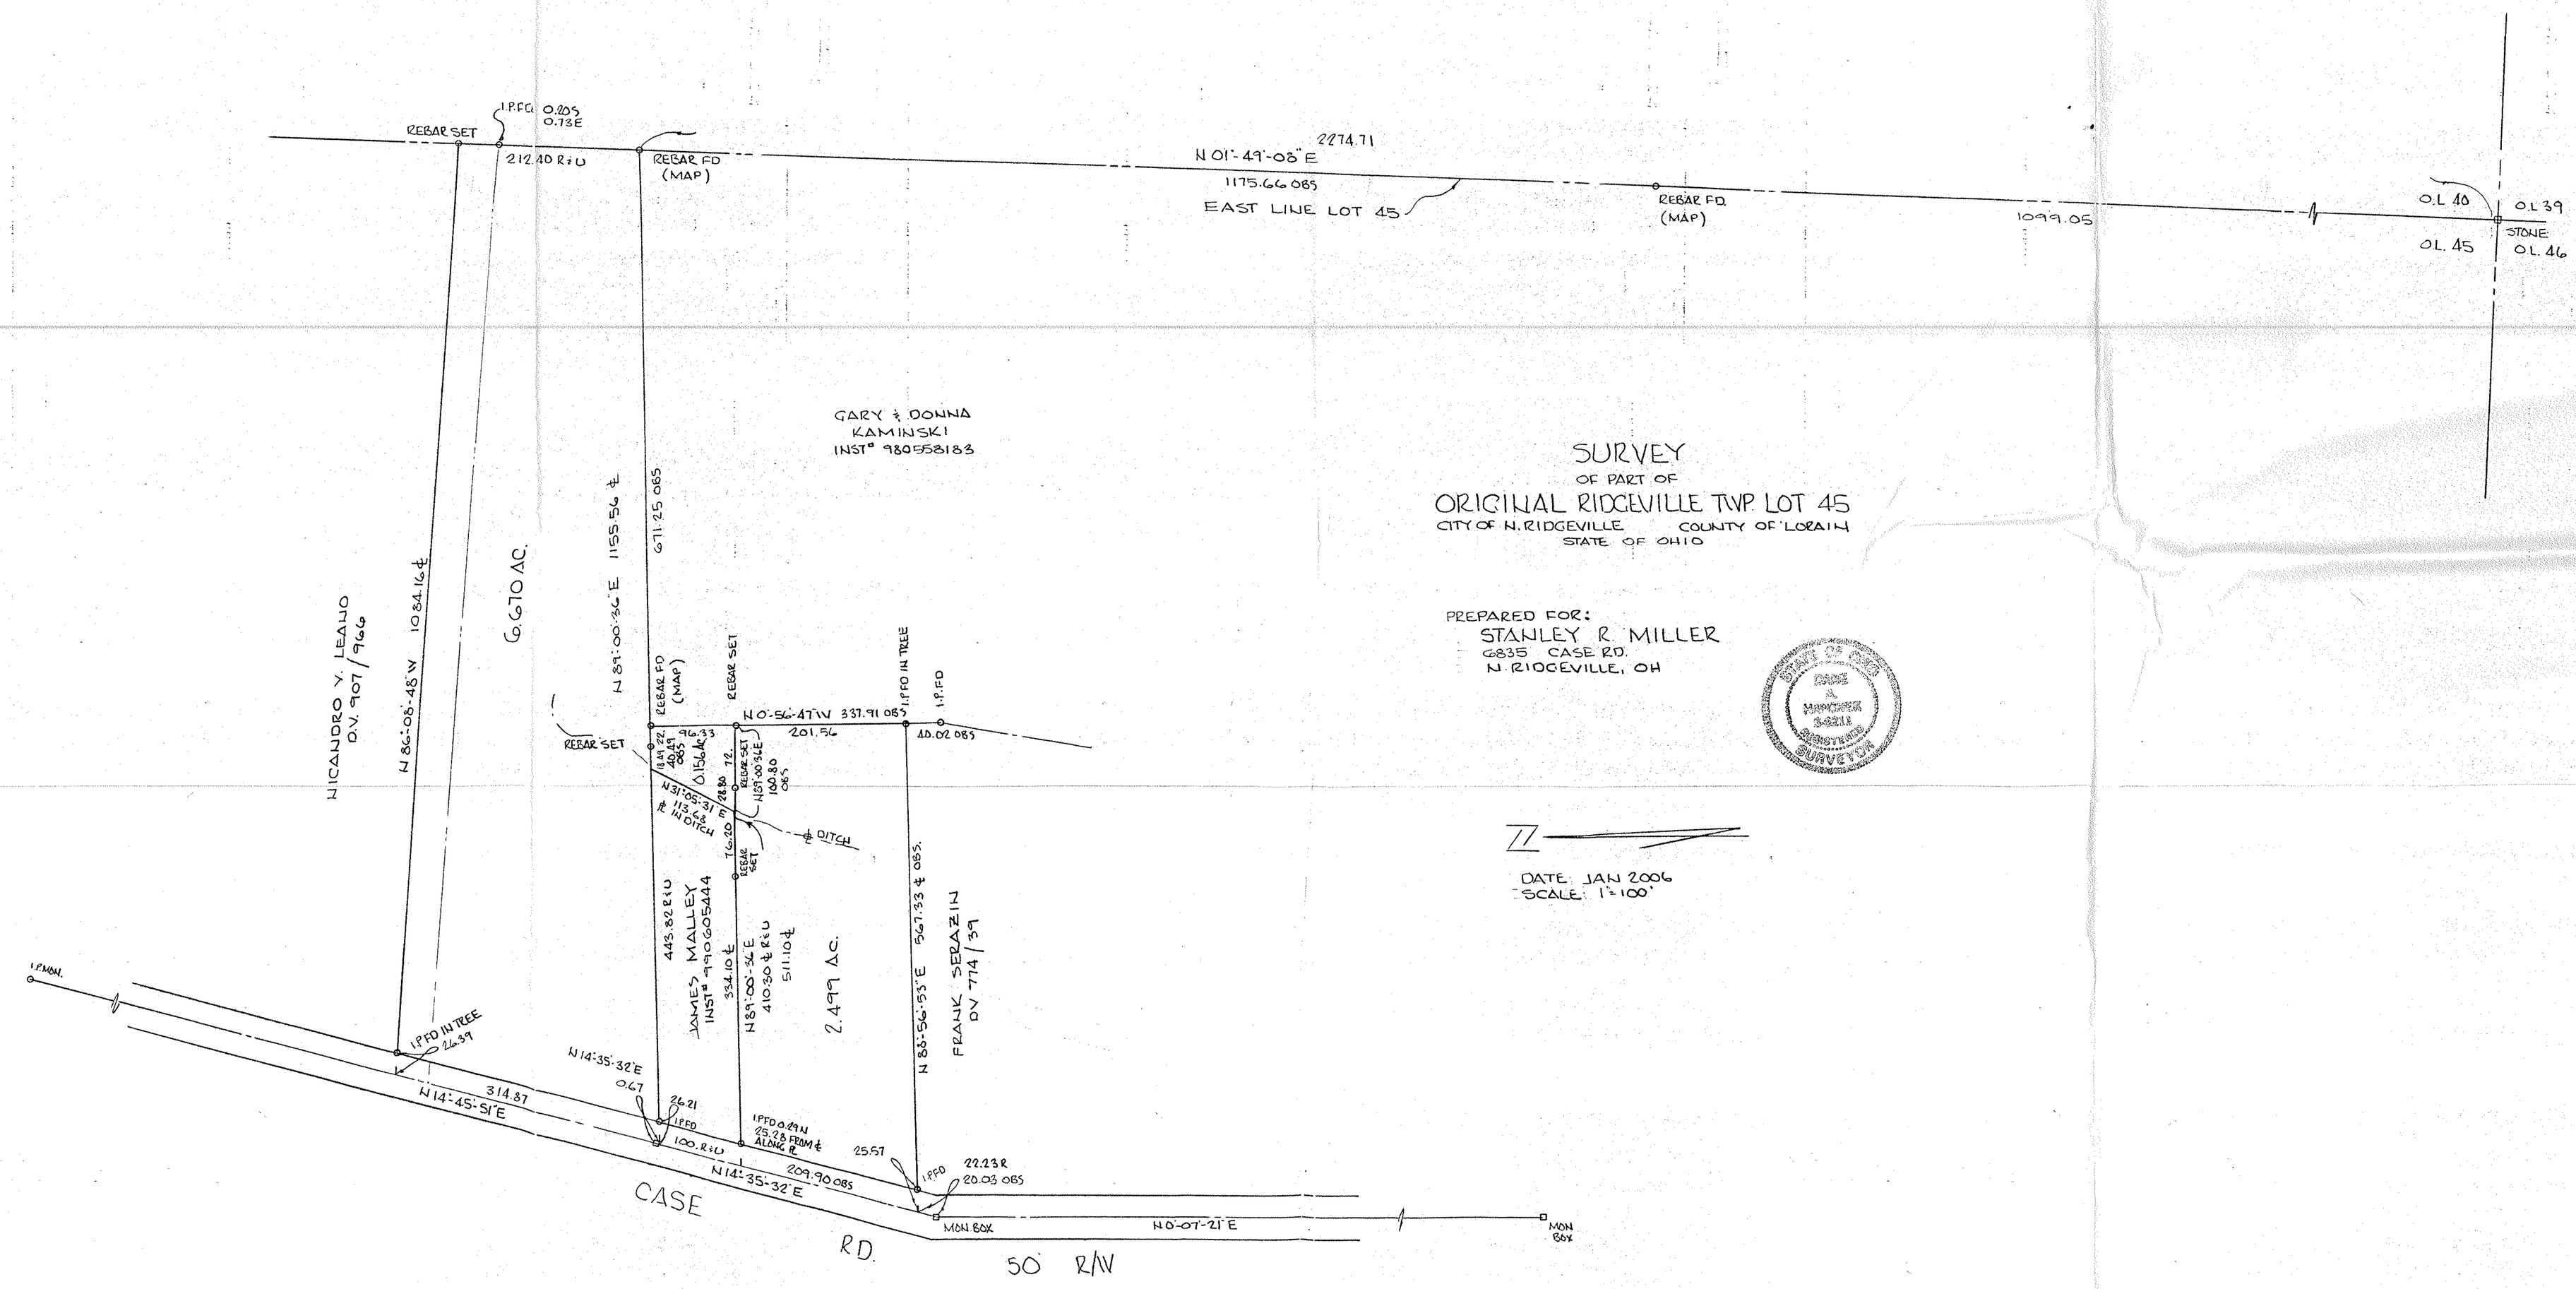

07-00-045-110-012
07-00-045-110-010
07-00-045-110-009
07-00-045-110-008
07-00-045-110-007
07-00-045-110-006
Scan # 46312
No 02219
Date 9-15-06
Page 7-00086D
By UNATFIELD
06-02218