SURVEY
OF PART OF
ORIGINAL RIDGEVILLE TWP.
LOT Nº 47
CITY OF N. RIDGEVILLE, OHIO
COUNTY OF LORAIN

PREPARED FOR
TIMOTHY SCHNEIDER
38915 SUGAR RIDGE RD.
N. RIDGEVILLE, OHIO

PREPARED BY
HAPONEK & ASSOC.
ENGINEERS & SURVEYORS
N. RIDGEVILLE, O

STATE OF OHIO
DANE A. HAPONEK
6221
REGISTERED SURVEYOR

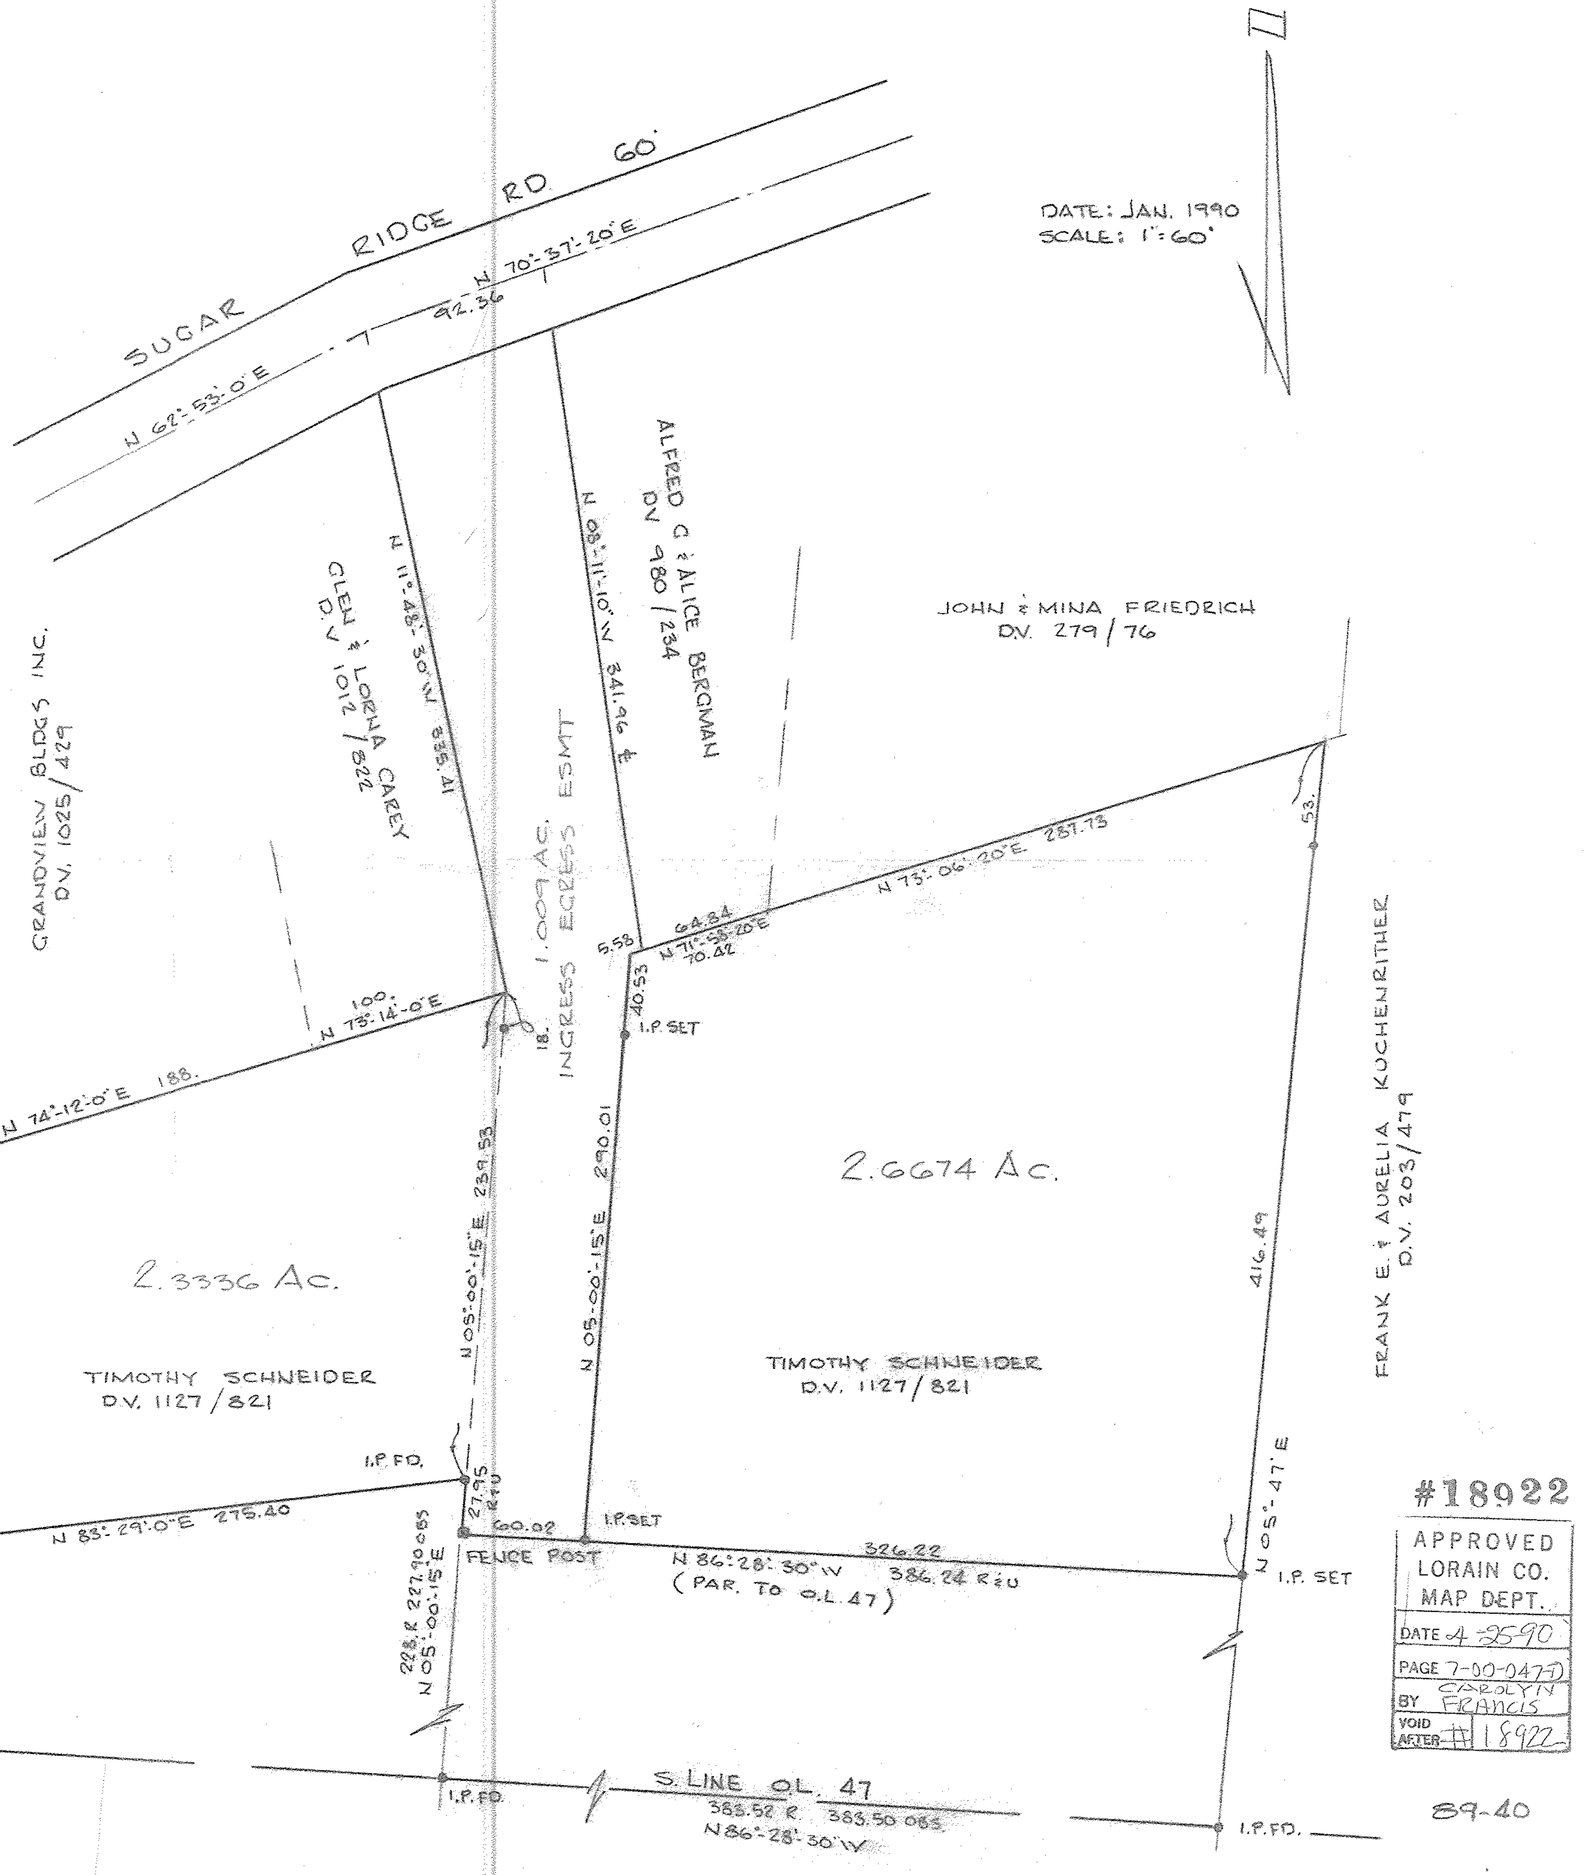

#18922

APPROVED
LORAIN CO.
MAP DEPT.
DATE 4-25-90
PAGE 7-00-047D
BY CAROLYN FRANCIS
VOID AFTER #18922

89-40