08-12-015-000-022 ??

8-G SCAN #46342

PLAT OF SURVEY FOR SILAS P. BUCHS

ORIGINAL LOT 16 - TRACT 12 - HENRIETTA TWP.

LORAIN COUNTY OHIO

SCALE: 1" = 60'

SEPTEMBER 20-1962

Gary E. Penfound Reg. Surveyor No. 4457
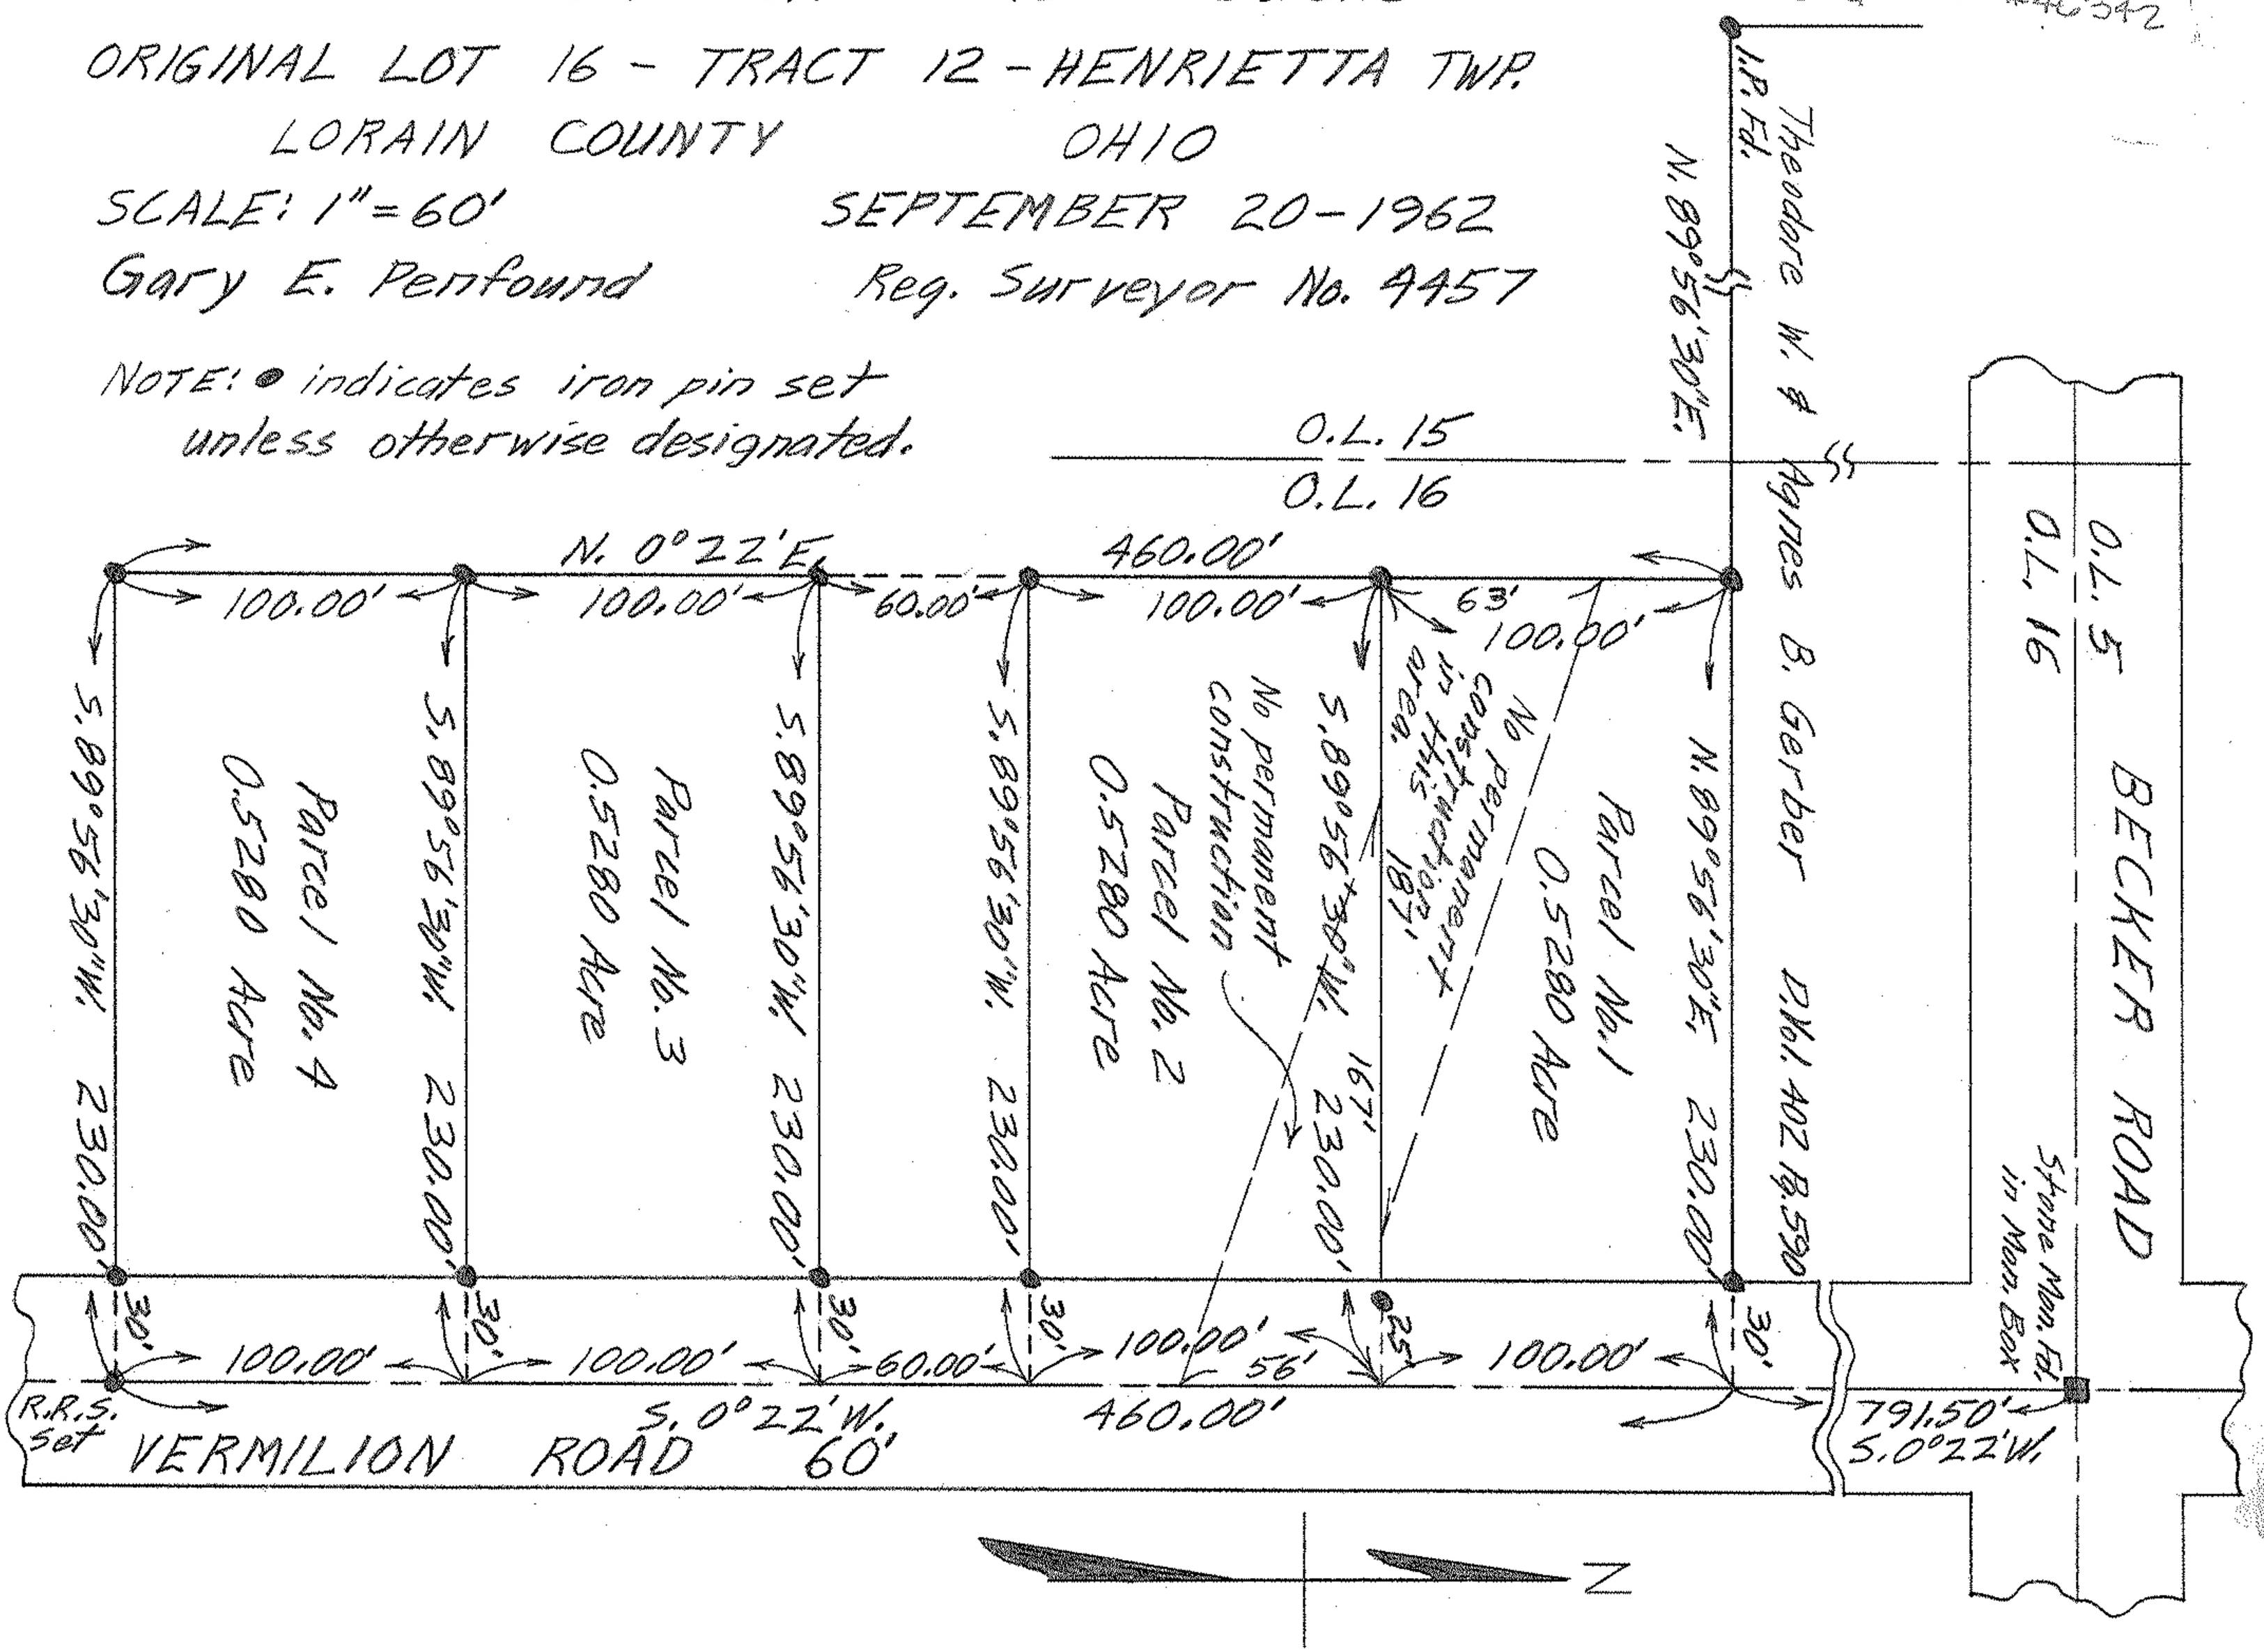
NOTE: ● indicates iron pin set unless otherwise designated.