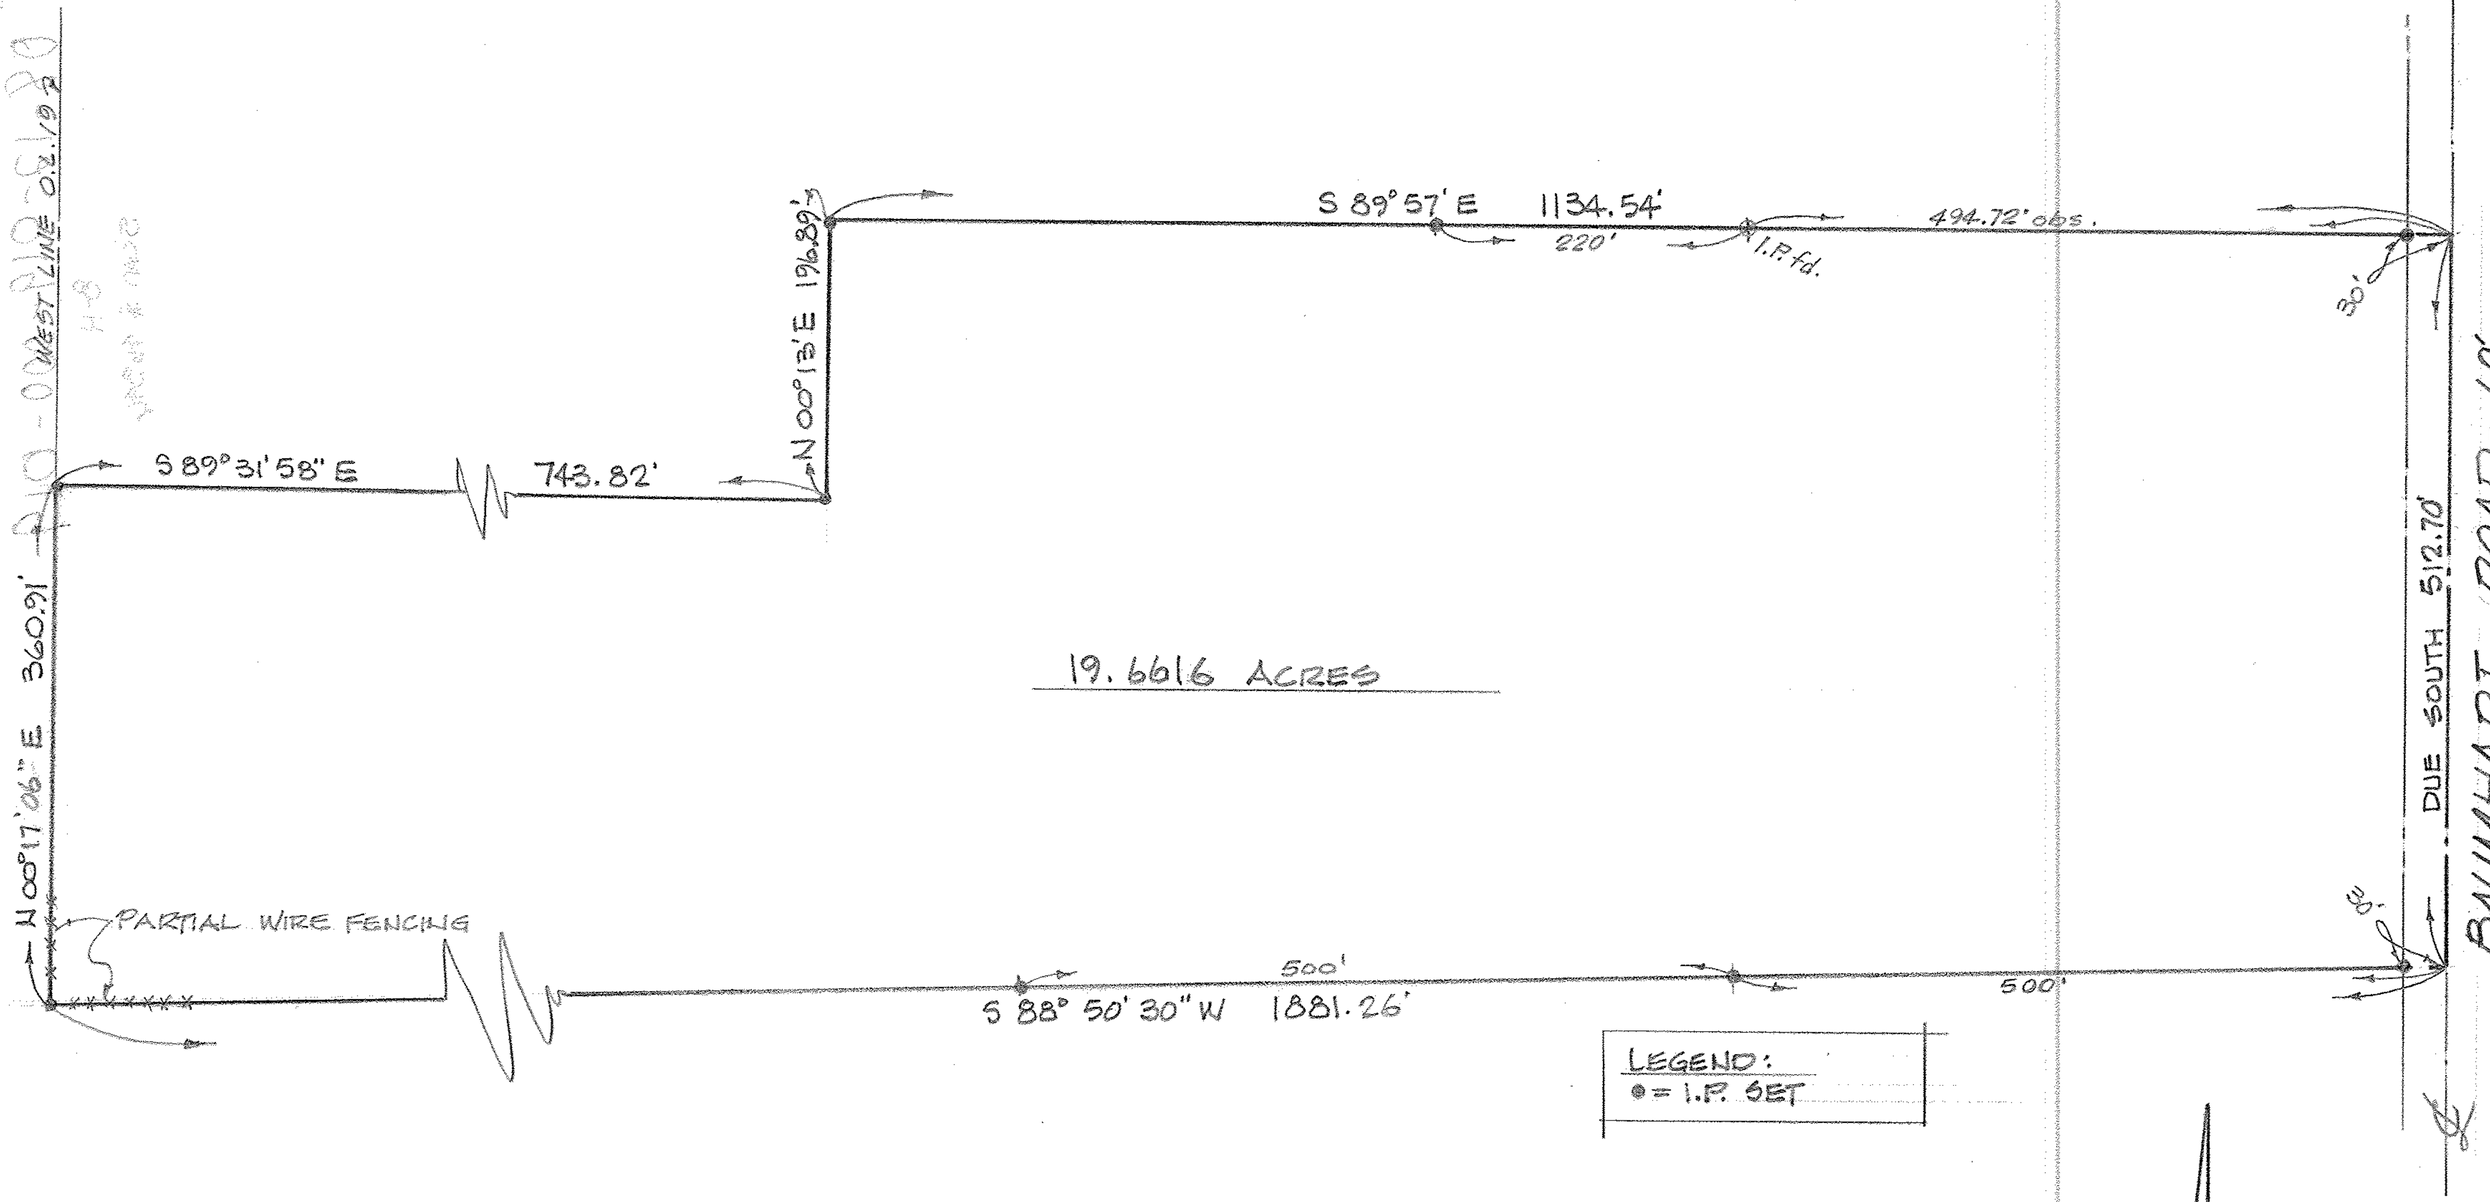

LEGEND:
● = I.P. SET

MAP of BOUNDARY SURVEY

PREPARED FOR JEFF WHITE

PART of ORIG. HENRIETTA TOWNSHIP LOT No. 19, TRACT 12
TOWNSHIP of HENRIETTA, LORAIN COUNTY, OHIO

McGLINCHY & ASSOCIATES INC.
PROFESSIONAL ENGINEER and SURVEYORS
110½ MIDDLE AVE. ELYRIA, OHIO
MAY, 1982 # 827220