09.00.027.000.033, 034
9-C

PLAT OF SURVEY FOR
LEONARD & HAZEL BERG

ORIGINAL LOT 27 RUSSIA TWP.
LORAIN COUNTY OHIO
SCALE: 1" = 100' FEB. 27 - 1972
Gary E. Penfound Reg. Surveyor No. 4457

N
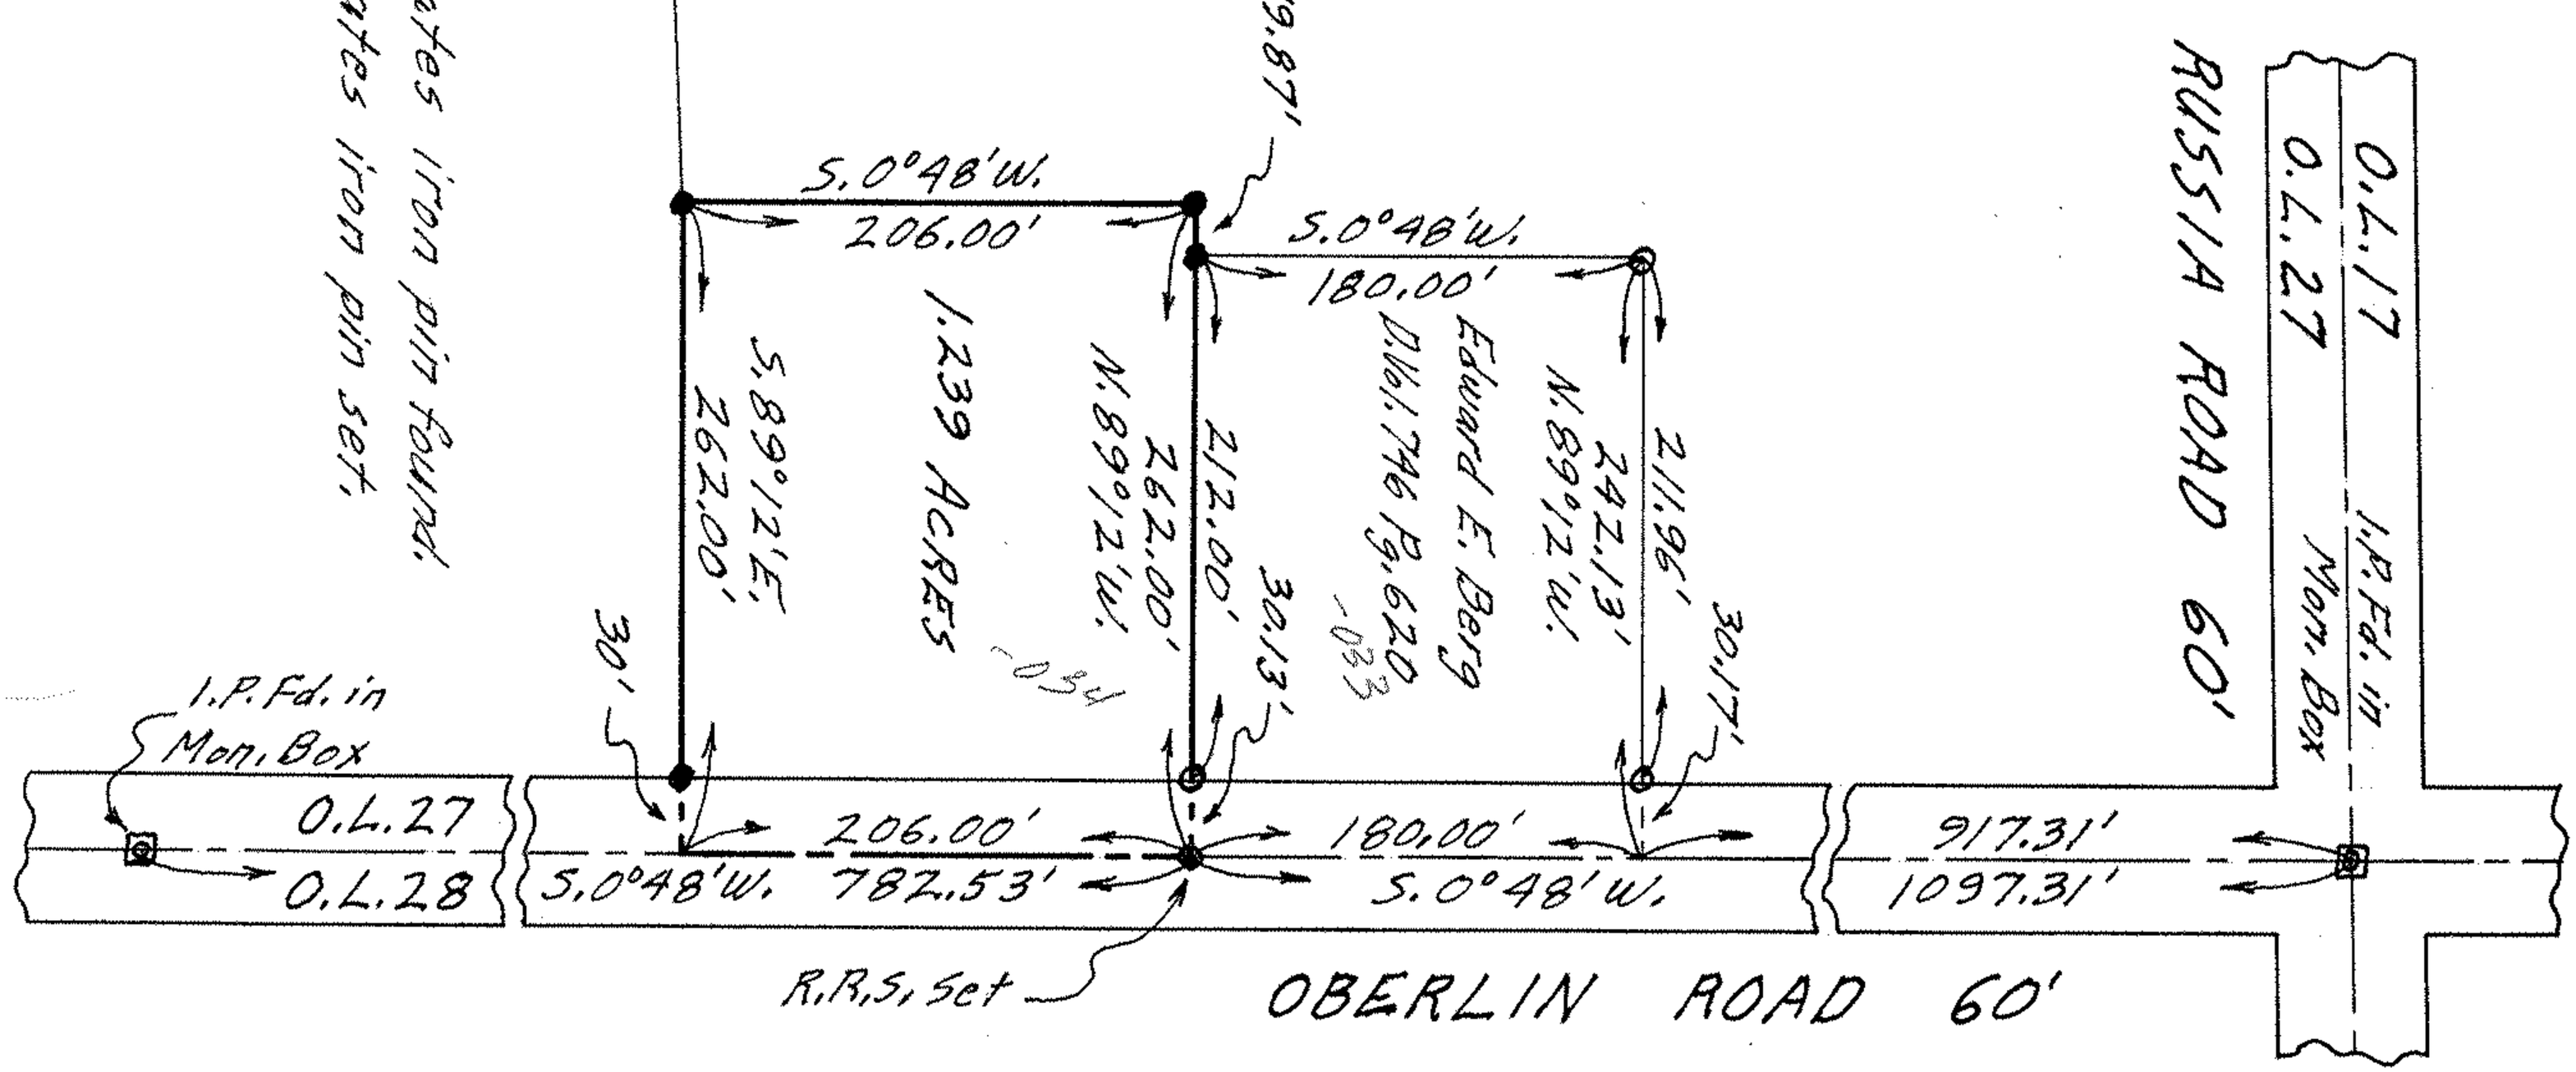
NOTES: O indicates iron pin found.
● indicates iron pin set.