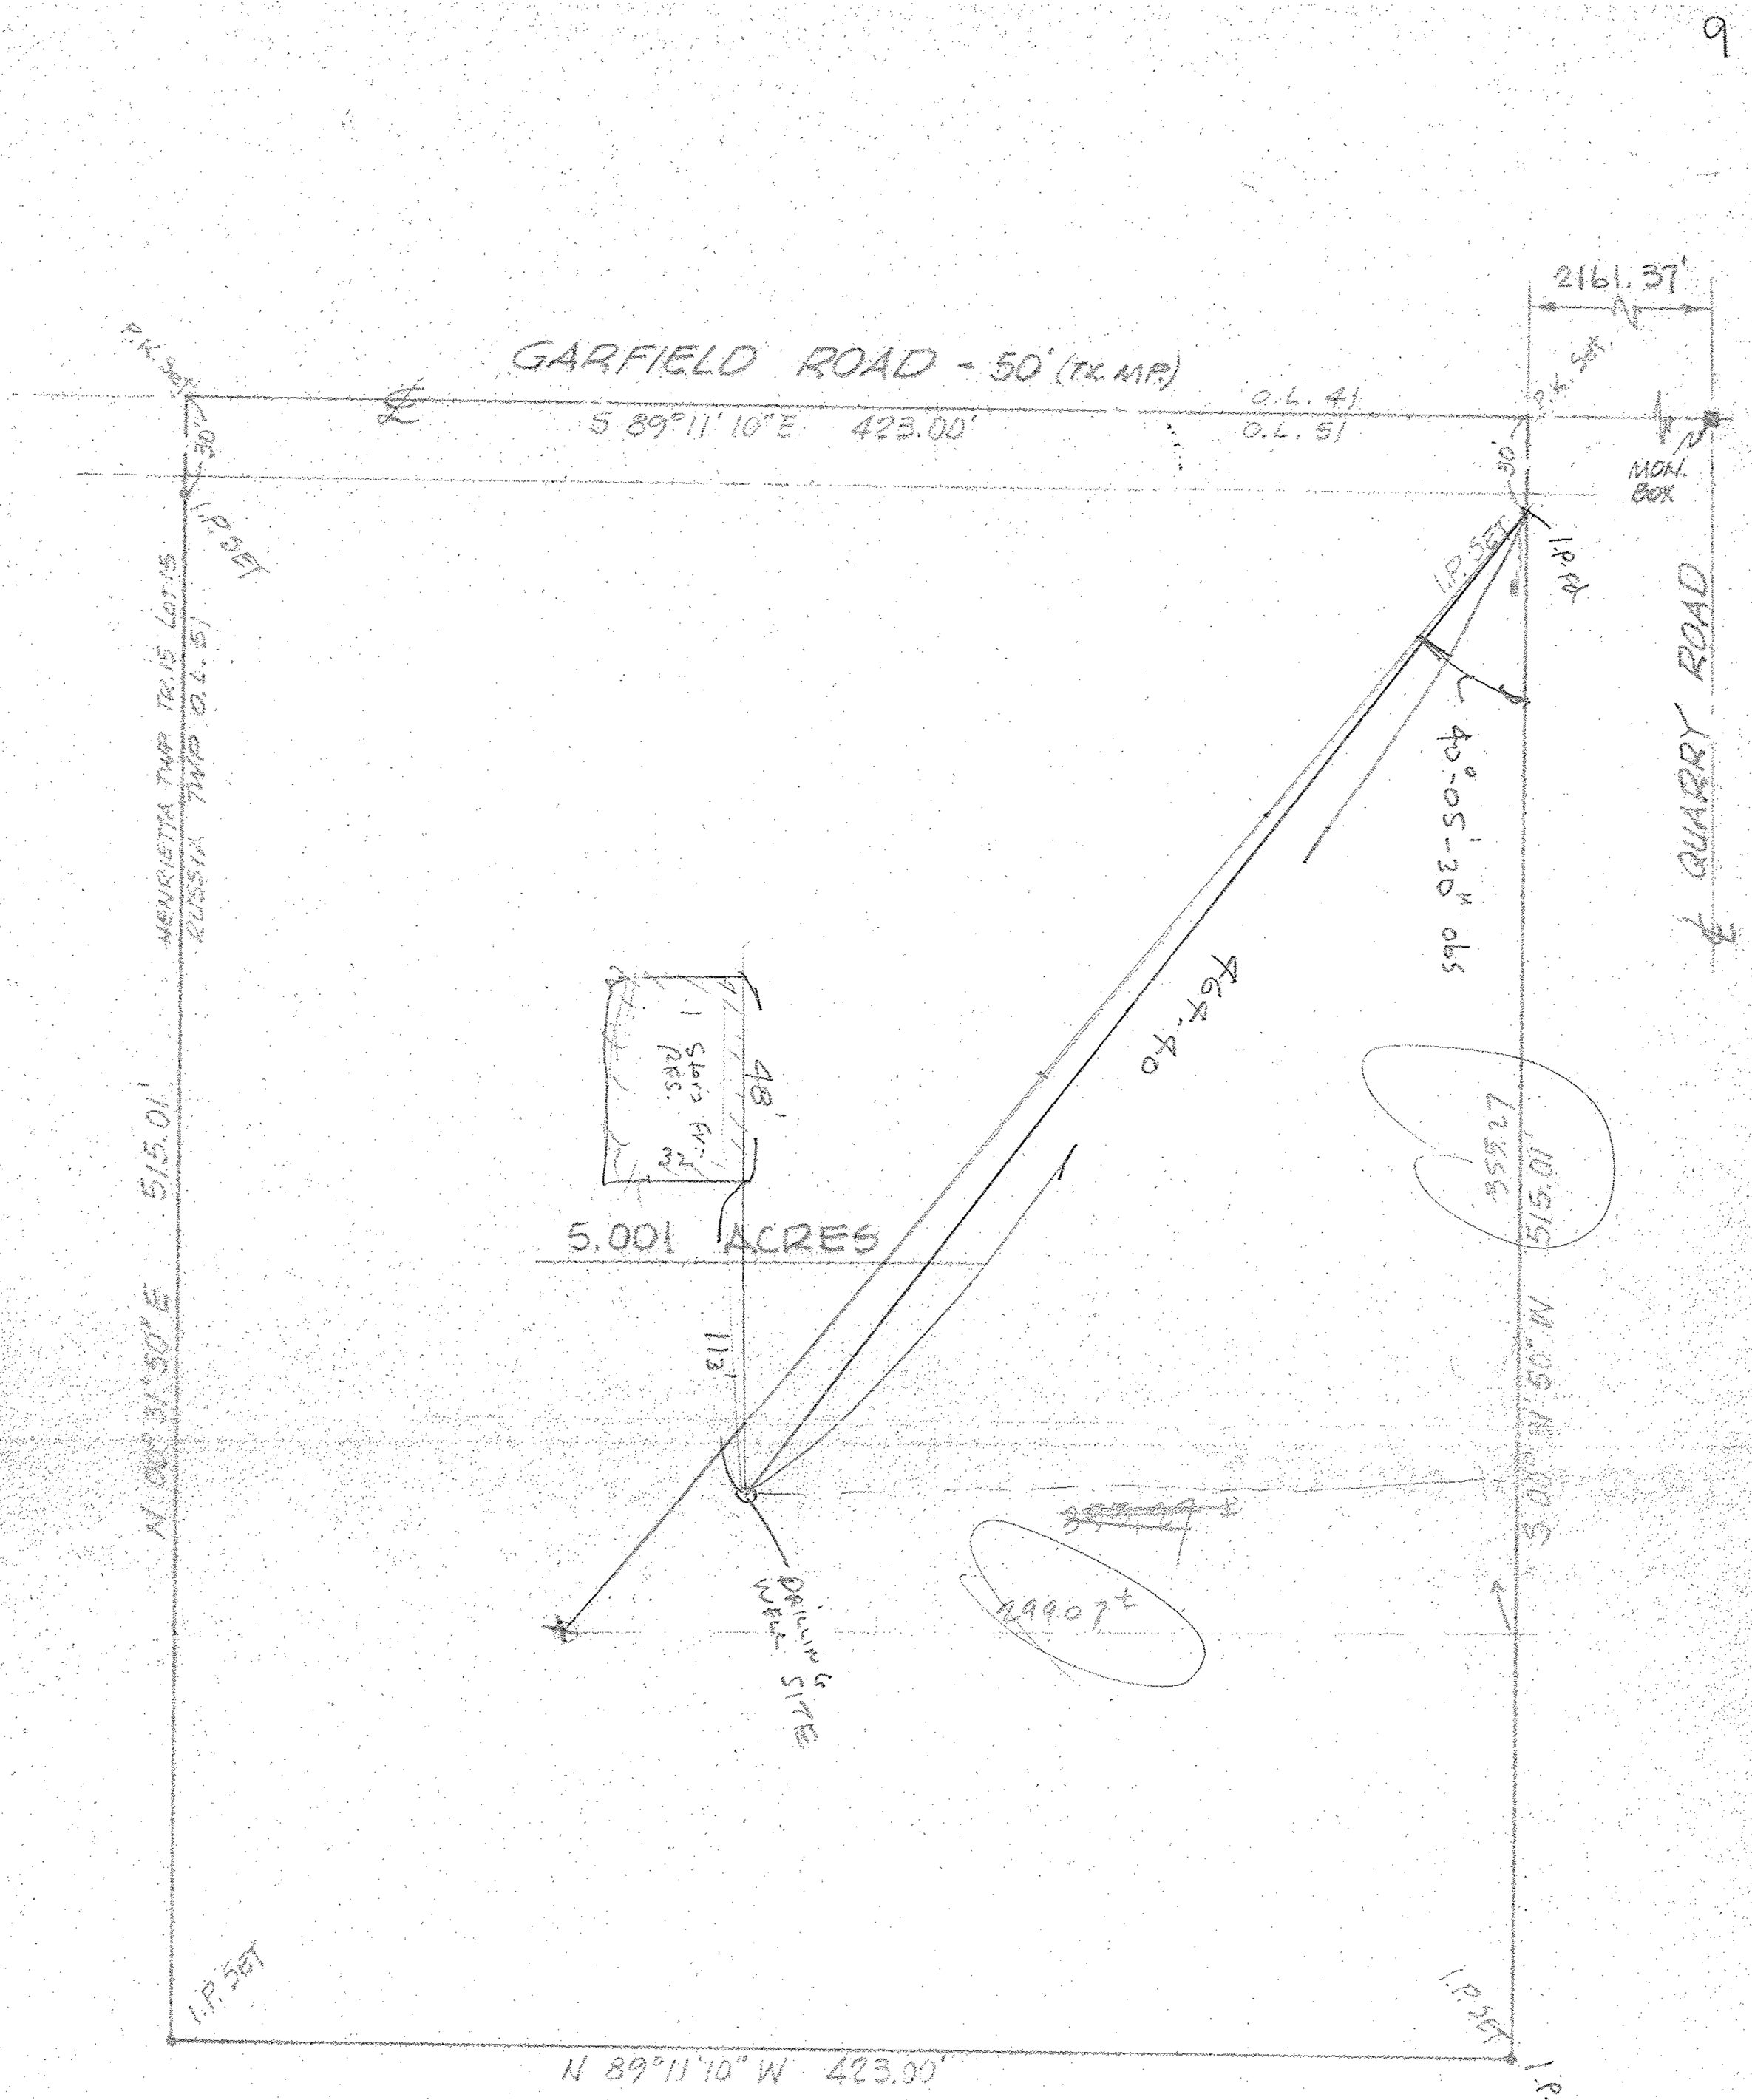

NOTE: PART of P.P. # 09-00-051-000-001 299/24

MAP of SURVEY & PROPOSED PARCEL SPLIT

PREPARED FOR ERNEST KASERMAN

PART of ORIGINAL RUSSIA TWP. LOT No. 51
TOWNSHIP of RUSSIA, LORAIN COUNTY, OHIO

N 600,760
E 2064080
ELEV 829.5

McGLINCHY & ASSOCIATES
PROFESSIONAL ENGINEER & SURVEYORS
ELYRIA OHIO
NOVEMBER, 1978 #7B4485