09-00-074-103-044

09-00-074-B
SCAN #46370

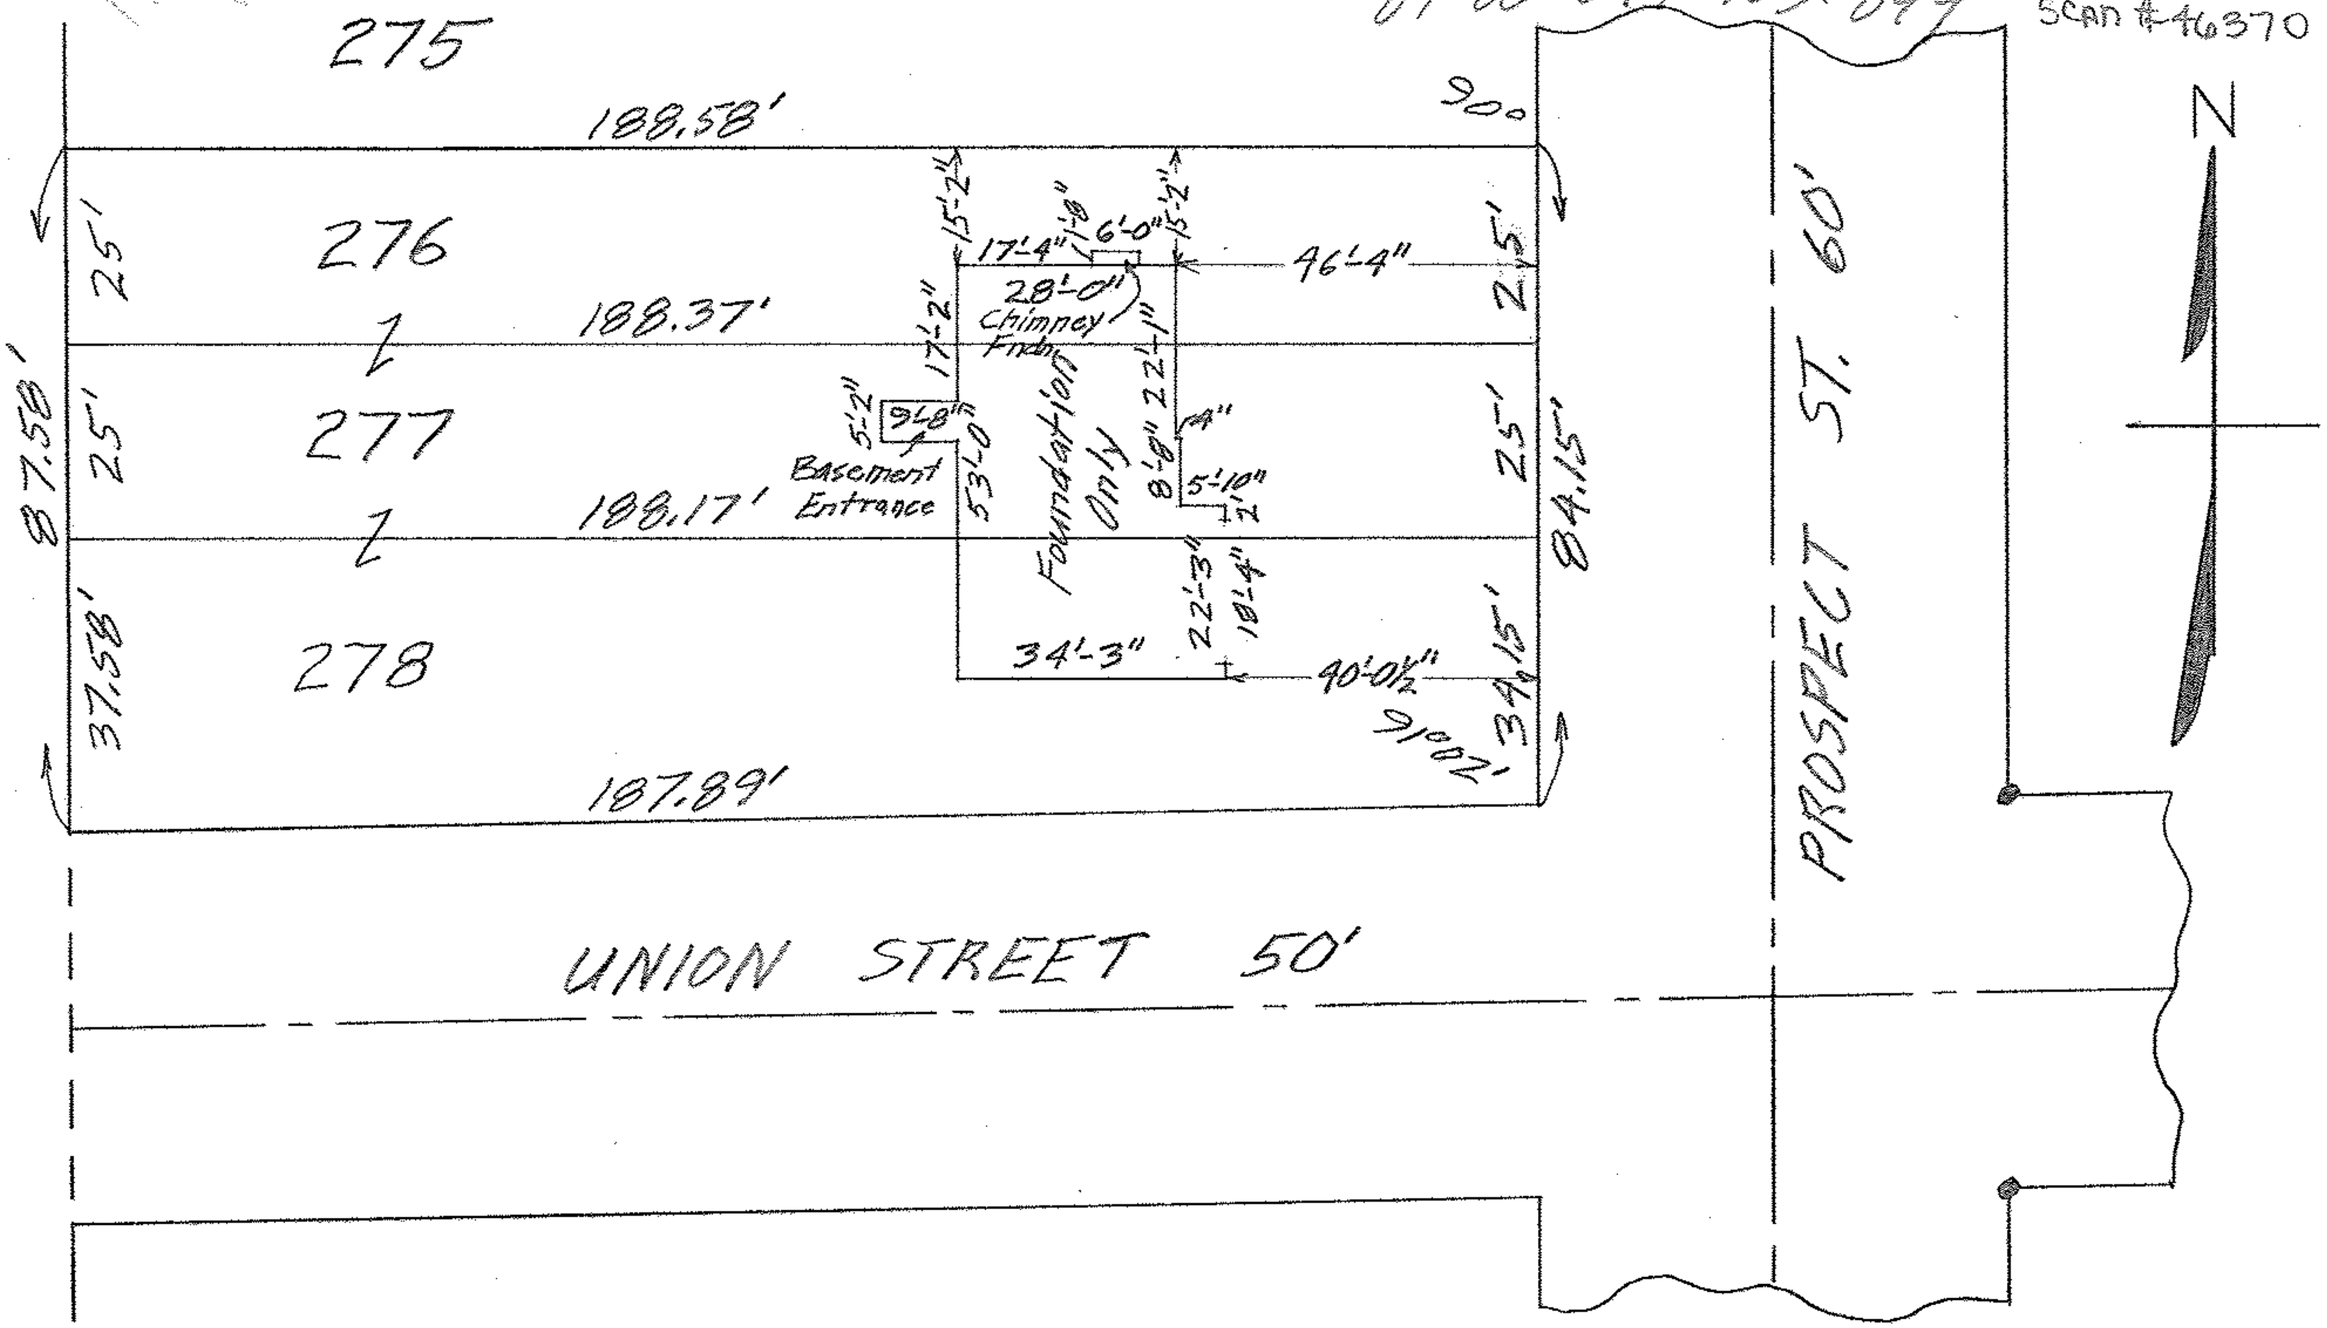

MAP OF SUB-LOTS 276 - 277 & 278
HOLLYWOOD ADD'N. VOL. 7 PG. 55 PLATS
ORIG. LOTS 74 & 75 RUSSIA TWP.
OBERLIN CITY - LORAIN COUNTY - OHIO
SCALE: 1"=30' MAY 9 - 1963 1:45 P.M.

NOTE: Measurements are to 8" block above grade where both 8" & 12" block are used in foundation walls.

Gary E. Penfound
for C.E. Penfound REG. SURVEYORS

E-12471 Oberlin Home Development Enterprises, Inc.