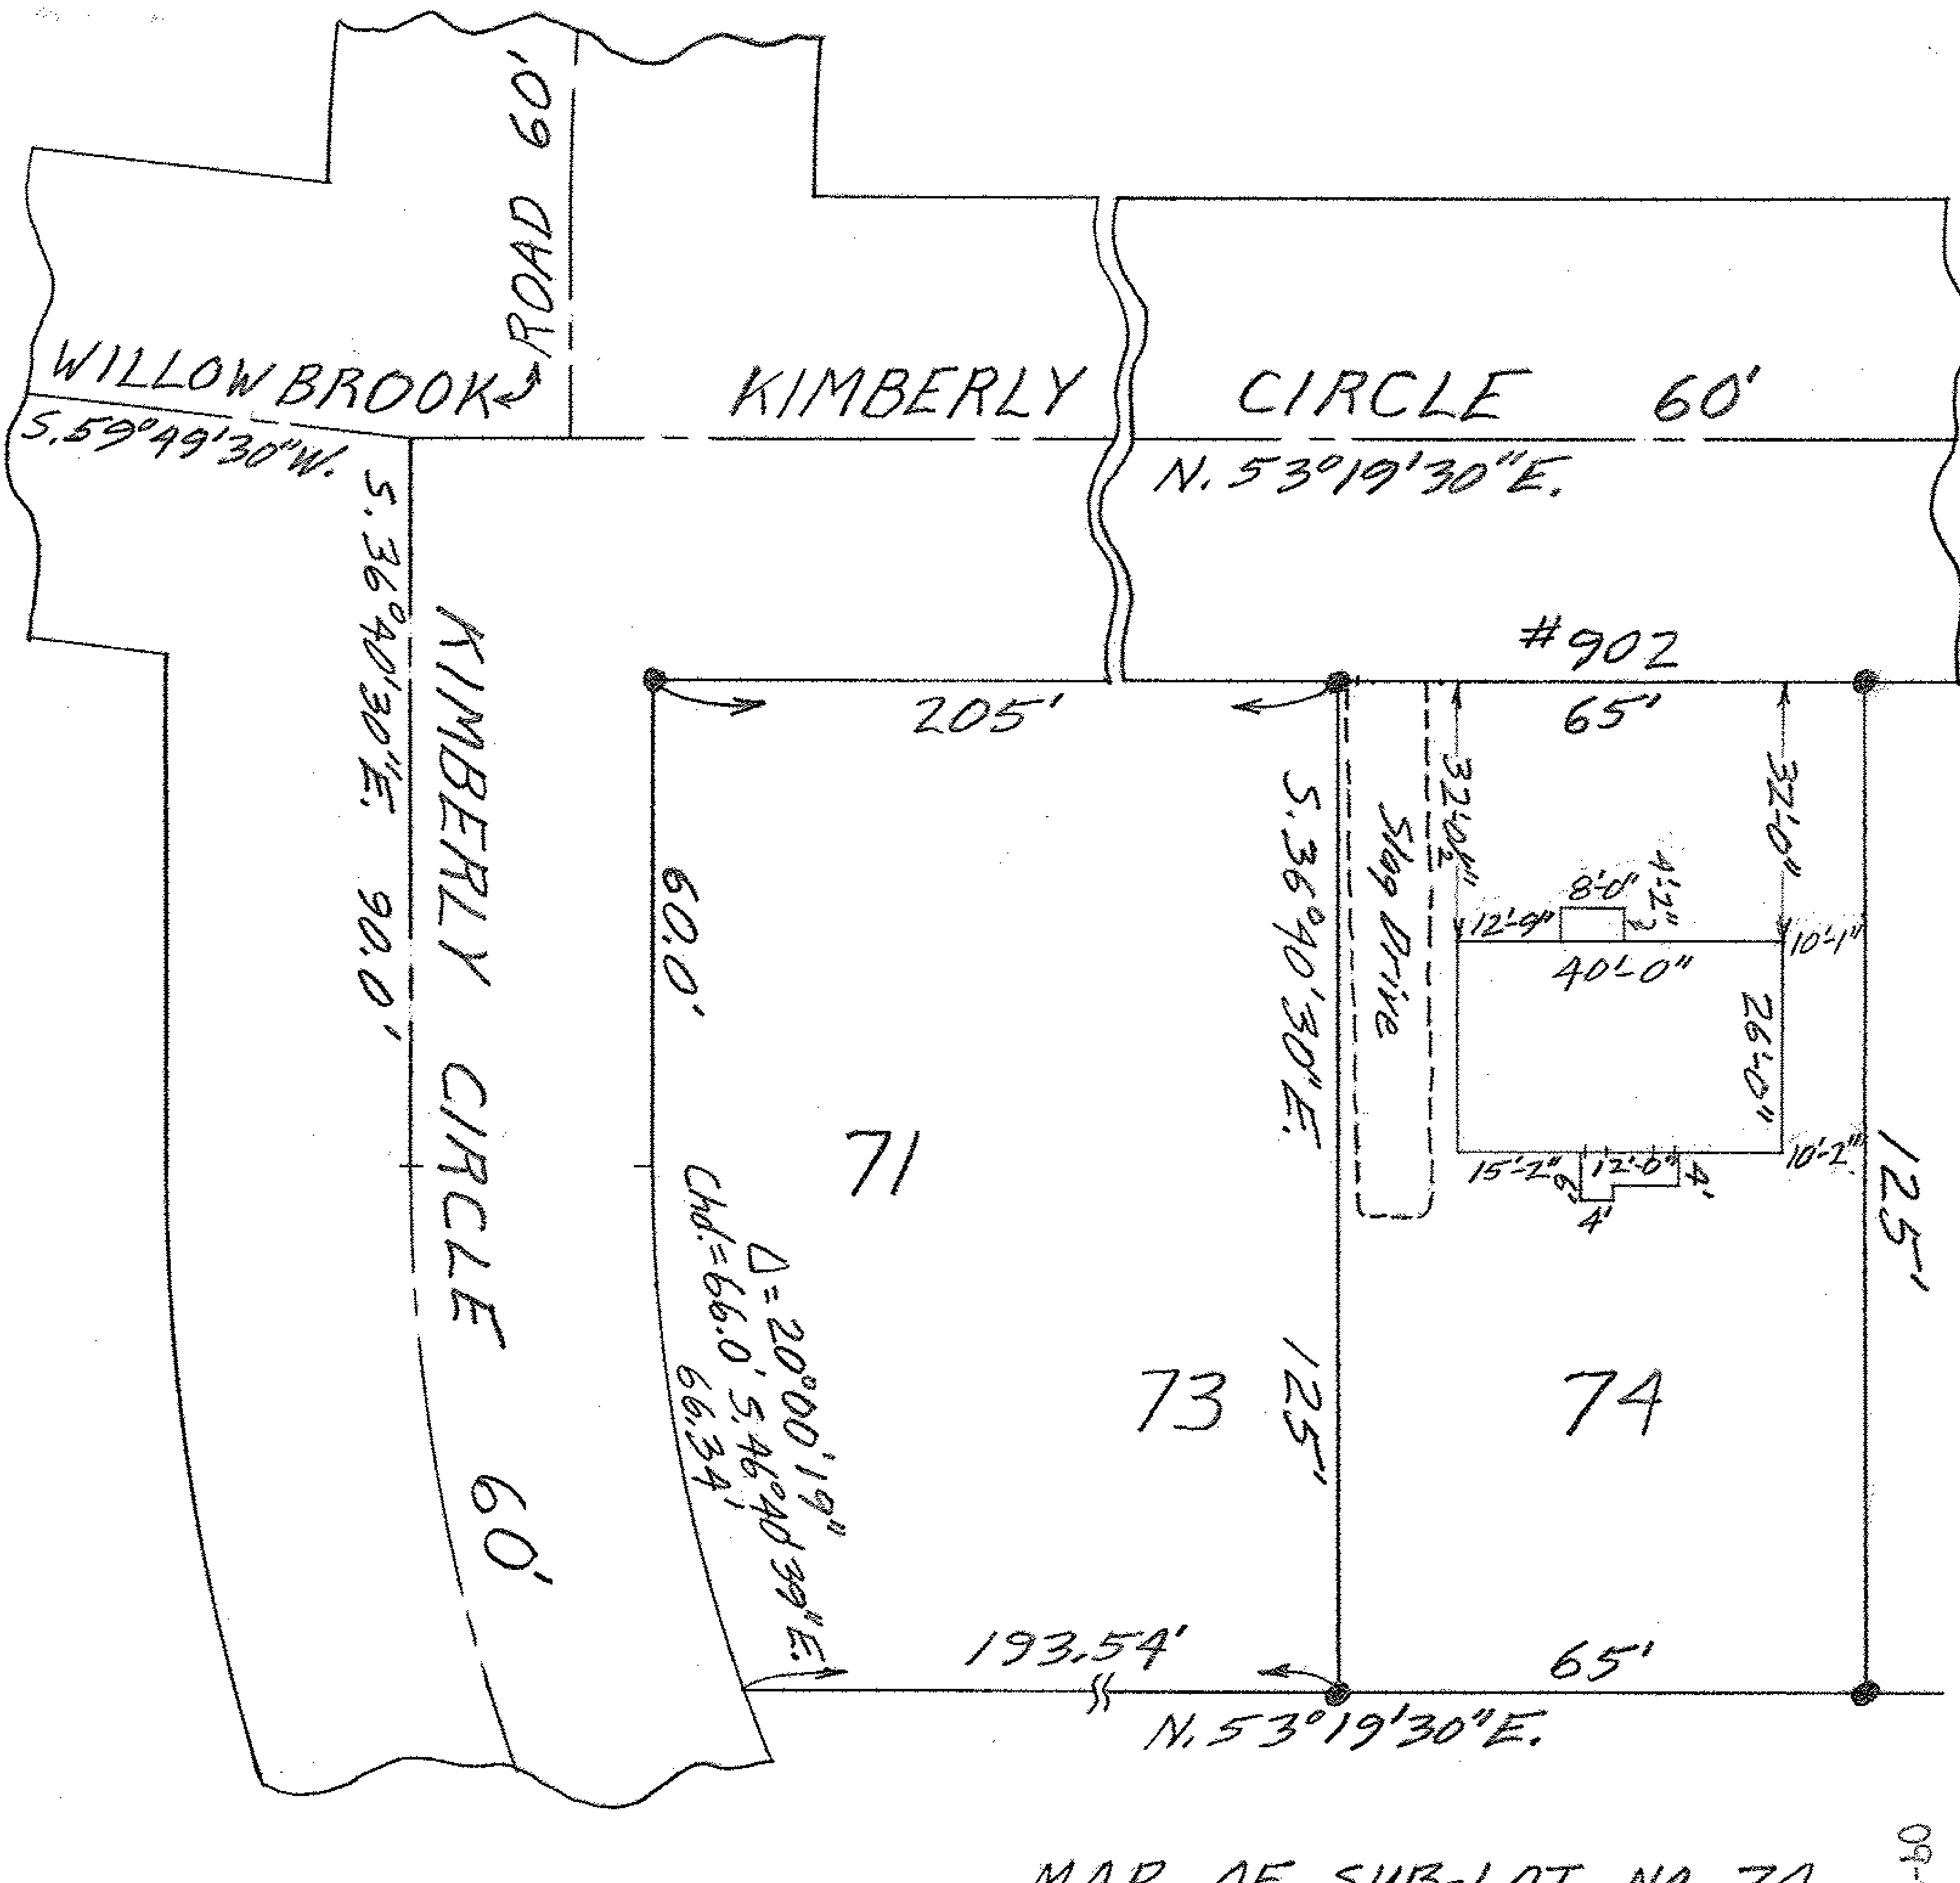

MAP OF SUB-LOT NO. 74
WILLOWBROOK FARMS SUB'N. NO. 2
VOL. 22 PG. 53 PLAT RECORDS
O.L. 88 RUSSIA TWP. - OBERLIN CITY
LORAIN COUNTY OHIO
SCALE: 1"=30' MAR. 22-1963 4:00 P.M.
Gary E. Penfound REG. SURVEYOR

John E. & Janice L. Rand

09-00-088-104-025, 024, 023
09-00-088-B
Scan# 46885