09-00088-A 09-00-088-104-019

Scan# 4638C

MAP OF SUB-LOT NO. 77

WILLOWBROOK FARMS SUB'N. NO. 2

VOL. 22 PG. 53 PLATS

O.L. 88 RUSSIA TWP. — OBERLIN CITY

LORAIN COUNTY - OHIO

SCALE: 1"=30' JUNE 28-1962 2:00 P.M.

Gary E. Penfound REG. SURVEYOR
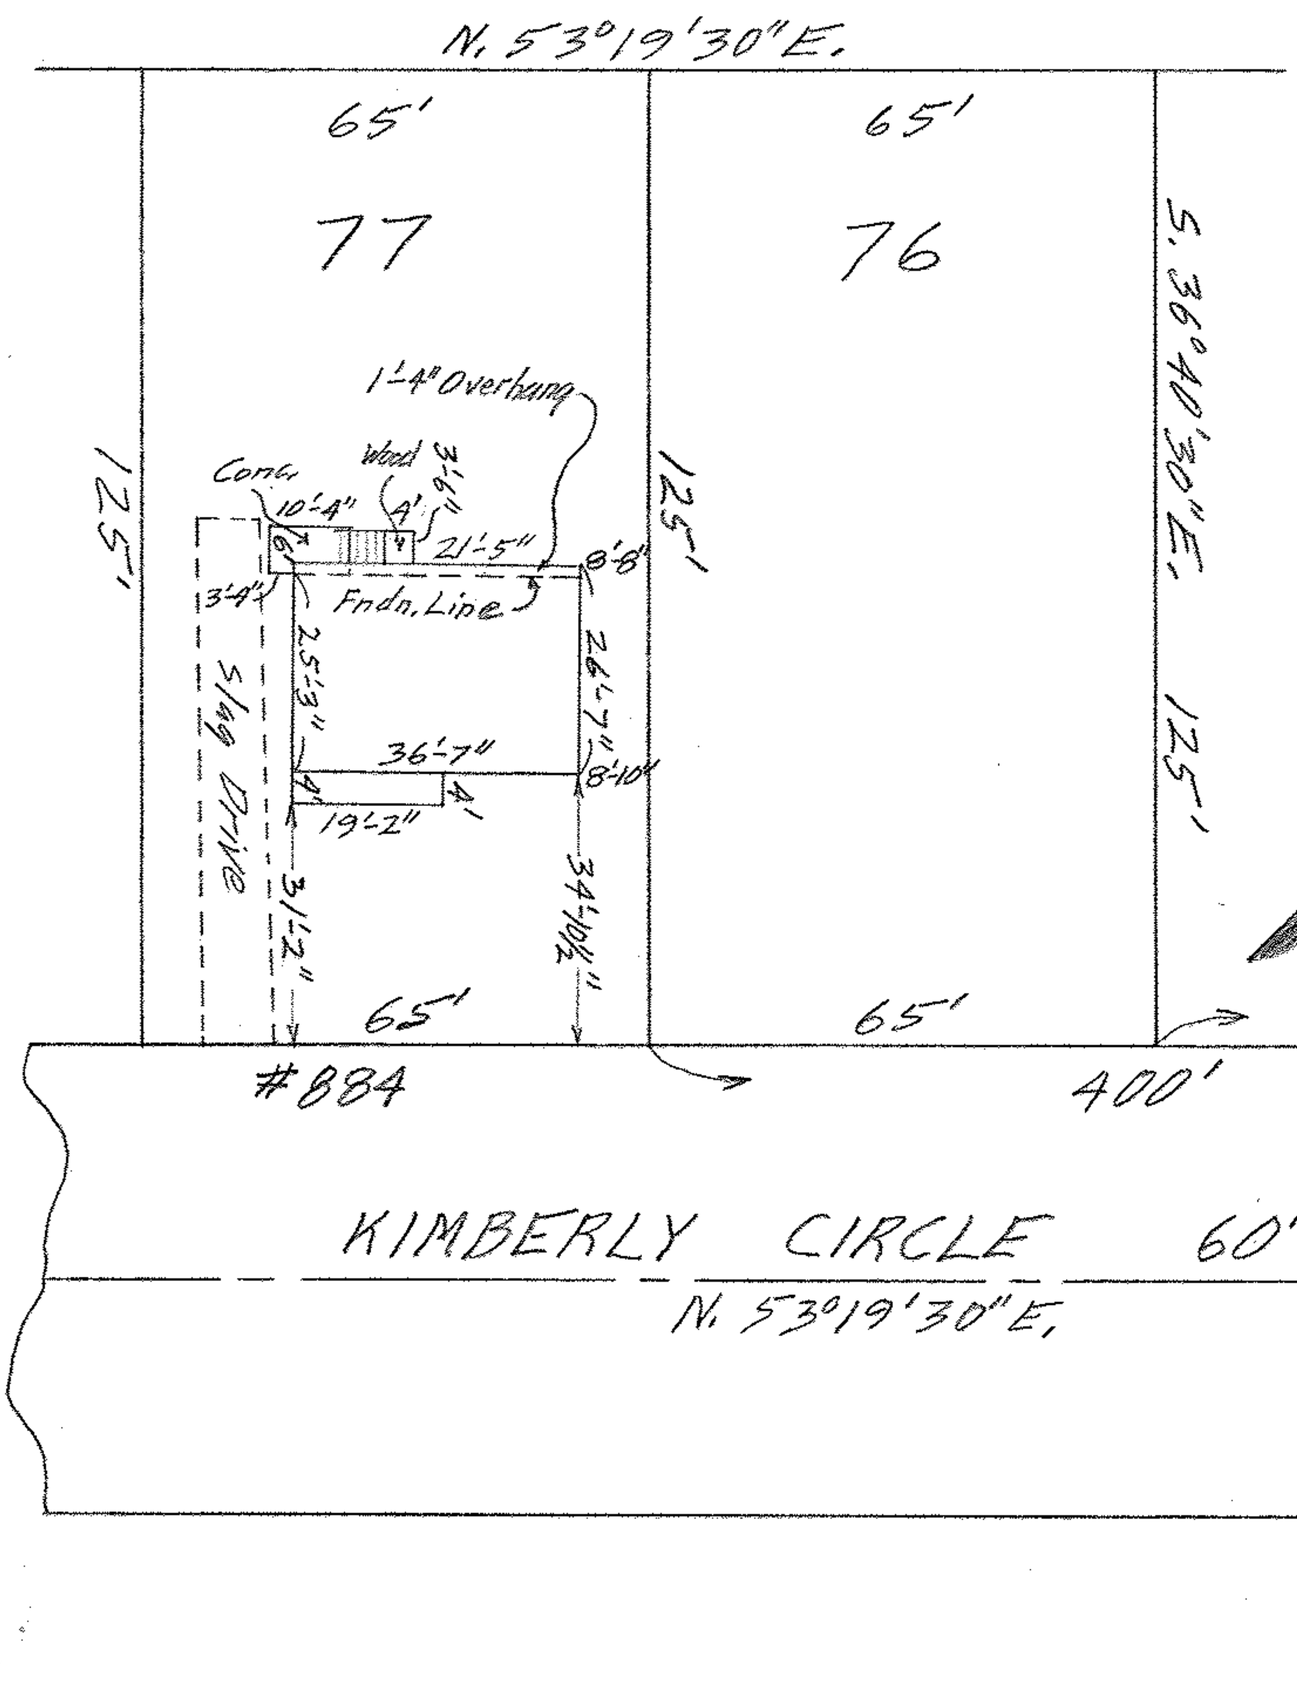
Willard L. & Edna M. Christopher