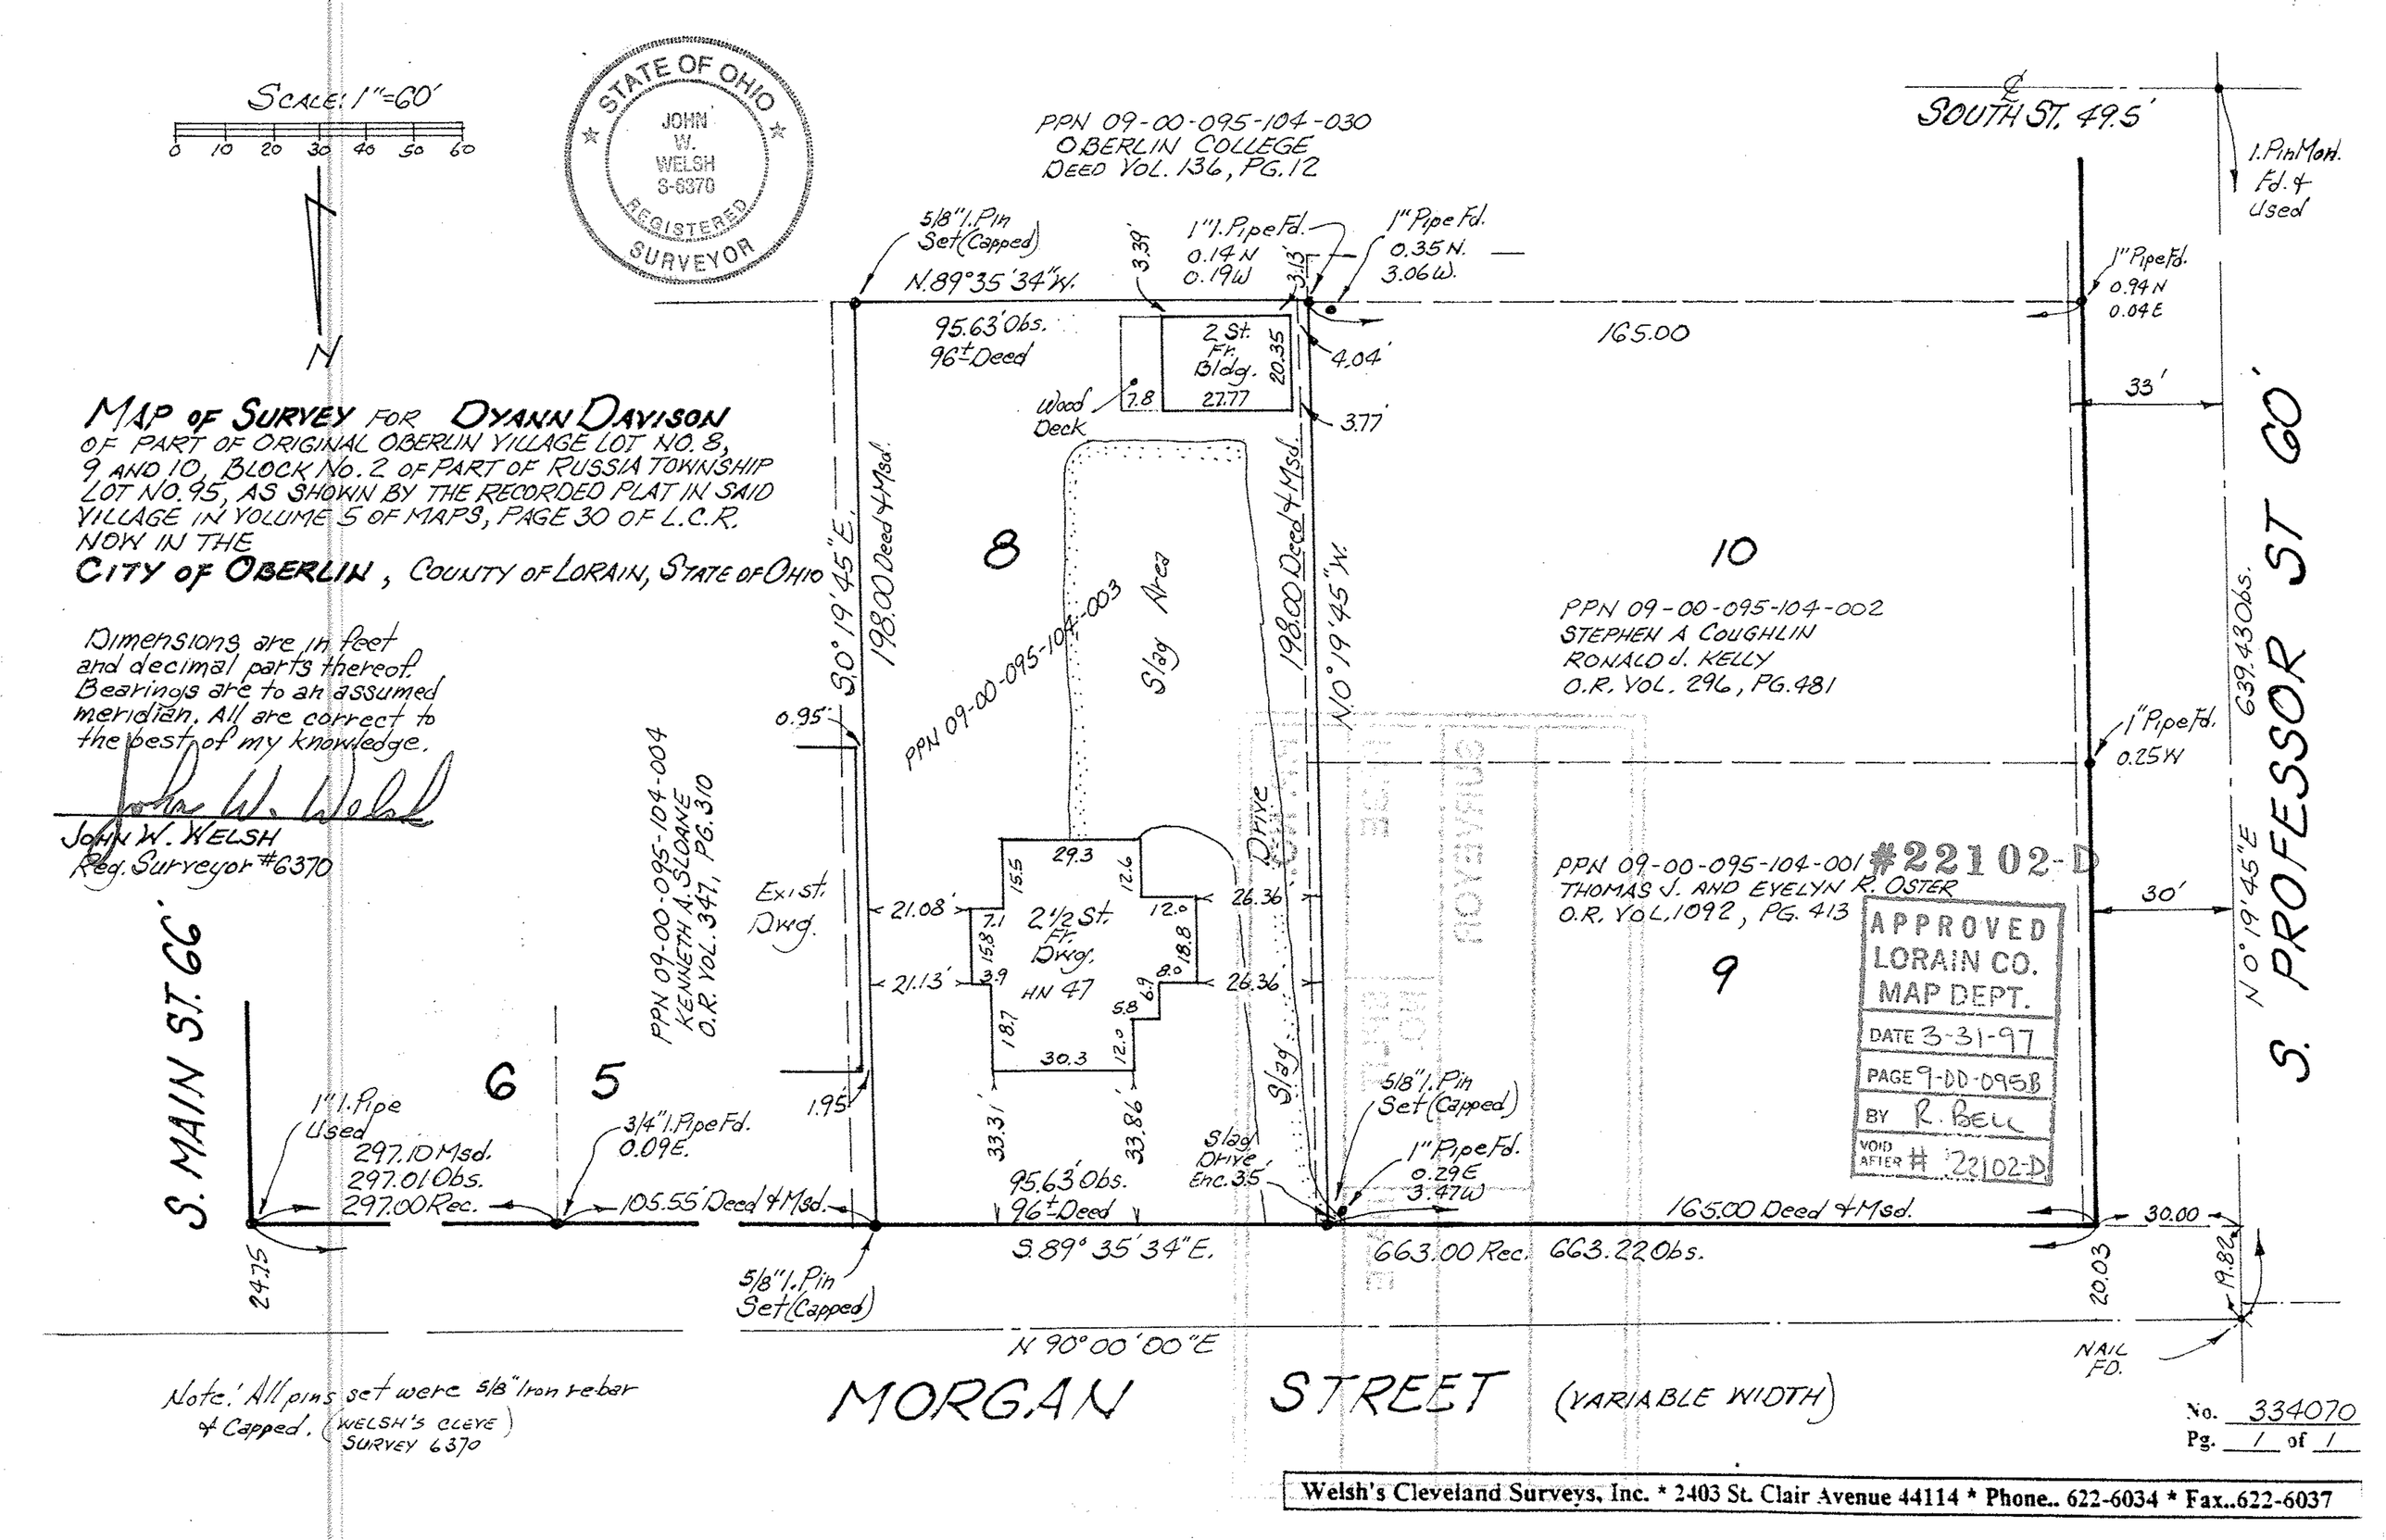

MAP OF SURVEY FOR OYANN DAVISON

OF PART OF ORIGINAL OBERLIN VILLAGE LOT NO. 8, 9 AND 10, BLOCK NO. 2 OF PART OF RUSSIA TOWNSHIP LOT NO. 95, AS SHOWN BY THE RECORDED PLAT IN SAID VILLAGE IN VOLUME 5 OF MAPS, PAGE 30 OF L.C.R. NOW IN THE **CITY OF OBERLIN**, COUNTY OF LORAIN, STATE OF OHIO

Dimensions are in feet and decimal parts thereof. Bearings are to an assumed meridian. All are correct to the best of my knowledge.

John W. Welsh

JOHN W. WELSH
Reg. Surveyor #6370

Note: All pins set were 5/8" iron rebar & Capped. (WELSH'S CLEVE SURVEY 6370)

No. 334070
Pg. 1 of 1

Welsh's Cleveland Surveys, Inc. * 2403 St. Clair Avenue 44114 * Phone.. 622-6034 * Fax..622-6037