CASE NUMBER 80755

PROPERTY TO BE CONVEYED
BY
ROBERT W. BLANCHETTE, ET AL TRUSTEES
FOR THE PROPERTY OF PENN CENTRAL
TRANSPORTATION COMPANY
TO
ARTHUR H. CLARK

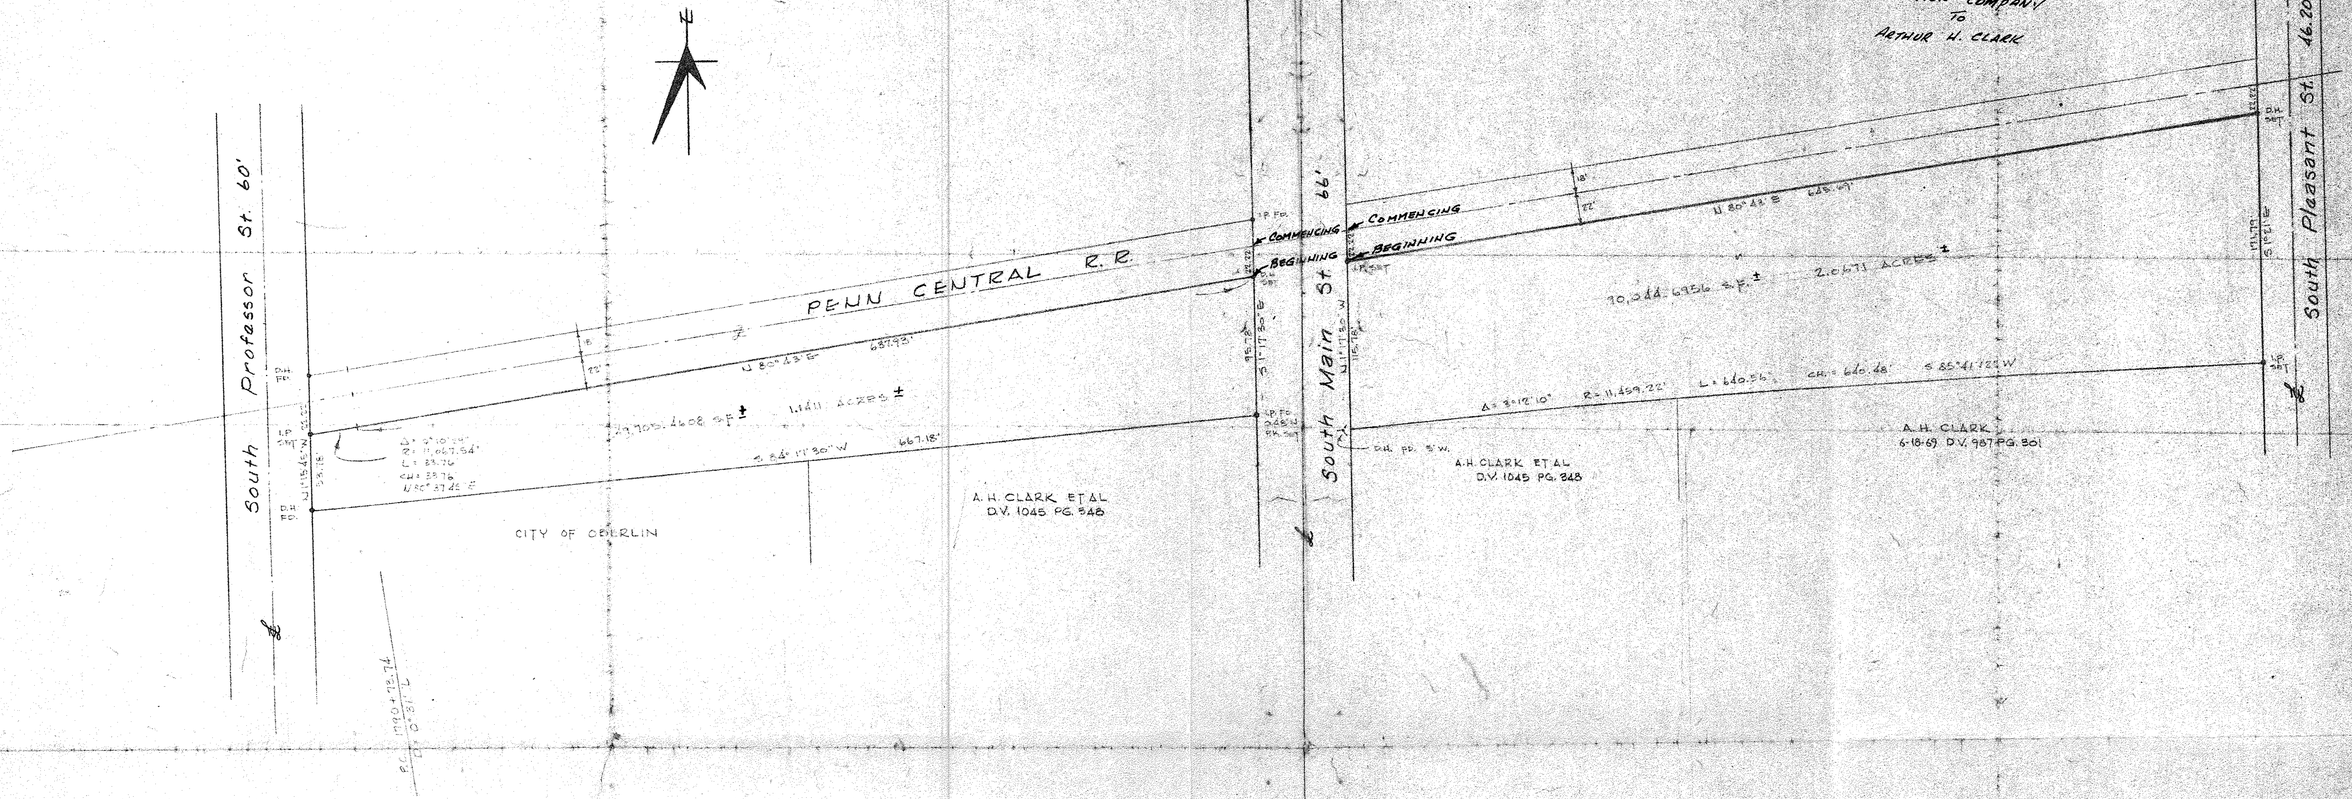

SURVEY FOR A. H. CLARK

PART OF O.L. 95 & O.L. 96 RUSSIA TOWNSHIP
CITY OF OBERLIN LORAIN COUNTY OHIO
SCALE 1" = 50' SEPTEMBER, 1977
LAUNDON · SIMON · CAHL & ASSOC. ENGINEERS · SURVEYORS
Job No. 77-648
F.B. 202 P. 23