10-00-001-102-032 10-00-001-C

MAP OF PART OF ORIGINAL SECTION NO. 1
CARLISLE TOWNSHIP
Scan # 46407

LORAIN COUNTY OHIO

SCALE: 1" = 30' AUGUST 1-1970 4:30 P.M.

NOTE: There are no encroachments on this property.

Gary E. Penfound REG. SURVEYOR NO. 4457

CITY TITLE Co. Order No. E-1239-40
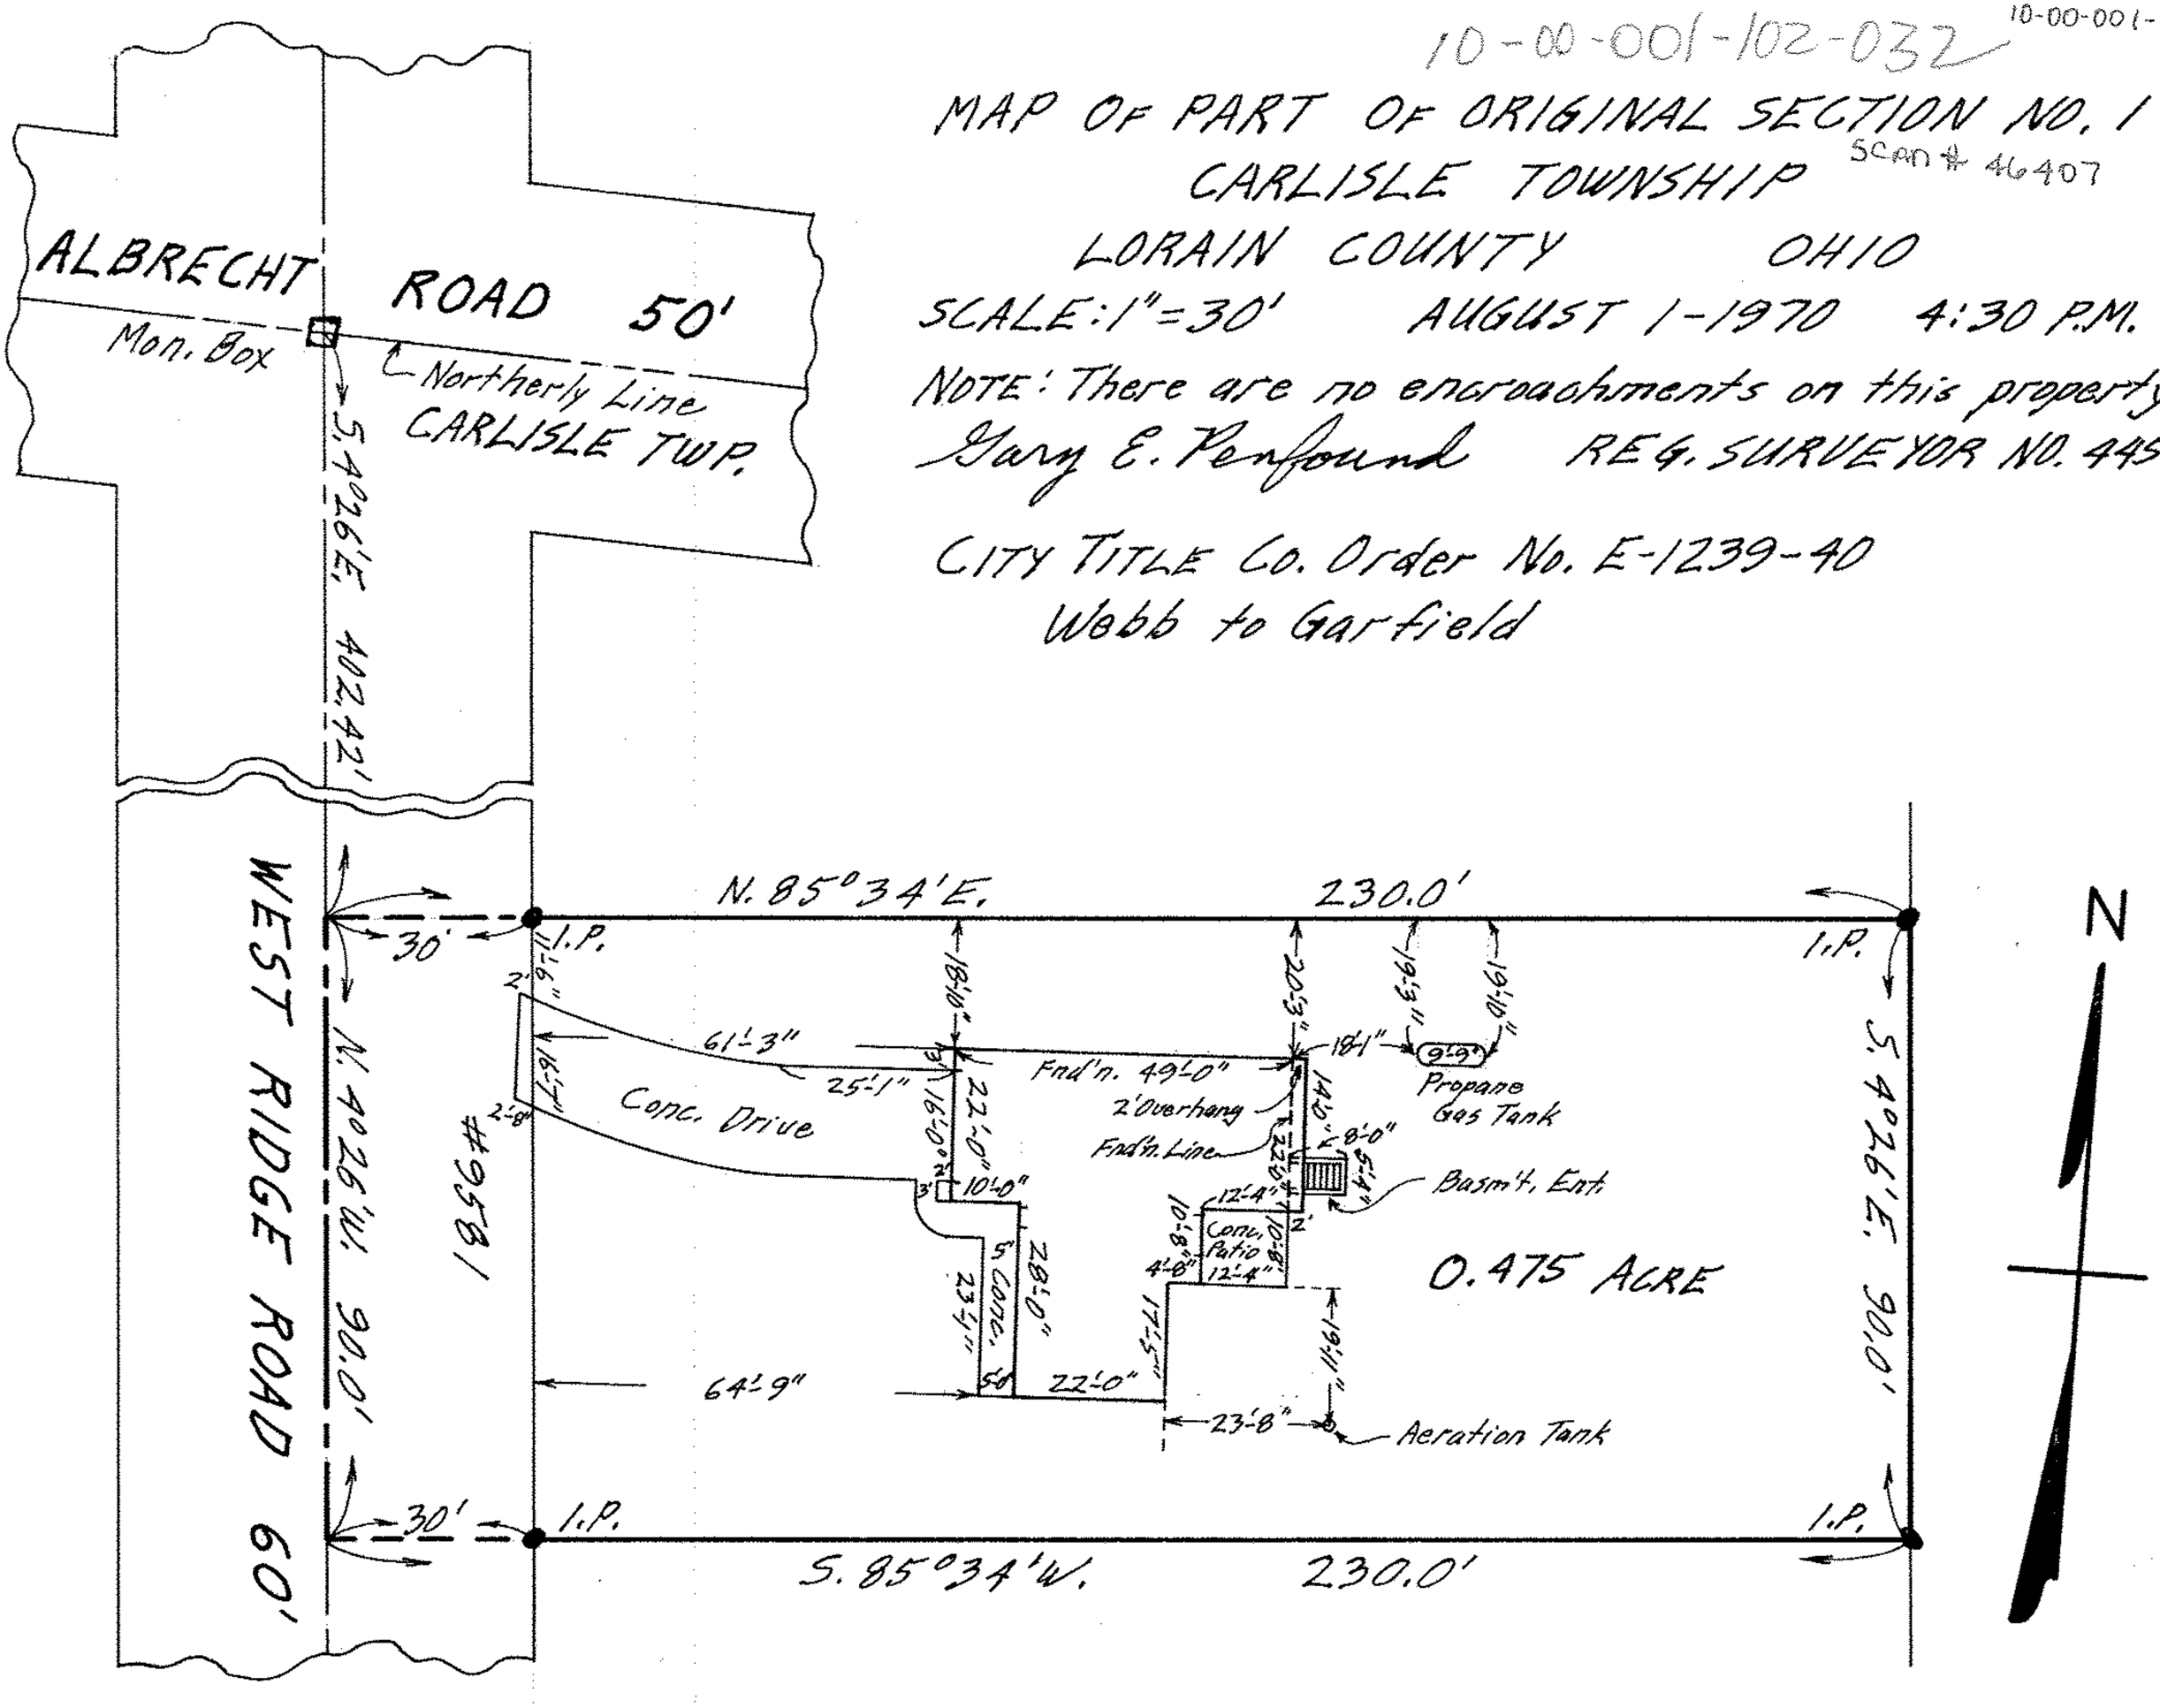
Webb to Garfield