

# KLEINOEDER-SCHMIDT

and ASSOCIATES

ENGINEERS — SURVEYORS — CONSULTANTS IN LAND PLANNING

ELYRIA • NORWALK • MEDINA

OHIO

# SURVEY

9843

Sublot(s)

Subd'n

Tract

Sec. 2

State of Ohio

10B


Township CARLISLE

Orig. Lot(s)

LORAIN

County of

Corporation

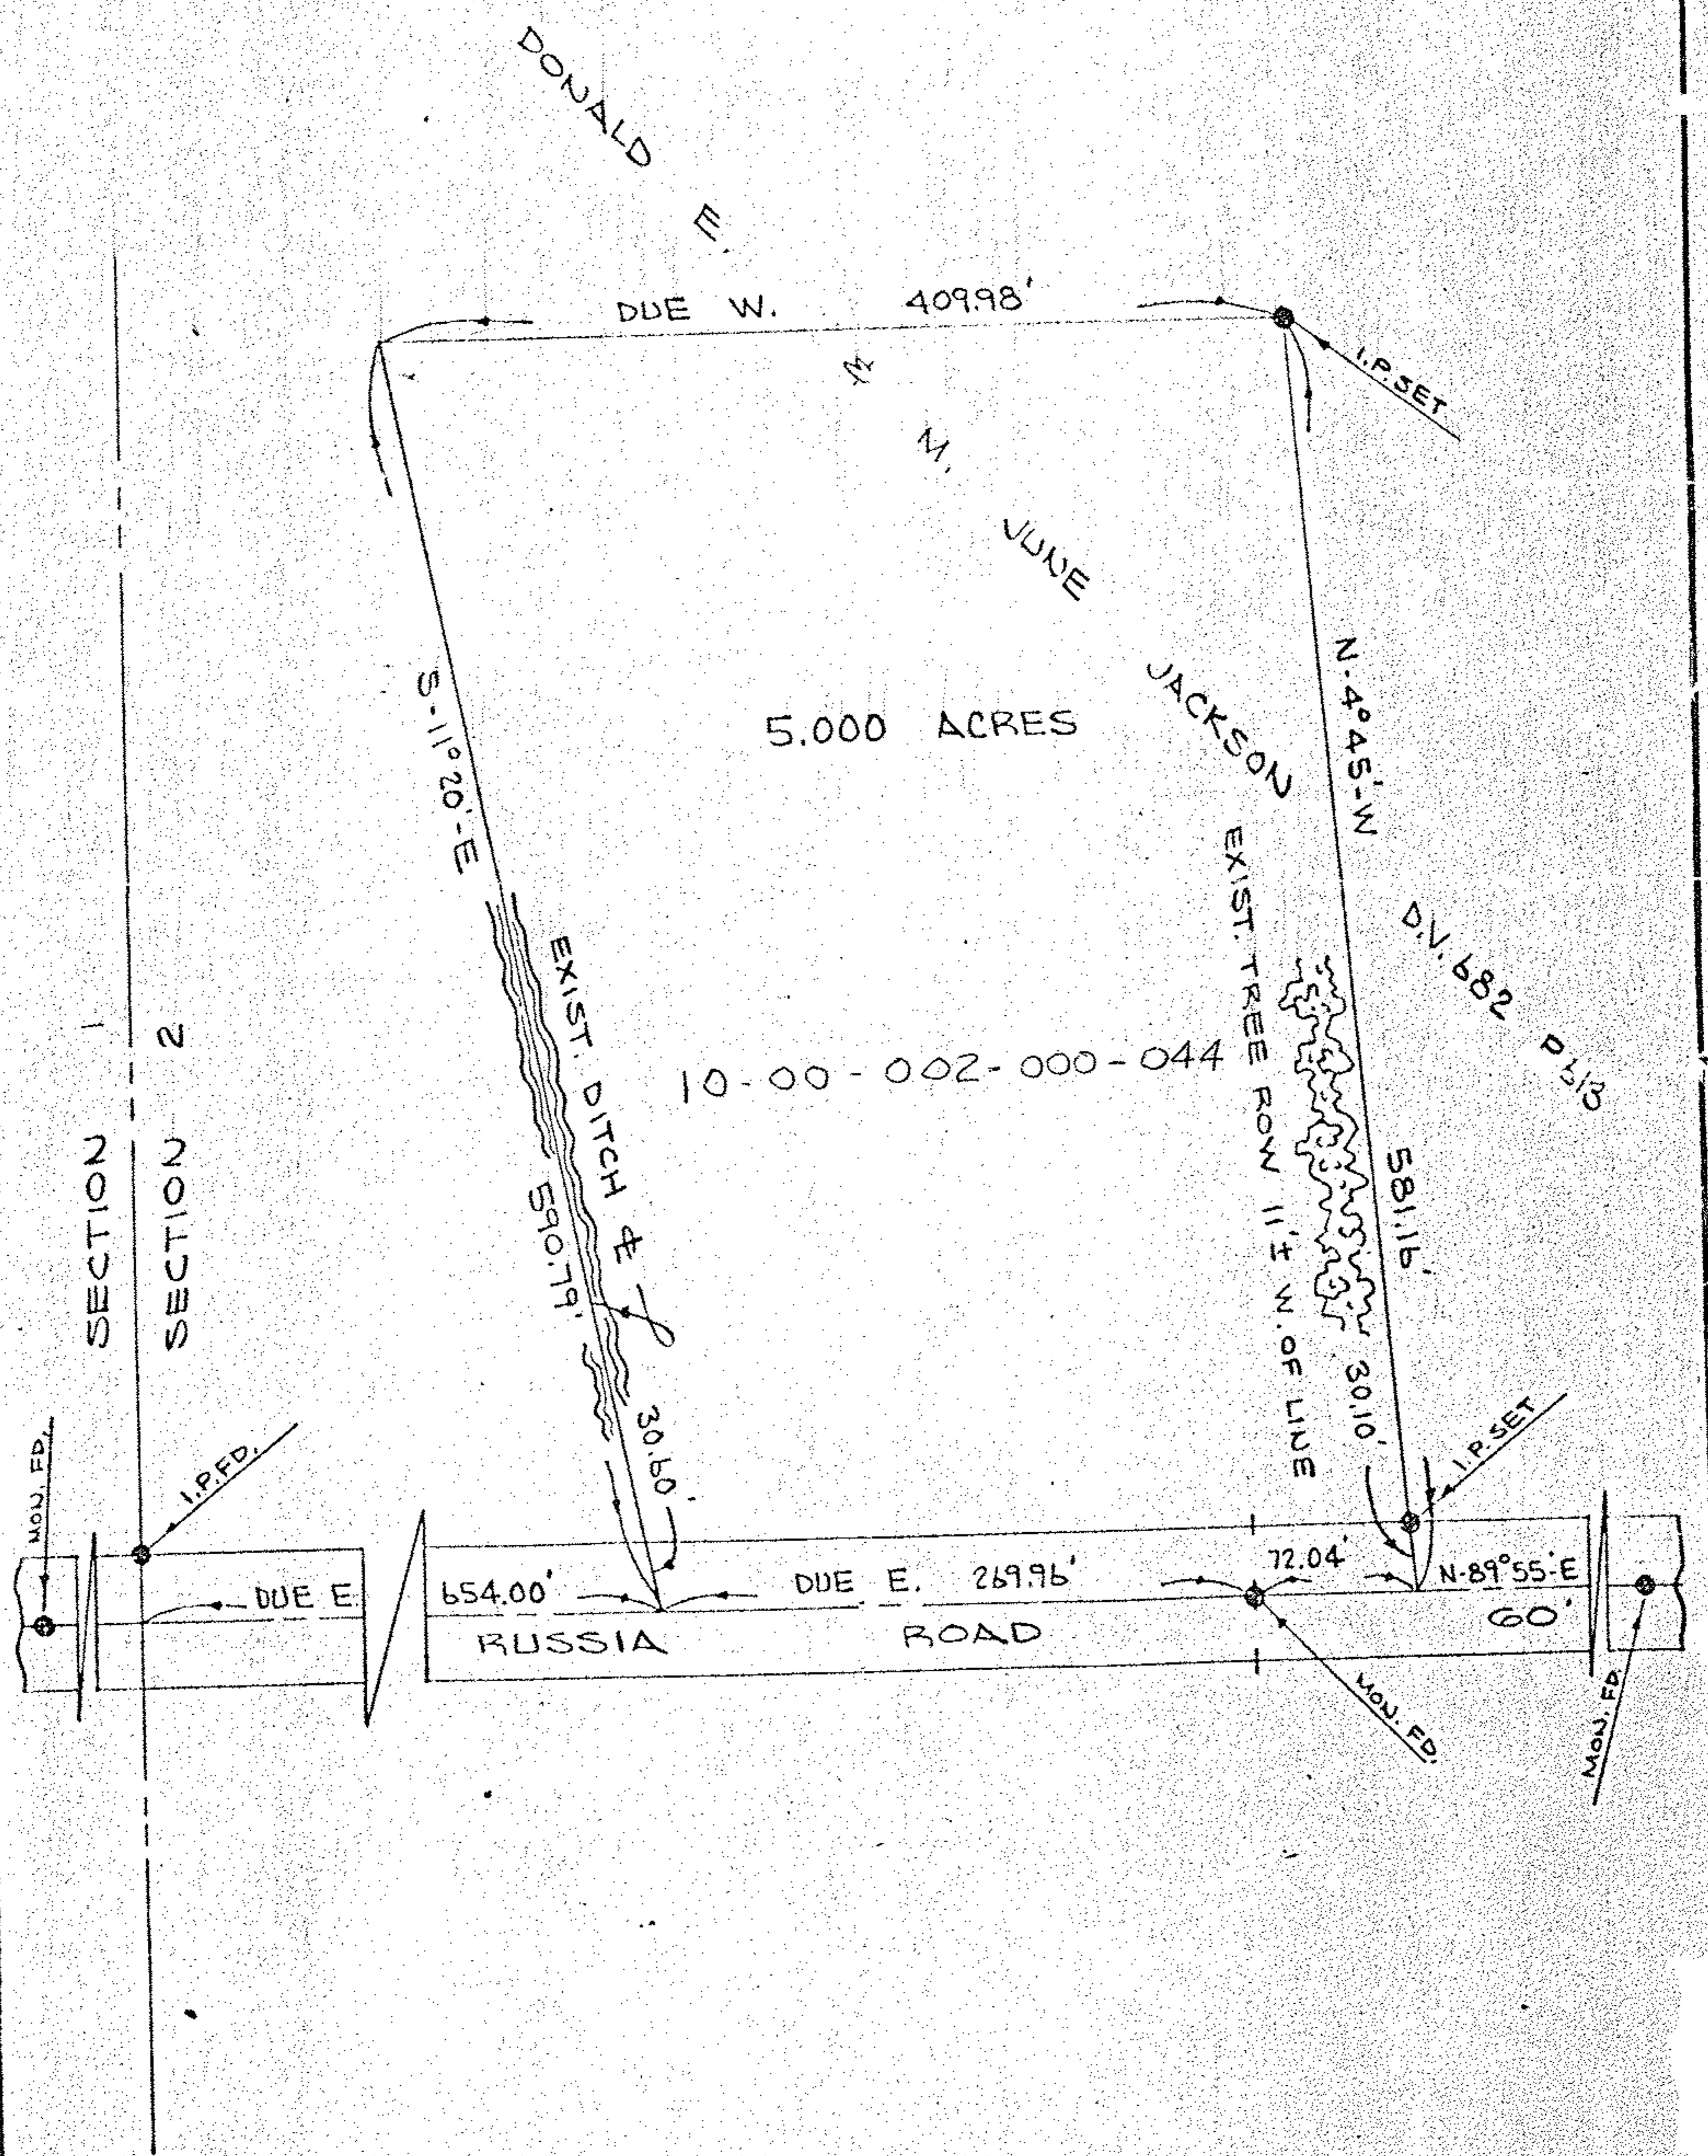

Prepared for:

DONALD JACKSON