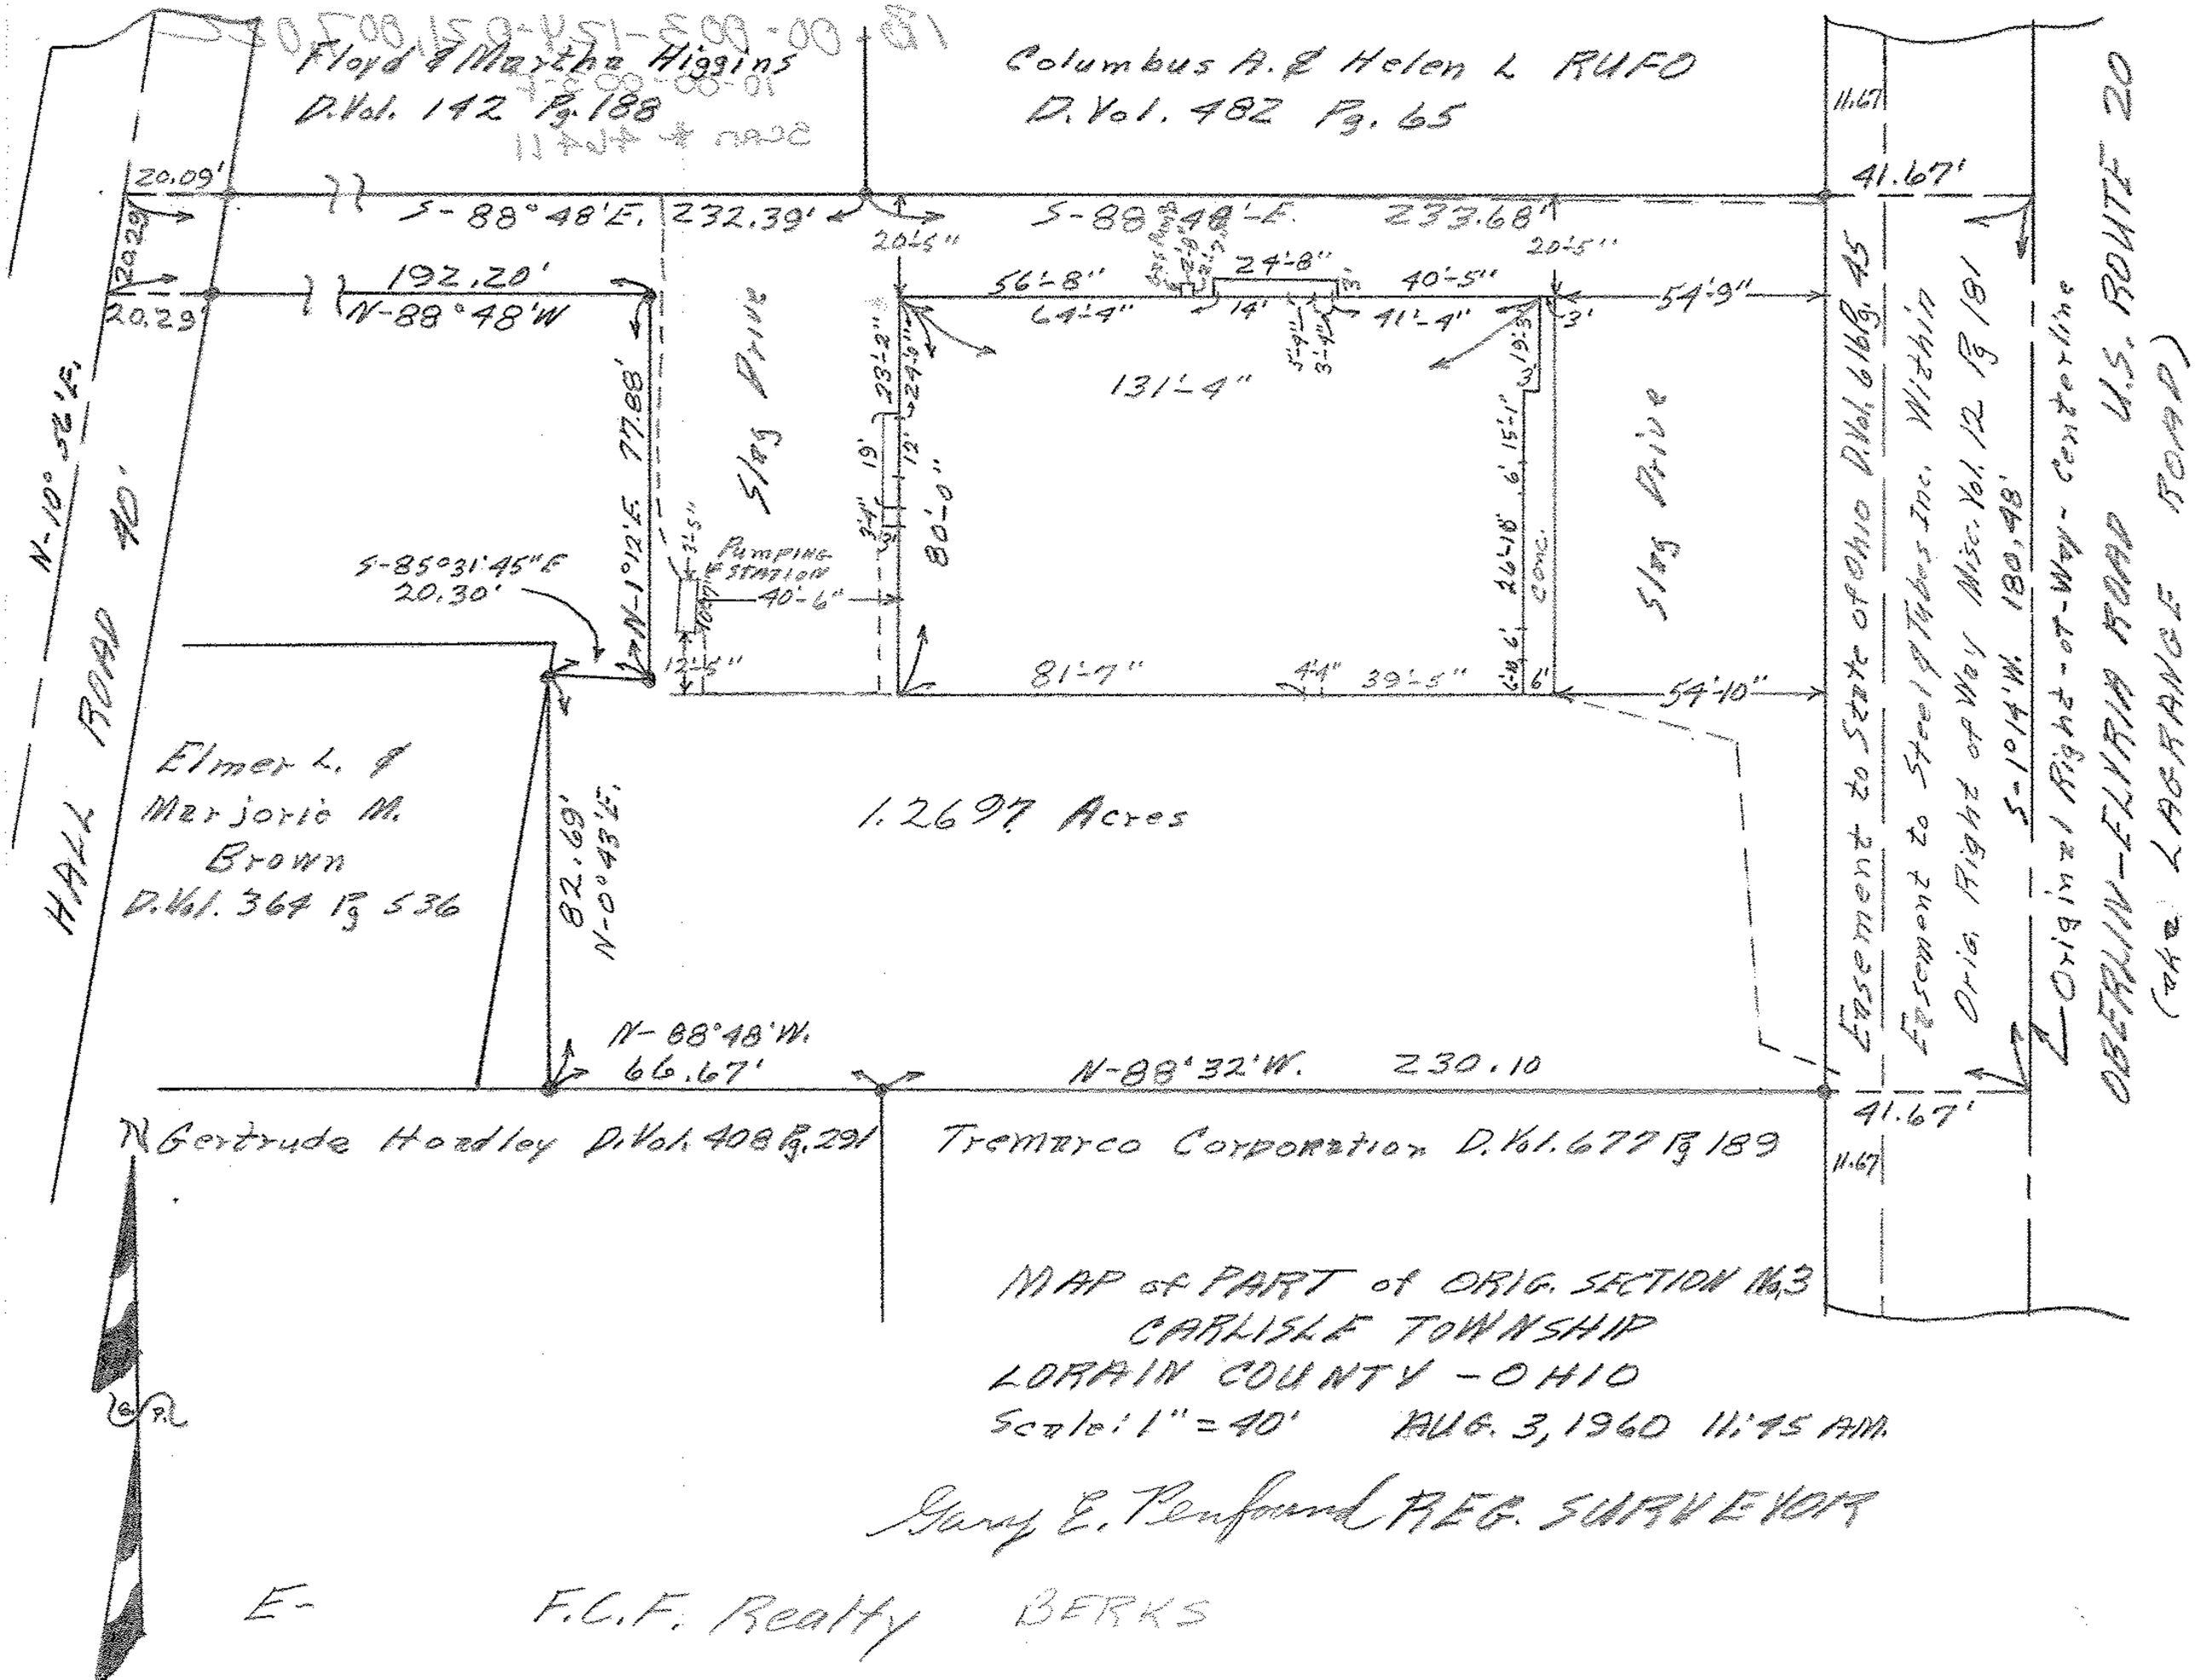
Floyd & Martha Higgins
D.Vol. 142 Pg. 188
Columbus A. & Helen L RUFO
D.Vol. 482 Pg. 65
20.09'
S-88°48'E. 232.39'
S-88°48'E. 233.68'
41.67'
11.67
20.29
192.20'
N-88°48'W
20.29
56'-8"
24'-8"
40'-5"
54'-9"
64'-4"
14'
41'-4"
3'
131'-4"
Slag Drive
Slag Drive
N-10°52'E.
77.88'
N-1°12'E.
80'-0"
Pumping Station
40'-6"
S-85°31'45"E
20.30'
12'-5"
81'-7"
39'-5"
54'-10"
Conc.
Elmer L. &
Marjorie M.
Brown
D.Vol. 364 Pg 536
82.69'
N-0°43'E.
1.2697 Acres
N-88°48'W.
66.67'
N-88°32'W. 230.10
41.67'
11.67
Gertrude Hoadley D.Vol. 408 Pg. 291
Tremarco Corporation D.Vol. 677 Pg 189
HALL ROAD 40'
Easement to State of Ohio D.Vol. 616 Pg. 45
Easement to Steel & Tubes Inc. Within
Orig. Right of Way Misc. Vol. 12 Pg 181
S-1°14'W. 180.48'
Original Right-of-Way-Centerline
OBERLIN-ELYRIA ROAD U.S. ROUTE 20
(aka LAGRANGE ROAD)
N
MAP of PART of ORIG. SECTION No. 3
CARLISLE TOWNSHIP
LORAIN COUNTY - OHIO
Scale: 1" = 40' AUG. 3, 1960 11:45 AM.
Gary E. Penfound REG. SURVEYOR
E-
F.C.F. Realty BERKS