10-00-004-101-106
10-00-004-A
Scan # 46417

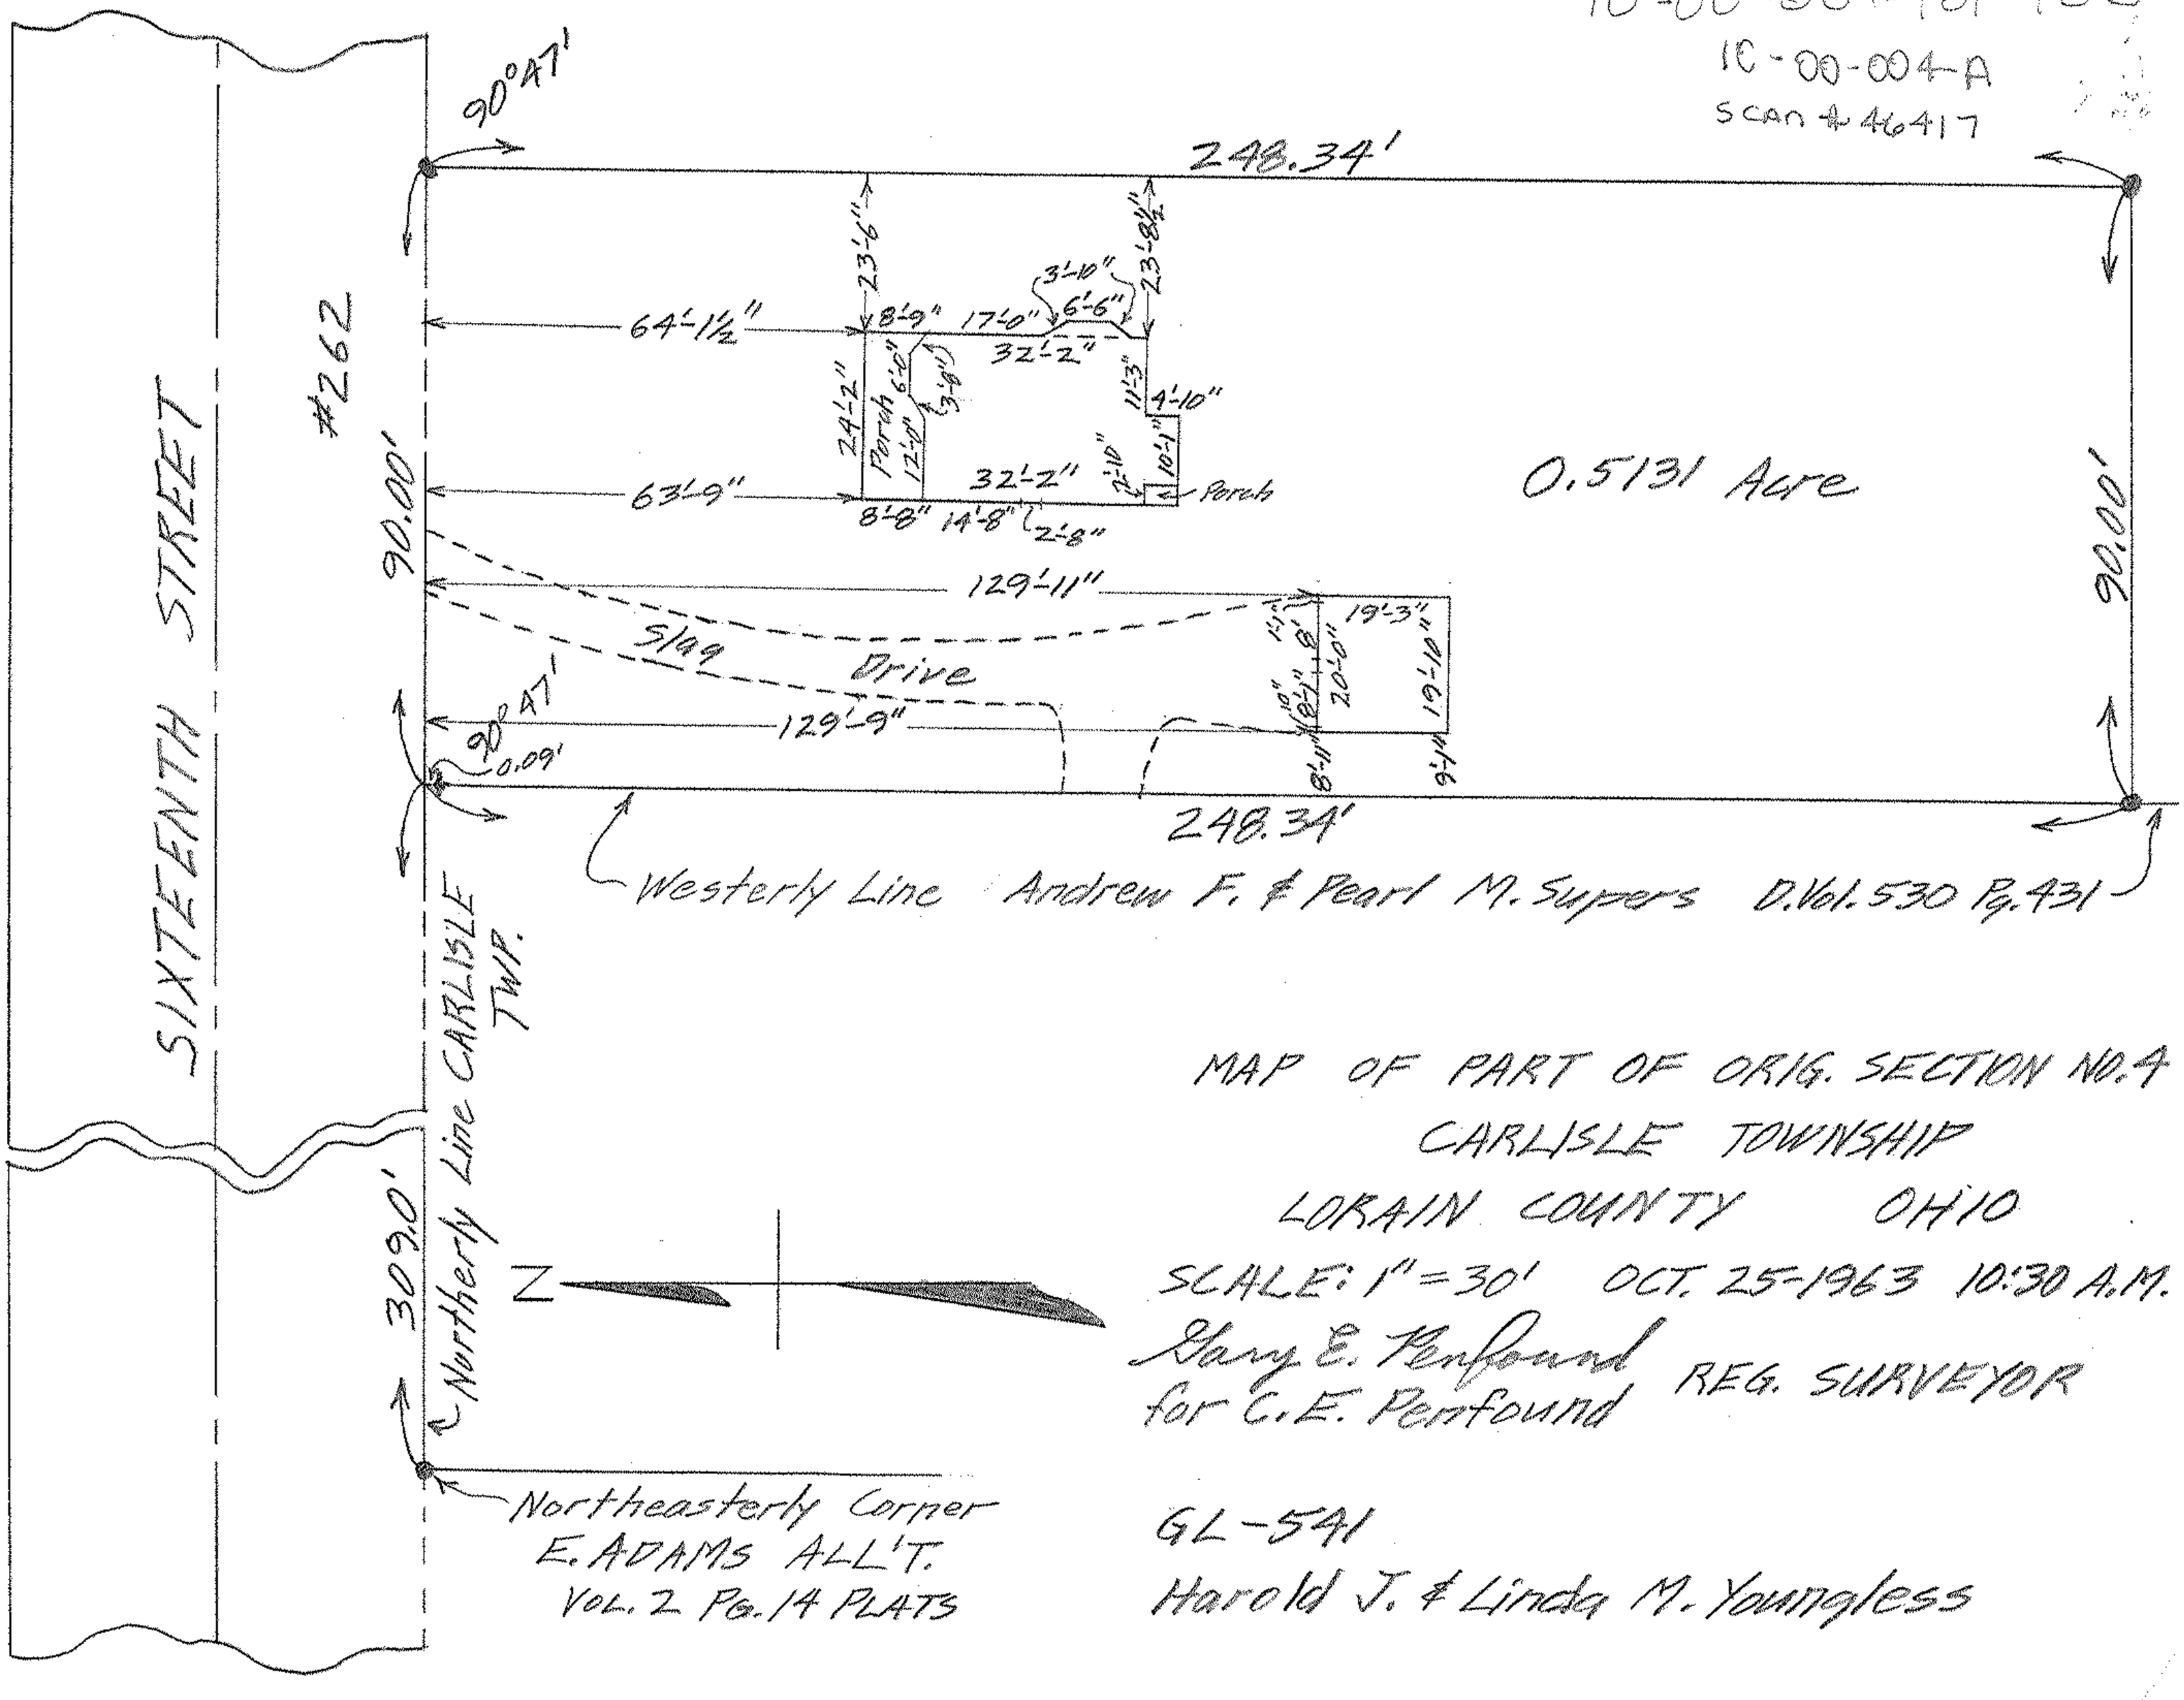

MAP OF PART OF ORIG. SECTION NO. 4
CARLISLE TOWNSHIP
LORAIN COUNTY OHIO
SCALE: 1" = 30' OCT. 25-1963 10:30 A.M.
Gary E. Penfound
for C.E. Penfound REG. SURVEYOR

GL-541
Harold J. & Linda M. Youngless