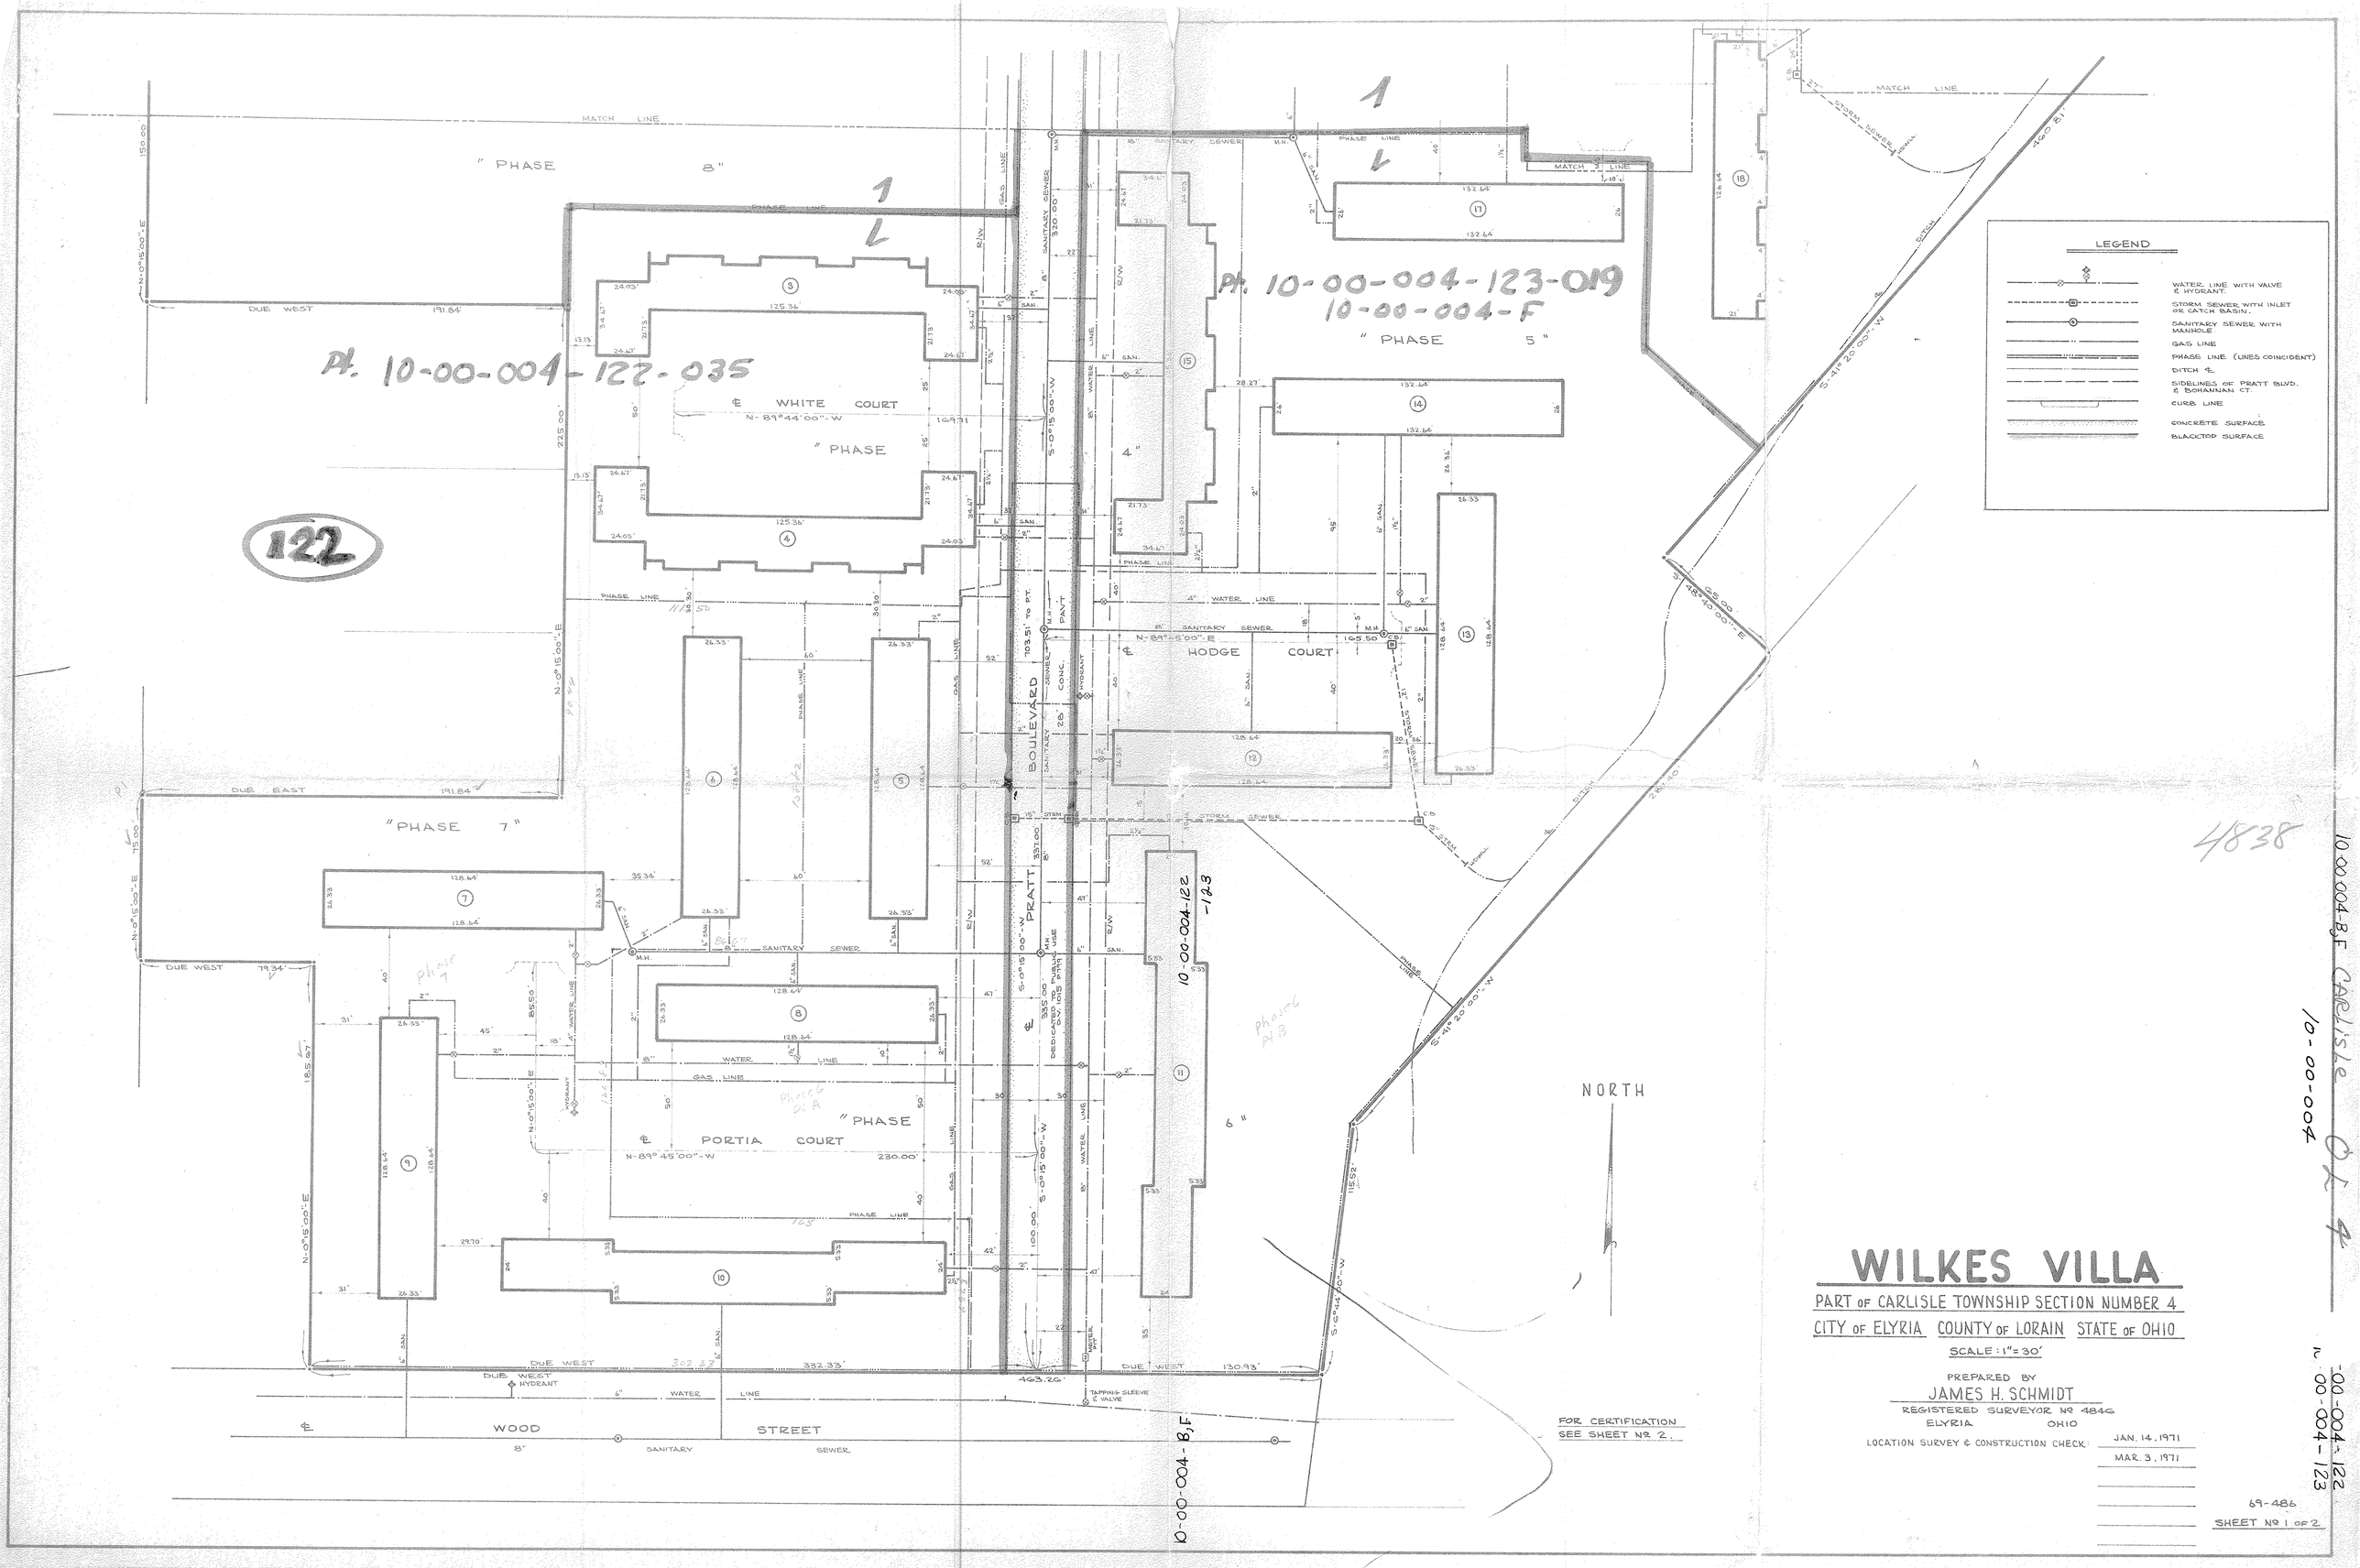

WILKES VILLA

PART OF CARLISLE TOWNSHIP SECTION NUMBER 4

CITY OF ELYRIA COUNTY OF LORAIN STATE OF OHIO

SCALE: 1" = 30'

PREPARED BY

JAMES H. SCHMIDT

REGISTERED SURVEYOR Nº 4846

ELYRIA OHIO

LOCATION SURVEY & CONSTRUCTION CHECK: JAN. 14, 1971

MAR. 3, 1971

69-486

SHEET Nº 1 OF 2.

4838

10-00-004-B,F (Carlisle Sec 4)

10-00-004

-00-004-122

10-00-004-123