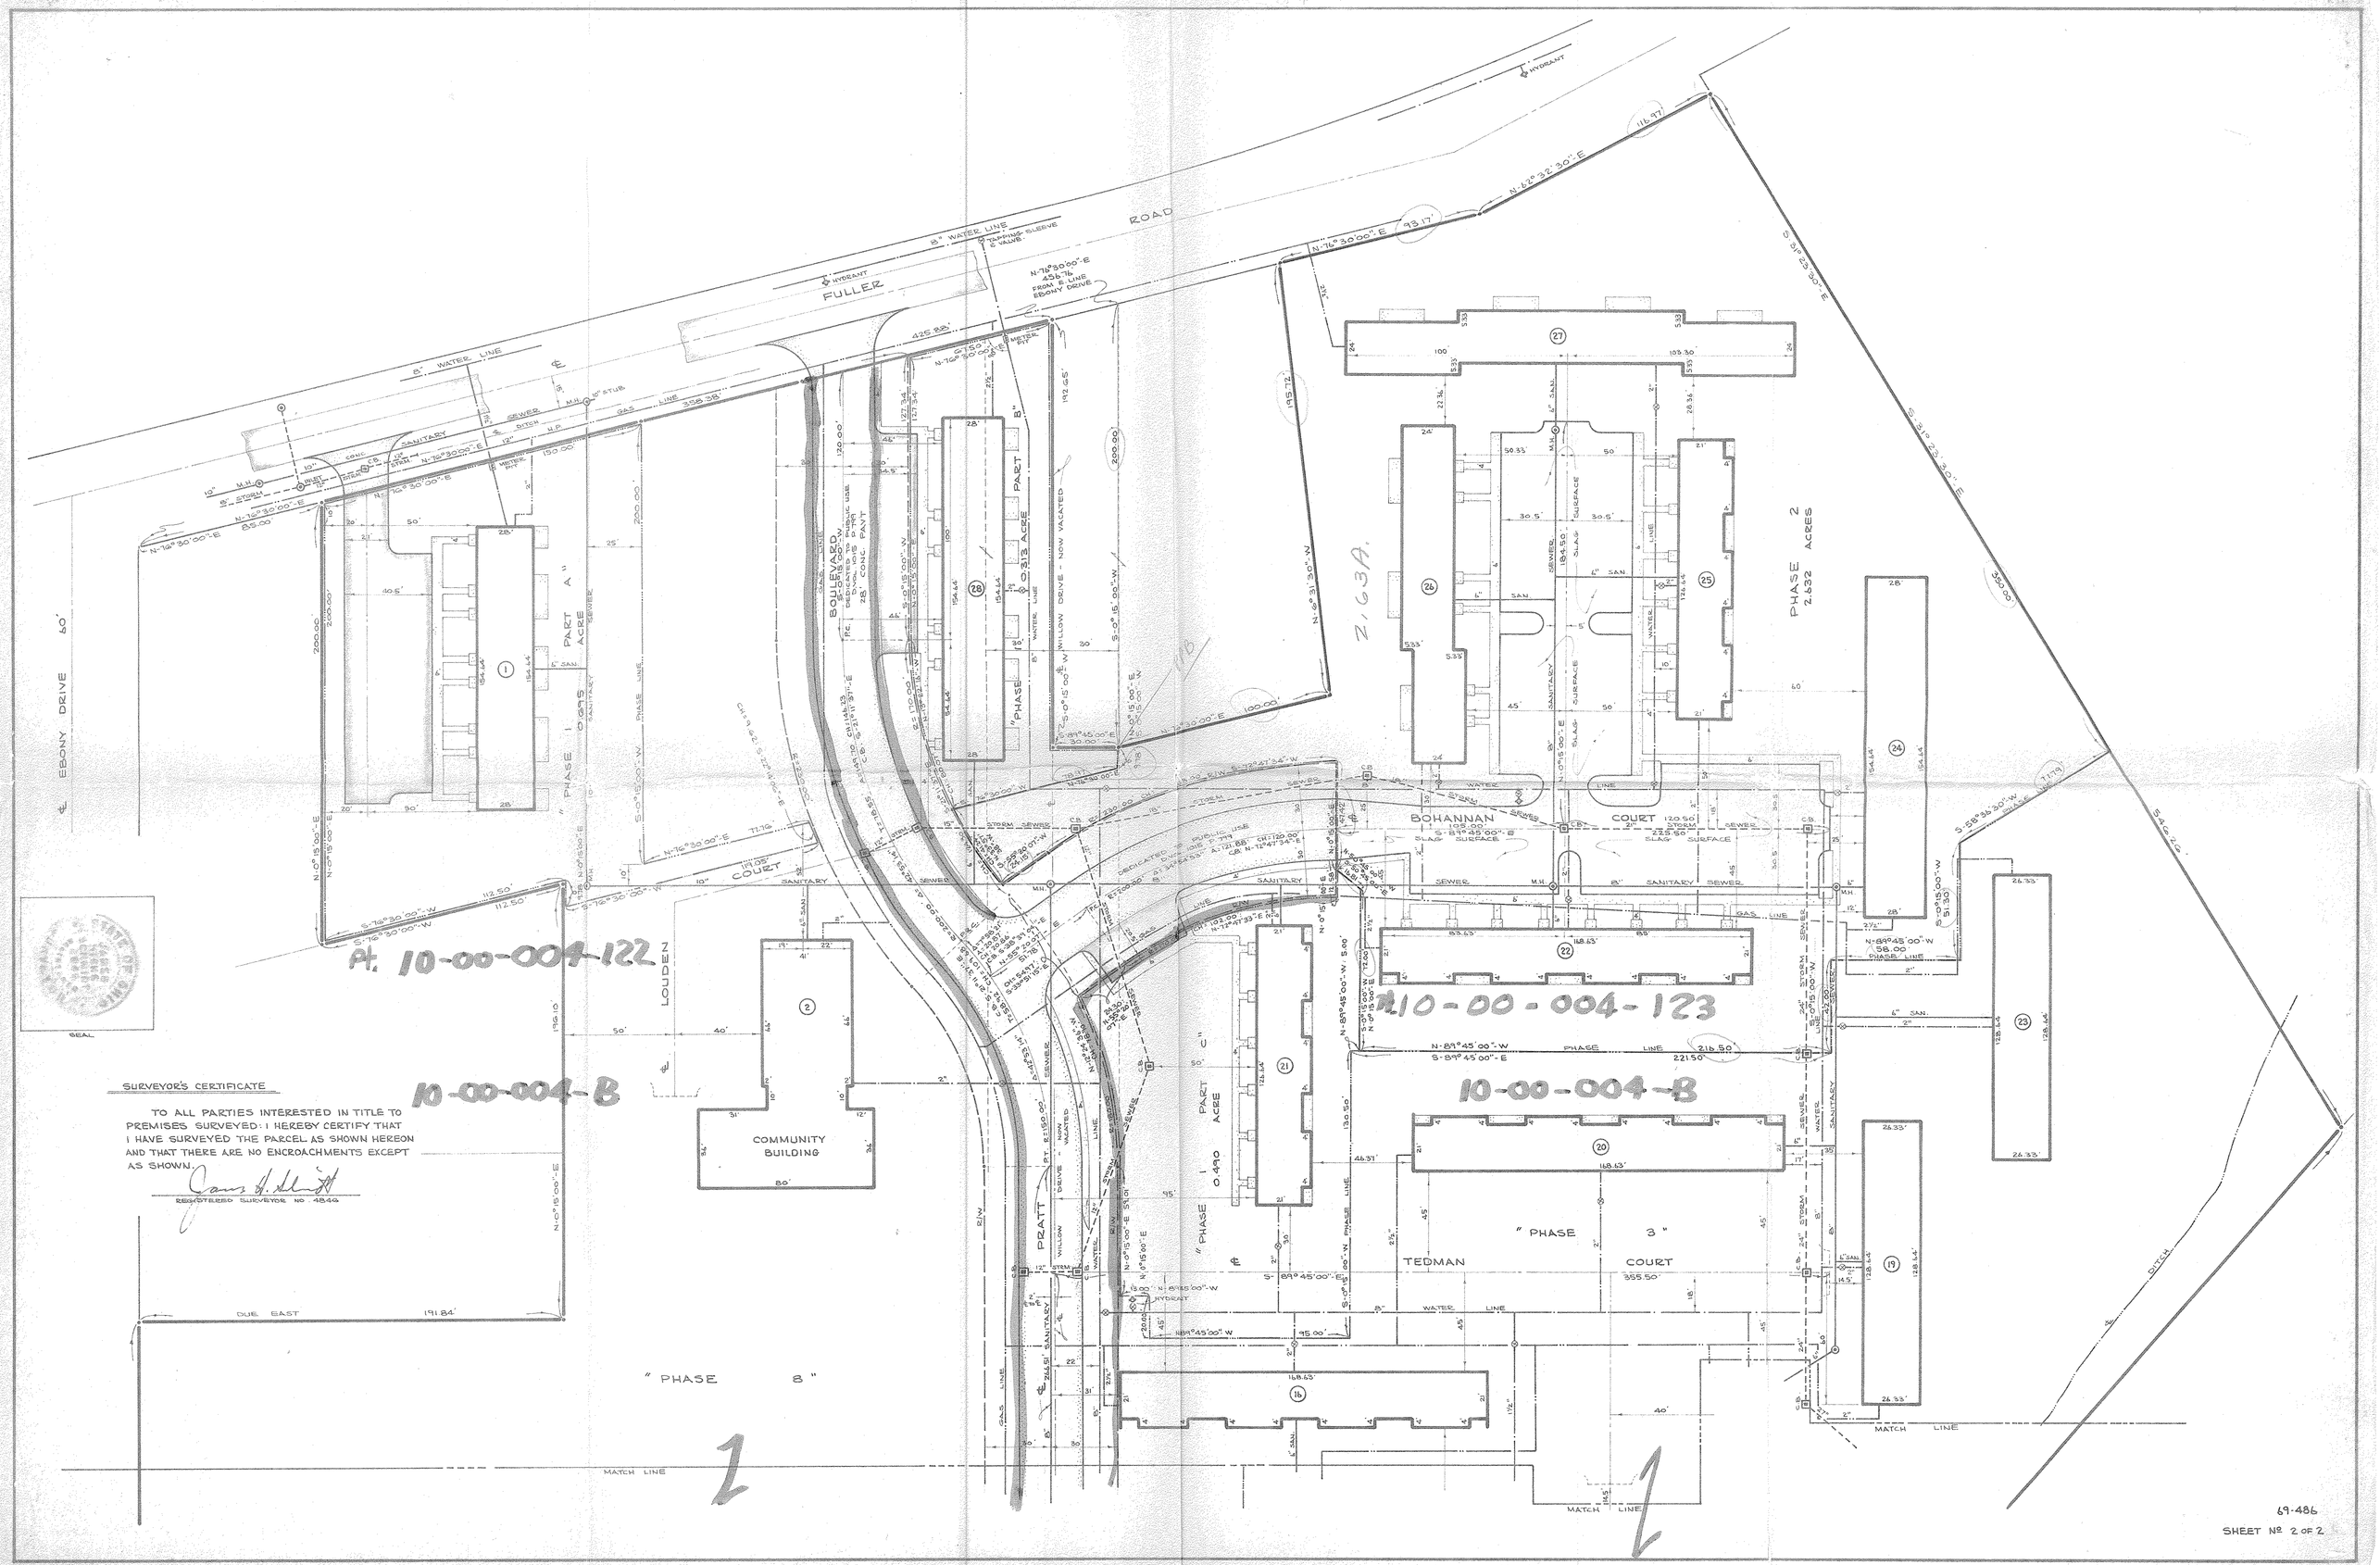
FULLER ROAD
EBONY DRIVE
LOUDEN COURT
PRATT BOULEVARD
WILLOW DRIVE - NOW VACATED
BOHANNAN COURT
TEDMAN COURT
"PHASE 1" 0.635 ACRE
"PHASE 1" 0.490 ACRE
"PHASE 2" 2.632 ACRES
"PHASE 3"
"PHASE 8"
COMMUNITY BUILDING
Z-63A.
Pt. 10-00-004-122
10-00-004-123
10-00-004-B
SURVEYOR'S CERTIFICATE
TO ALL PARTIES INTERESTED IN TITLE TO PREMISES SURVEYED: I HEREBY CERTIFY THAT I HAVE SURVEYED THE PARCEL AS SHOWN HEREON AND THAT THERE ARE NO ENCROACHMENTS EXCEPT AS SHOWN.
REGISTERED SURVEYOR NO. 4846
SEAL
MATCH LINE
DITCH
69-486
SHEET Nº 2 OF 2