
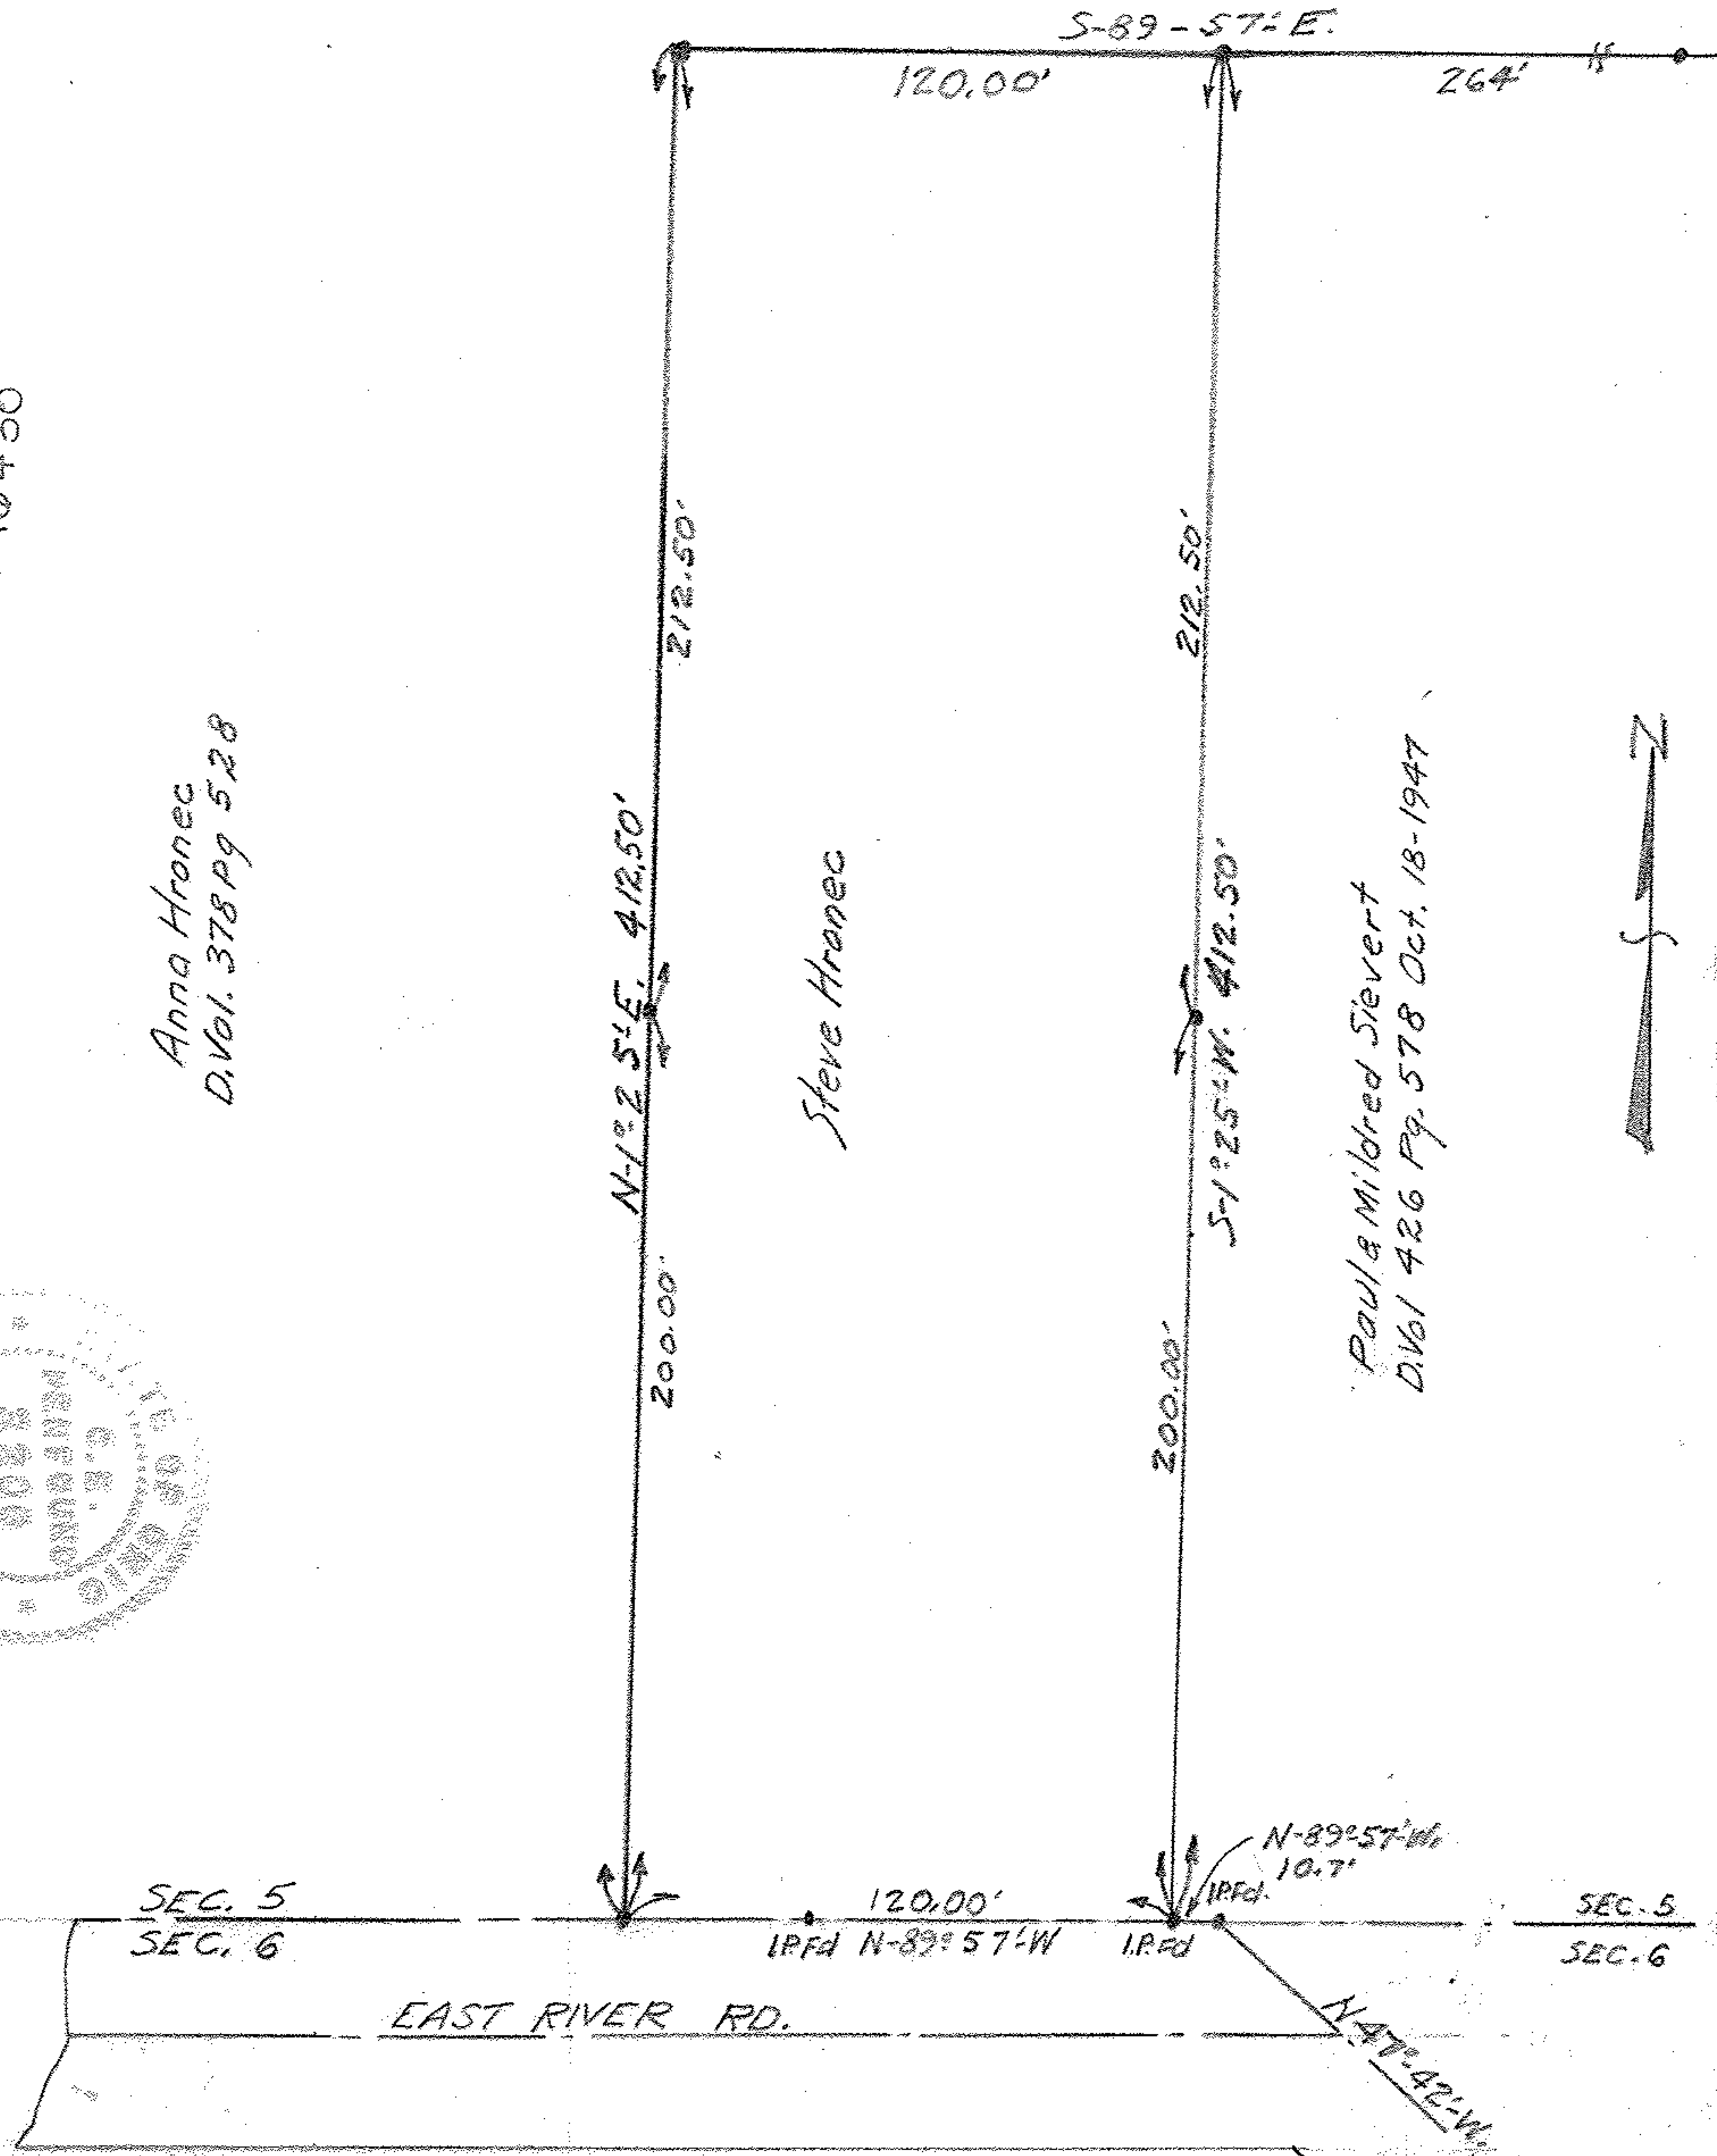


10-00-005-107-059
10-00-005-H
Scan # 46430

Anna Hronec
D. Vol. 378 Pg 528

Steve Hronec

Paula & Mildred Sievert
D. Vol 426 Pg. 578 Oct. 18-1947

 

SEC. 5
SEC. 6

SEC. 5
SEC. 6

EAST RIVER RD.

MAP OF SURVEY FOR STEVE HRONEC
PART OF SECTION 5 CARLISLE TOWNSHIP,
LORAIN COUNTY OHIO

SCALE 1" = 30'
C.E. Perkowski

DEC. 3-1955
Registered Surveyor