10-00-007-105-007
10-00-007-F
scan# 46450

PLAT OF SURVEY FOR
ANTHONY & MARGARET FRABOTTA
SECTION 7 CARLISLE TOWNSHIP
LORAIN COUNTY OHIO
SCALE: 1" = 60' JUNE 9-1960
Gary E. Penfound REG. SURVEYOR
REVISED JUNE 16-1960

NOTE: ● indicates iron pin set unless otherwise designated.
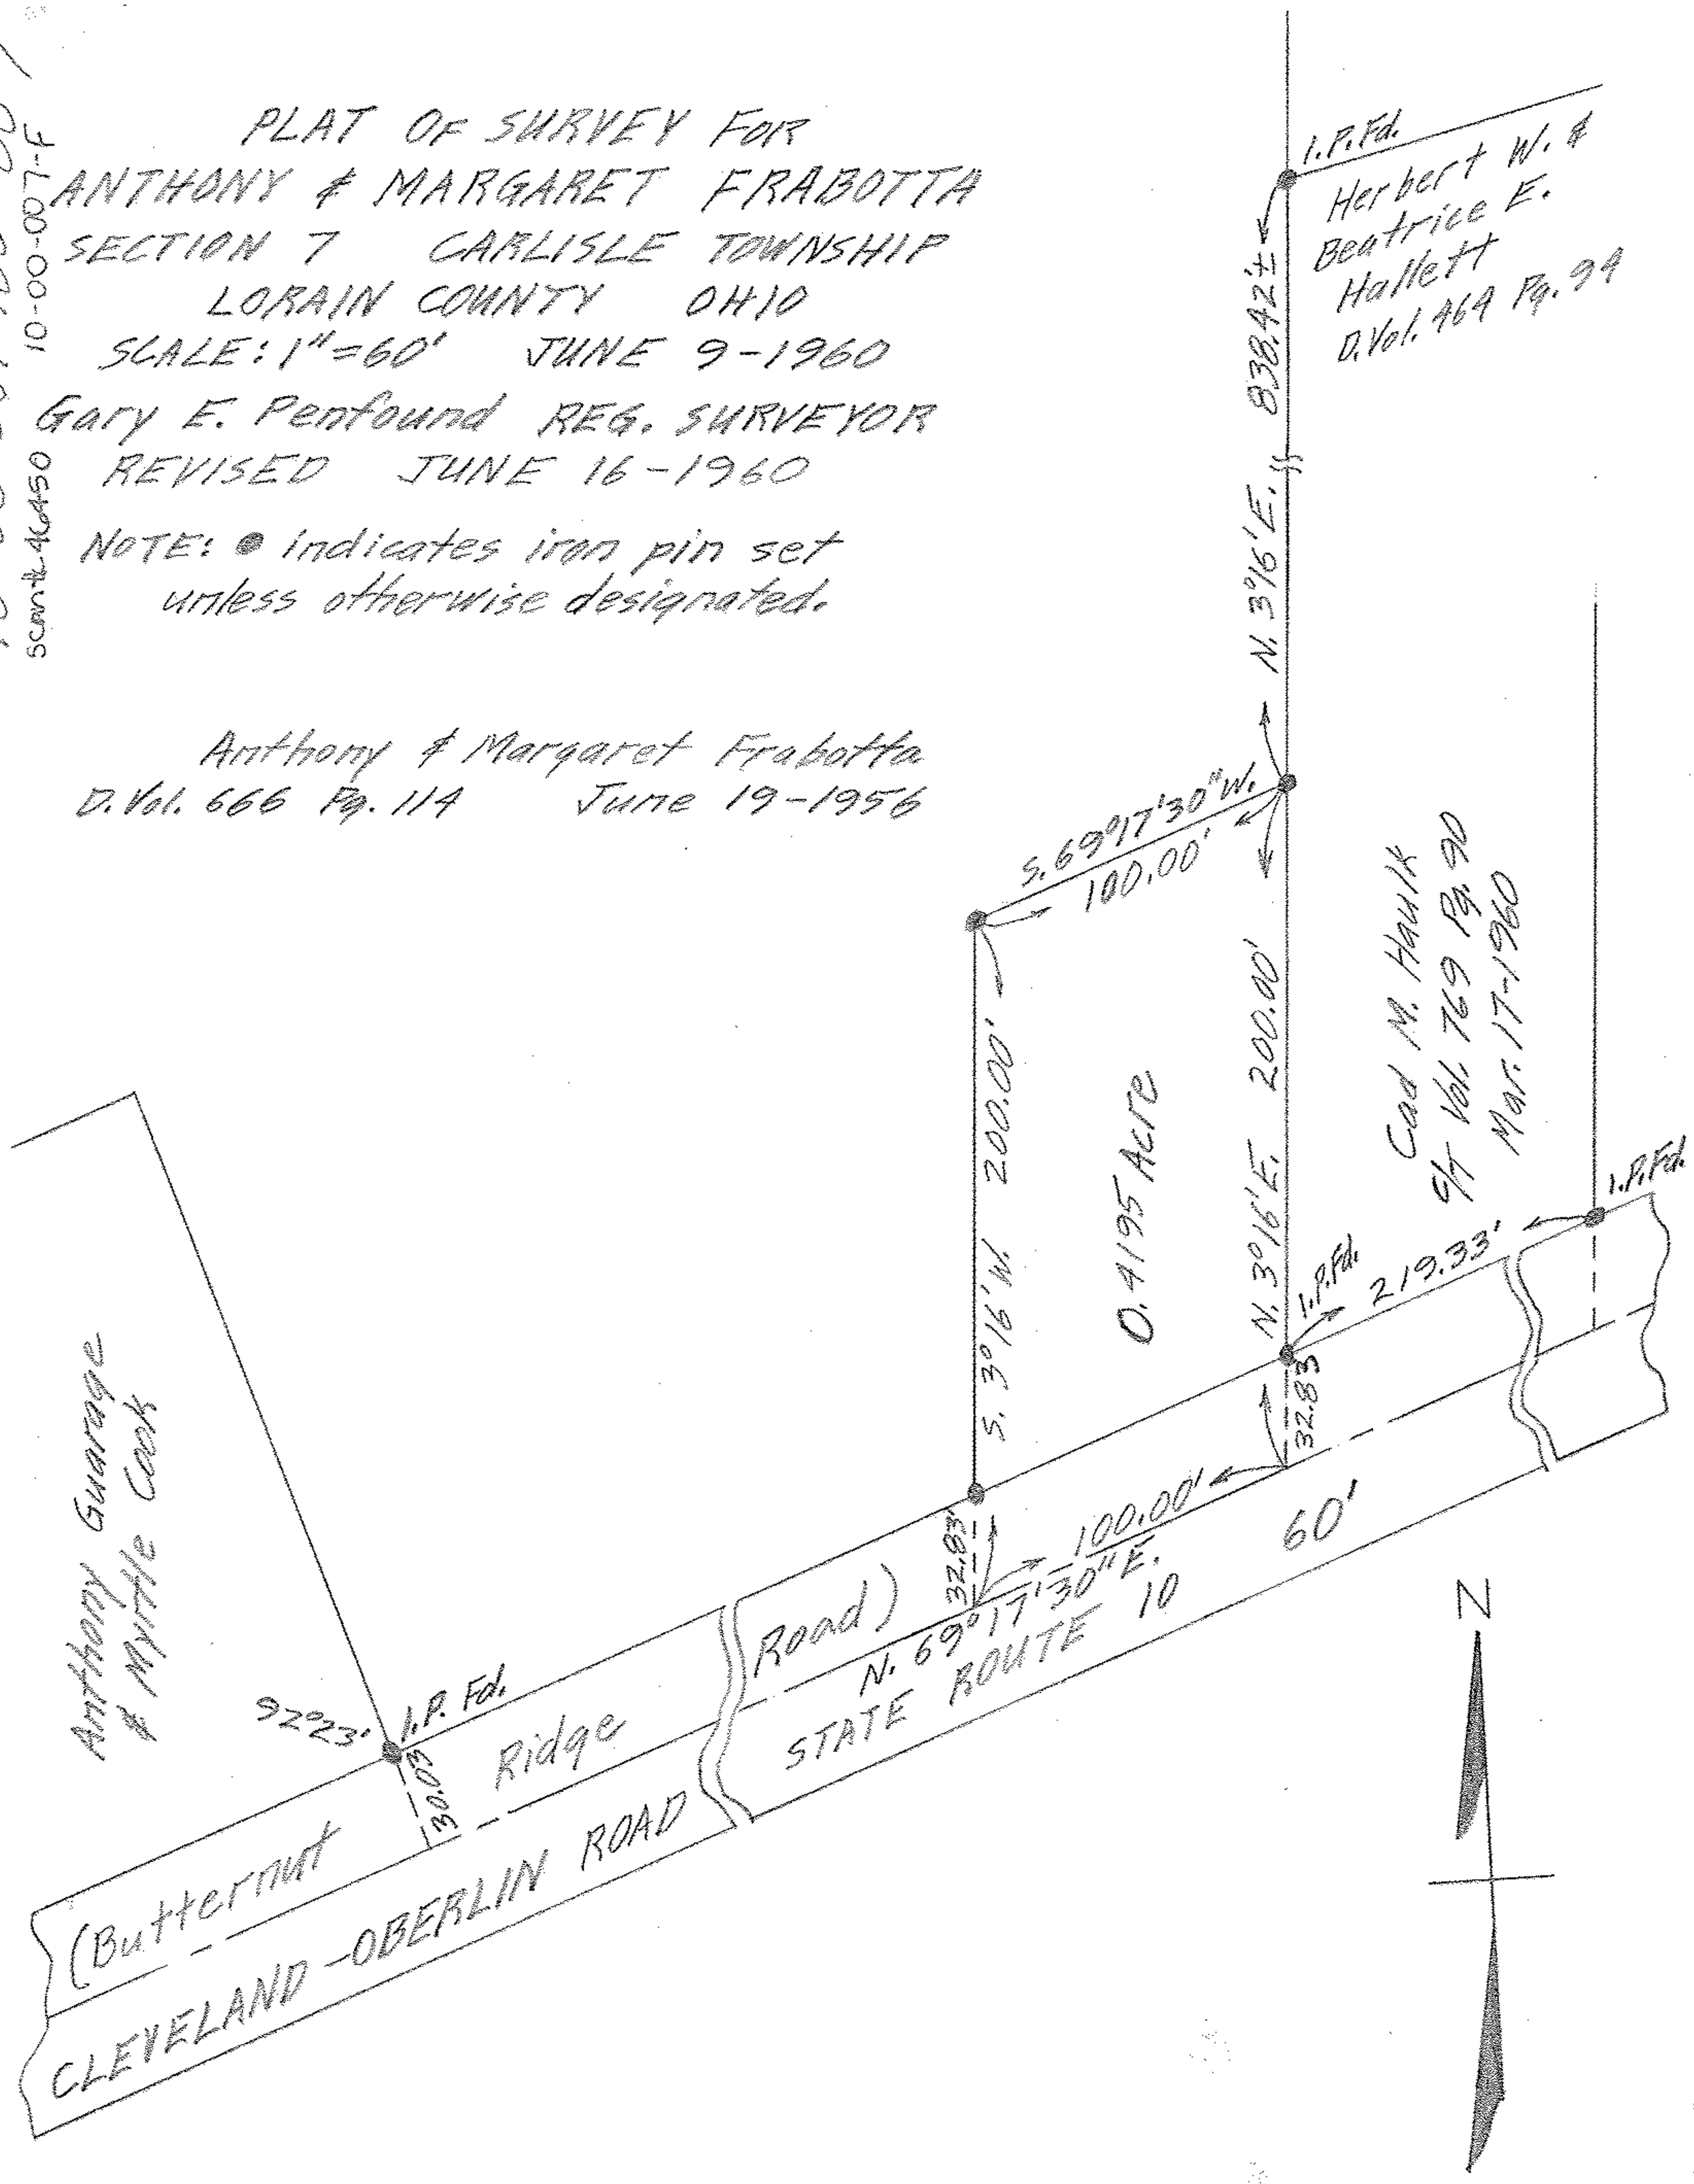
Anthony & Margaret Frabotta
D. Vol. 666 Pg. 114 June 19-1956