10-00-008-101-005
10-00-008-A
SCAN # 46454

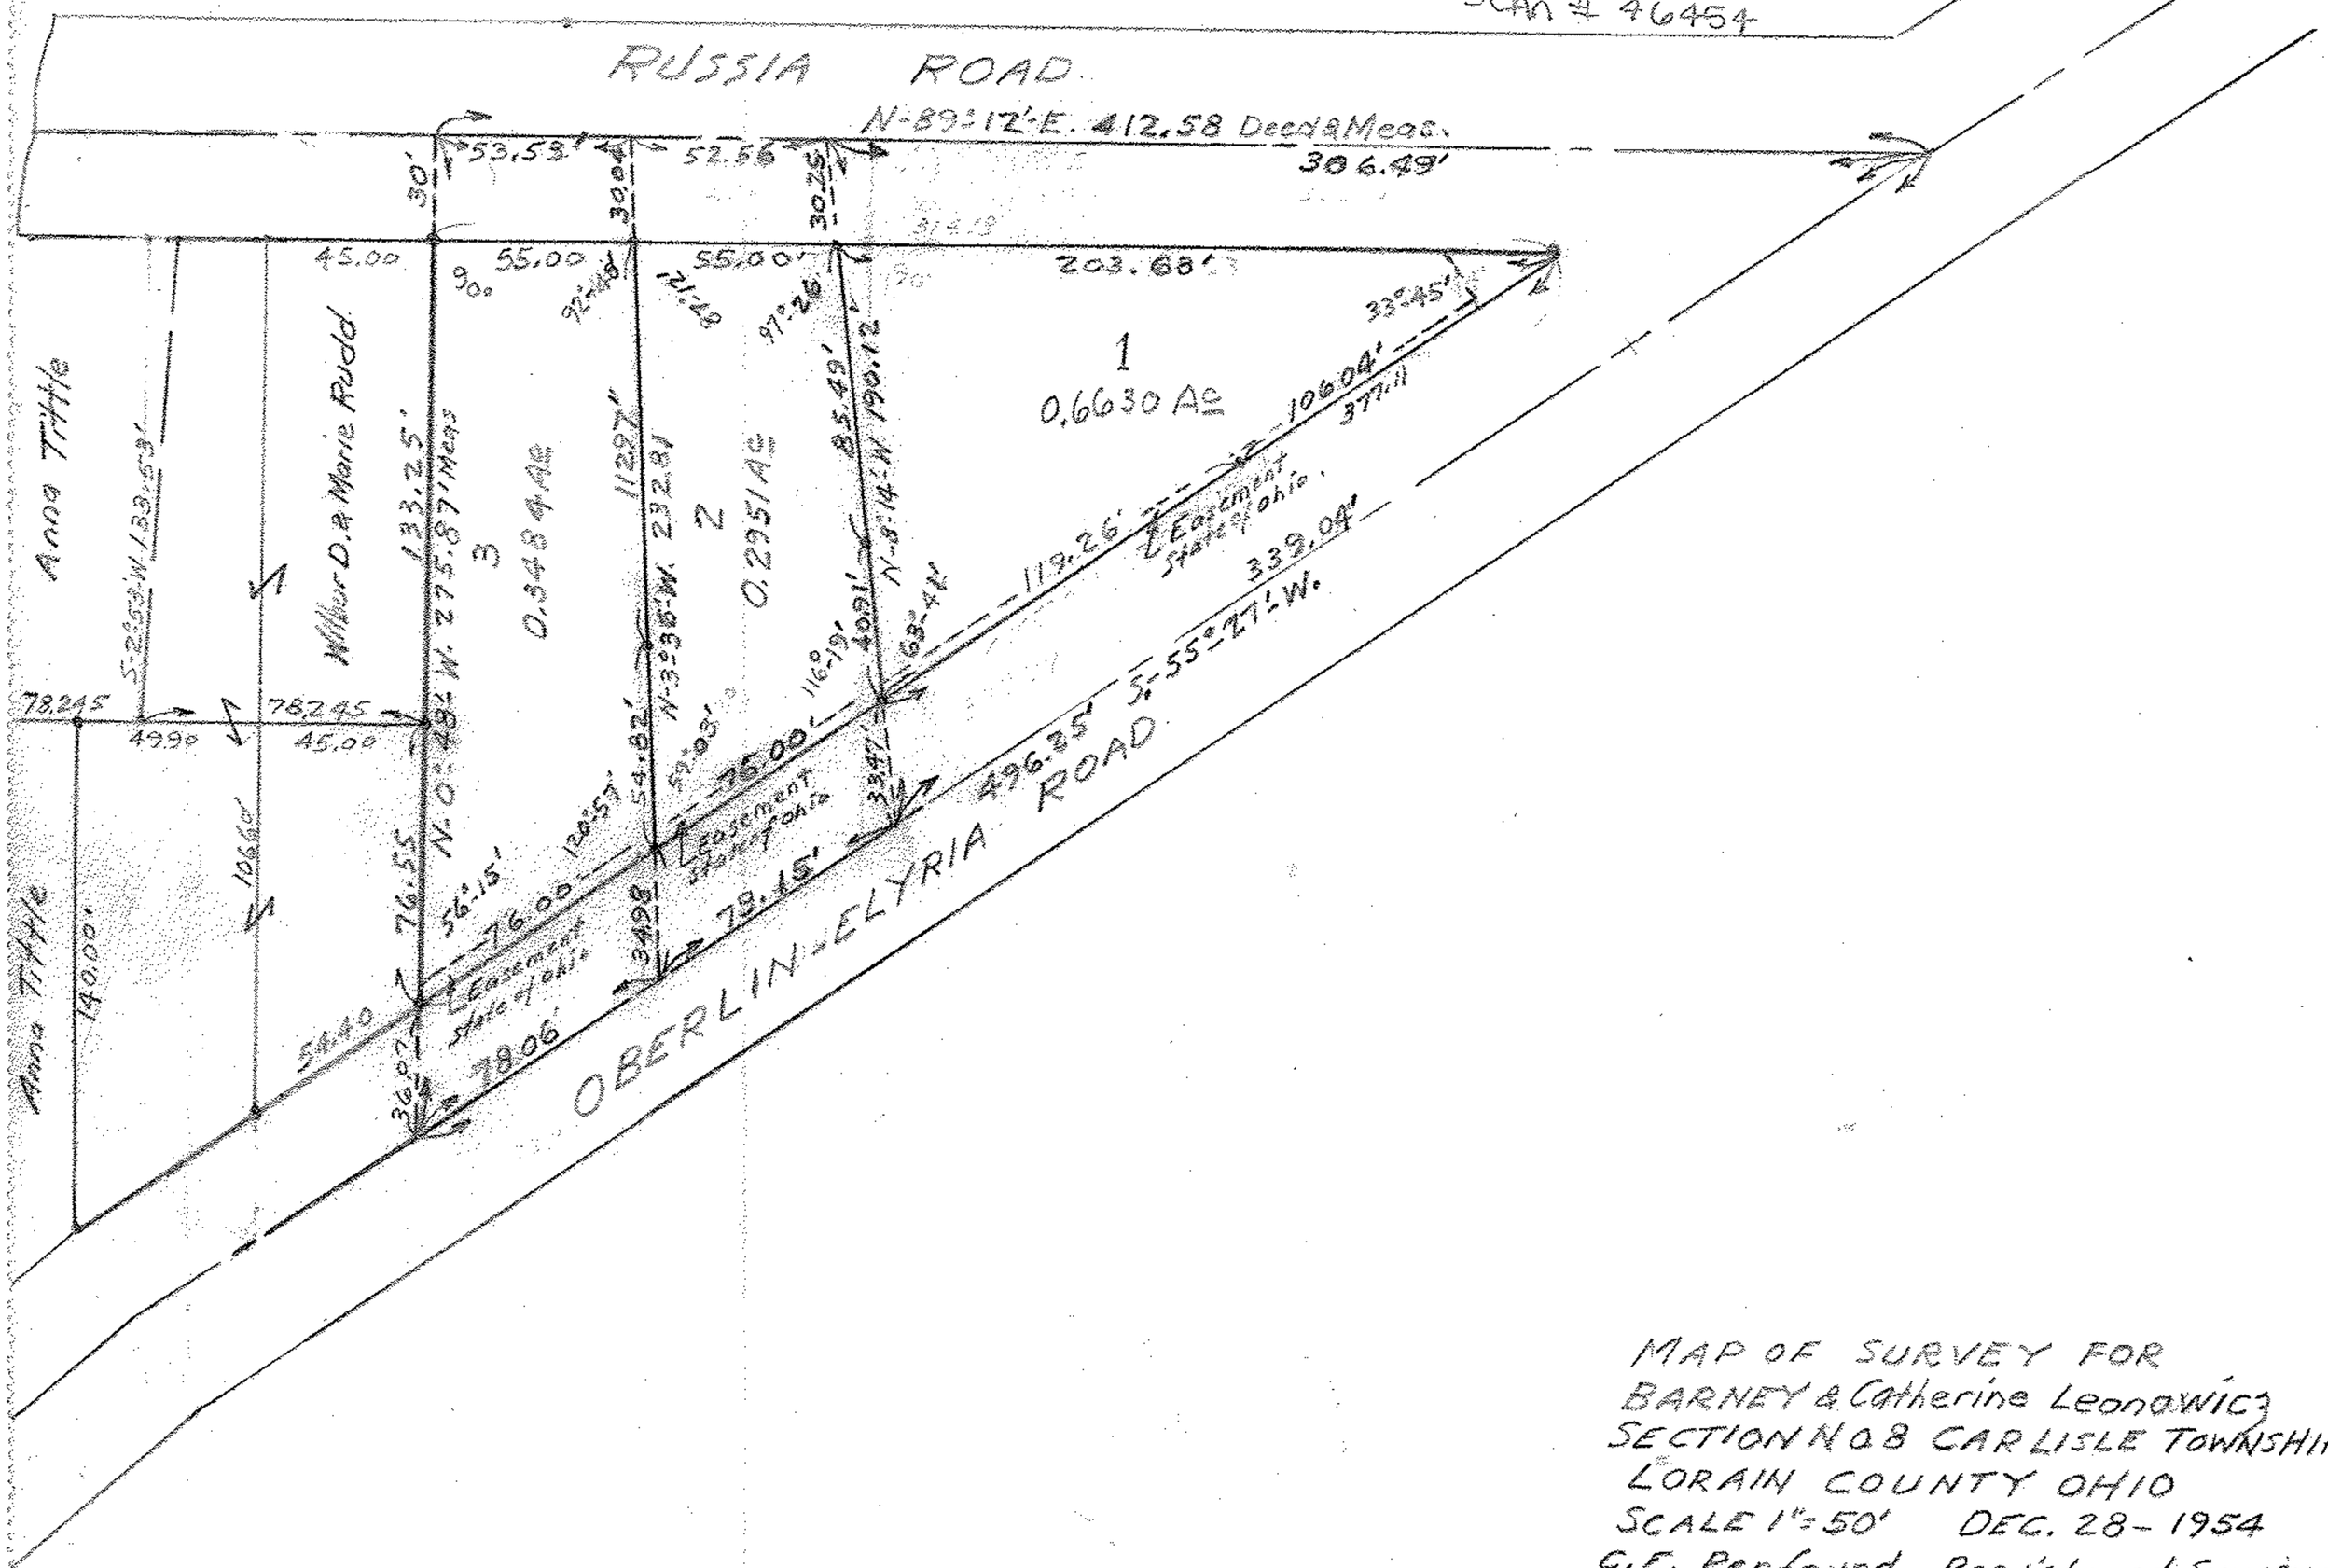

MAP OF SURVEY FOR
BARNEY & Catherine Leonowicz
SECTION NO 8 CARLISLE TOWNSHIP.
LORAIN COUNTY OHIO
SCALE 1" = 50' DEC. 28 - 1954
C.E. Penfound Registered Surveyor