

KLEINOEDER · SCHMIDT and ASSOCIATES

ENGINEERS — SURVEYORS — CONSULTANTS IN LAND PLANNING
ELYRIA · NORWALK · MEDINA OHIO

PLOT PLAN


JOB NO. 79-50

SUBLOT

SUBDIVISION

#12698

OTHER PART OF CARLISLE TOWNSHIP SECTION N. 8, COUNTY OF LORAIN STATE OF OHIO

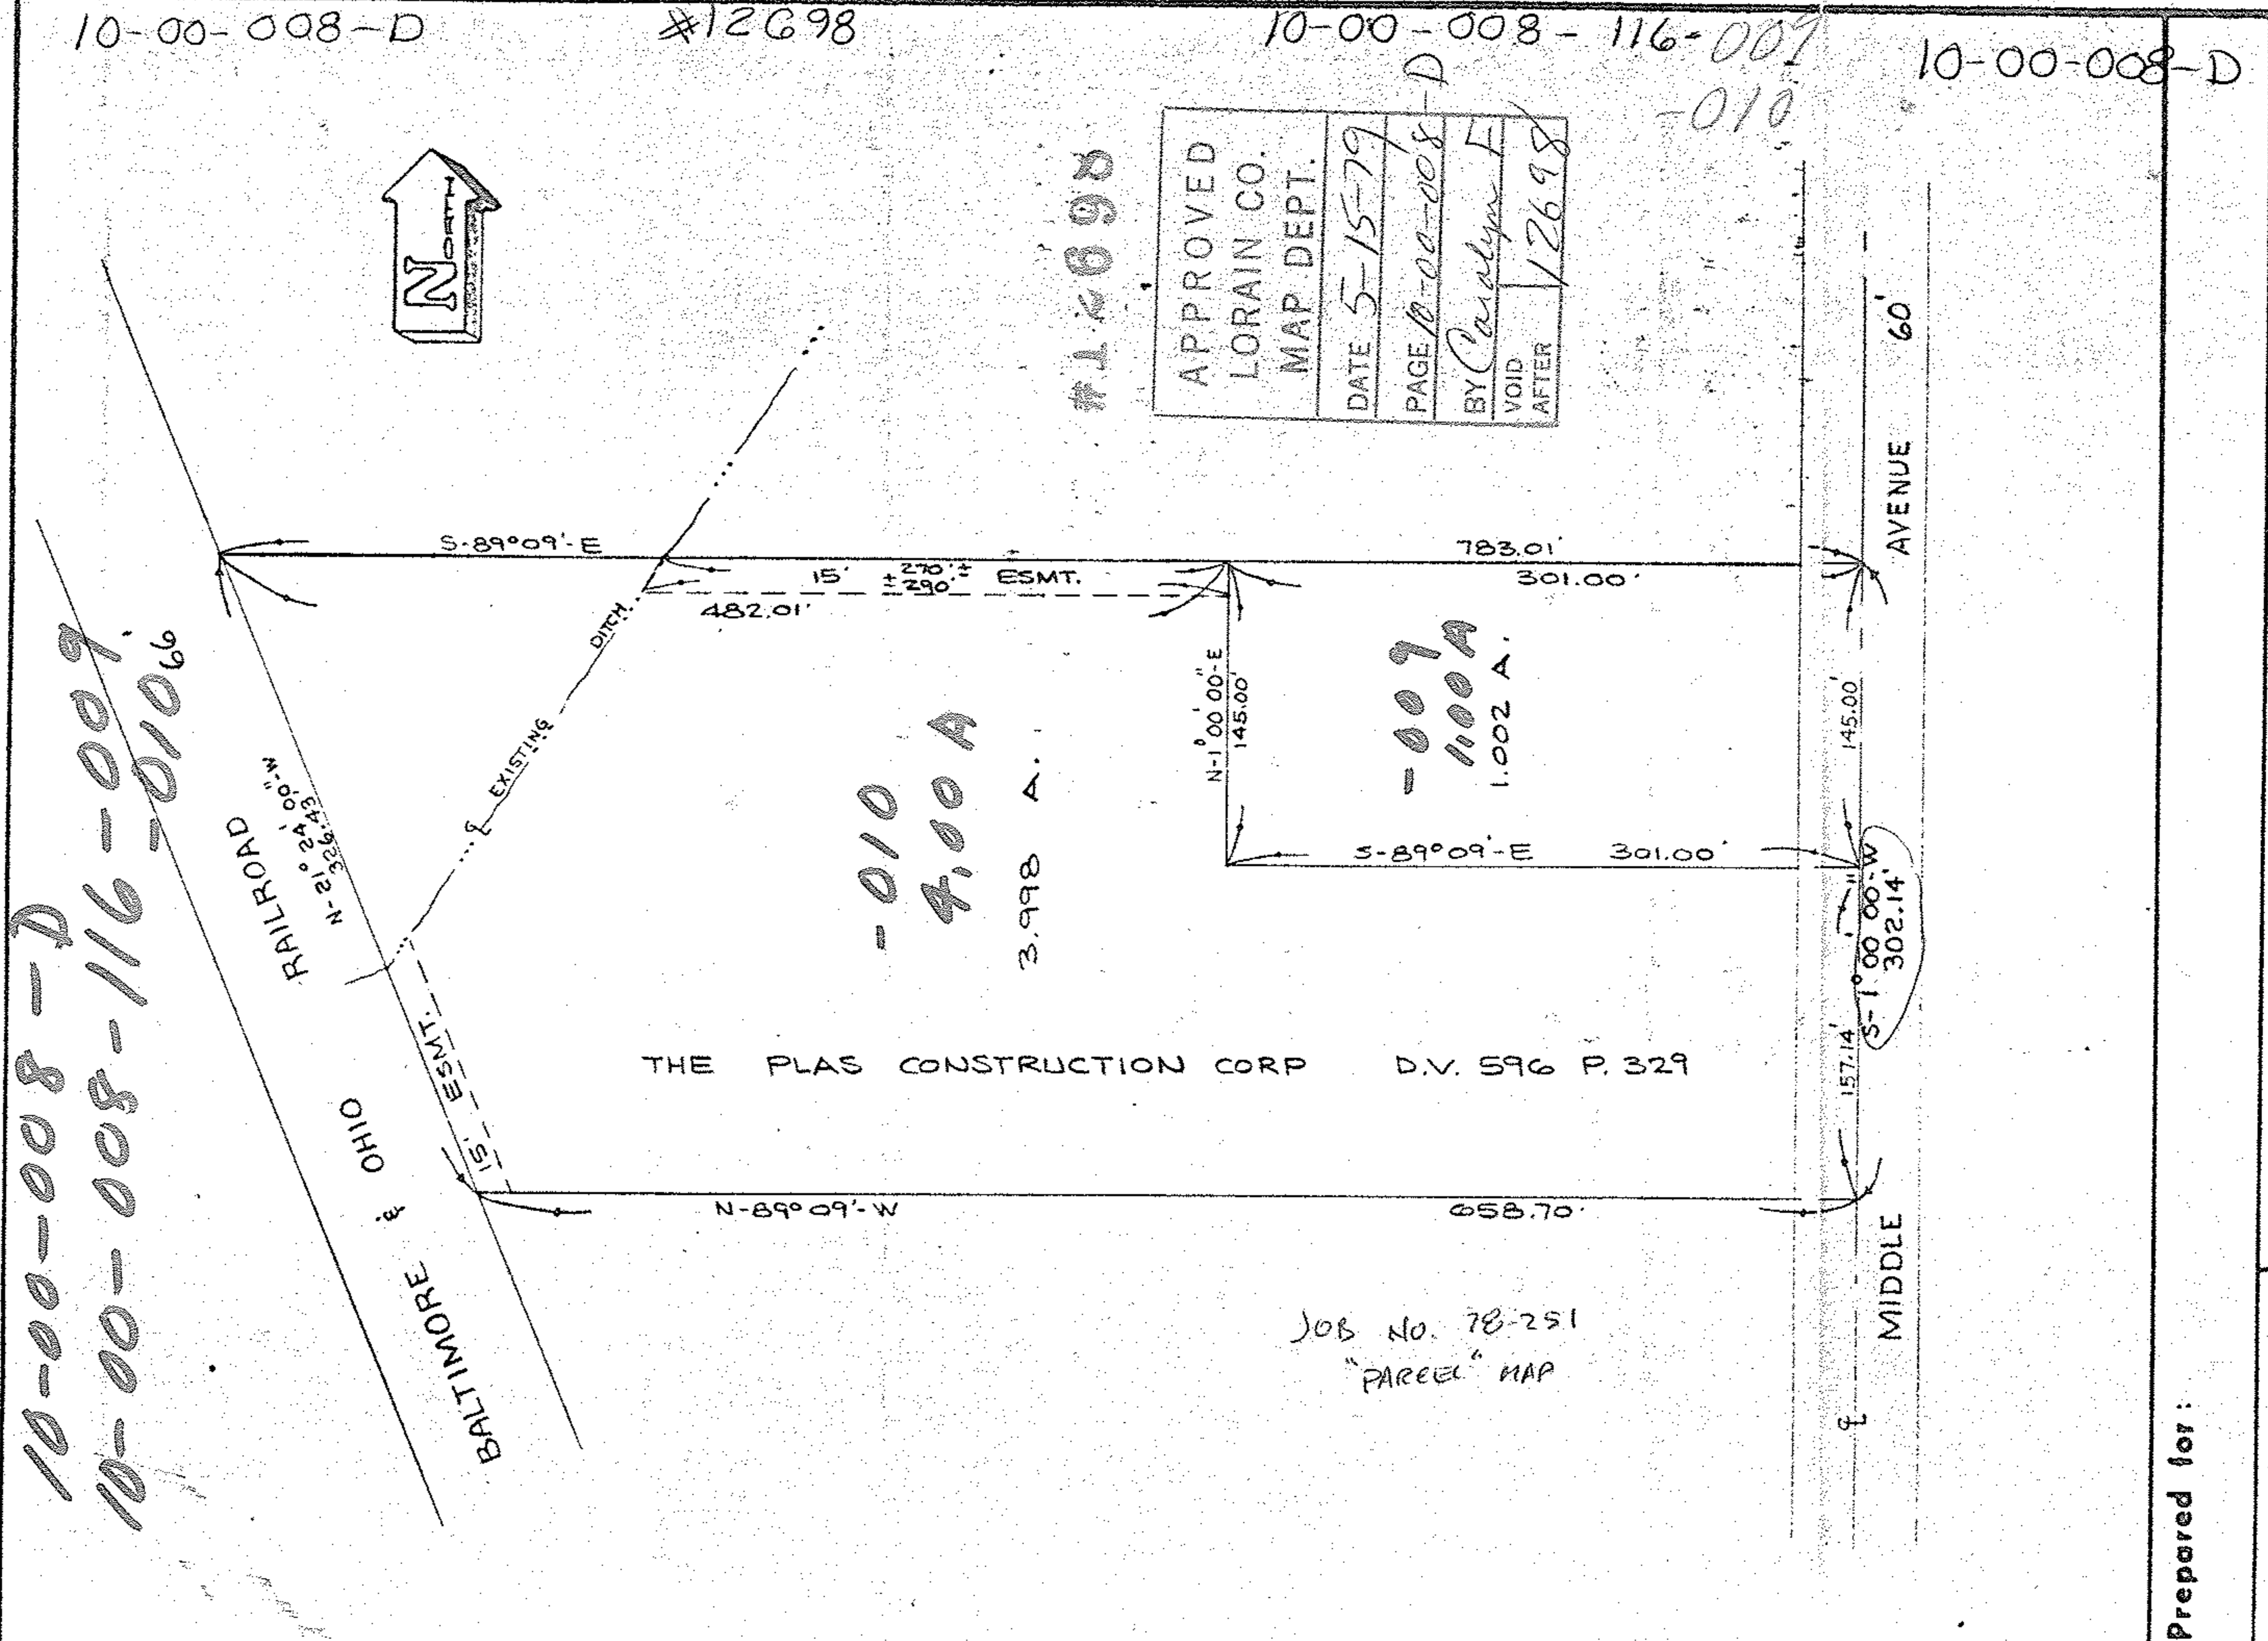


10-00-008-D
10-00-008-116-009
10-00-008-010⁹⁶

THE PLAS CONSTRUCTION CORP D.V. 596 P. 329

JOB NO. 78-251
"PARCEL" MAP

APPROVED	LORAIN CO. MAP DEPT.
DATE 5-15-79	
PAGE 10-00-008-D	BY Carolyn F.
VOID AFTER 12698	

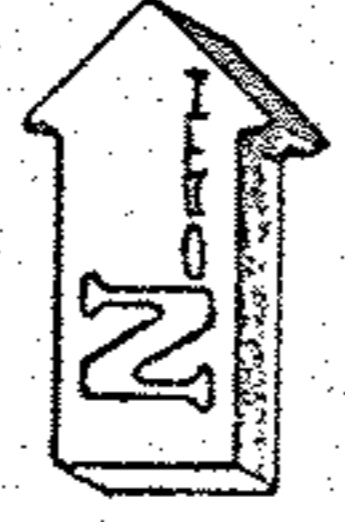

Prepared for:

Scale: 1" = 100'

Date: MAY 10, 1979