LAUNDON • SIMON • CAHL and ASSOC.
ENGINEERS — SURVEYORS
504 MIDDLE AVE. — ELYRIA, OHIO 4035

FOR: ESTATE of JAMES F. FOX % ATTY. HARRY F. BUTLER - EXECUTOR

TOWNSHIP CARLISLE	VILLAGE	DATE 10-26-83
ORIG. LOT or SEC. 9	COUNTY LORAIN	SCALE 1" = 50'
CITY	STATE OHIO	JOB NO. 83-1239 F.B. 176/31
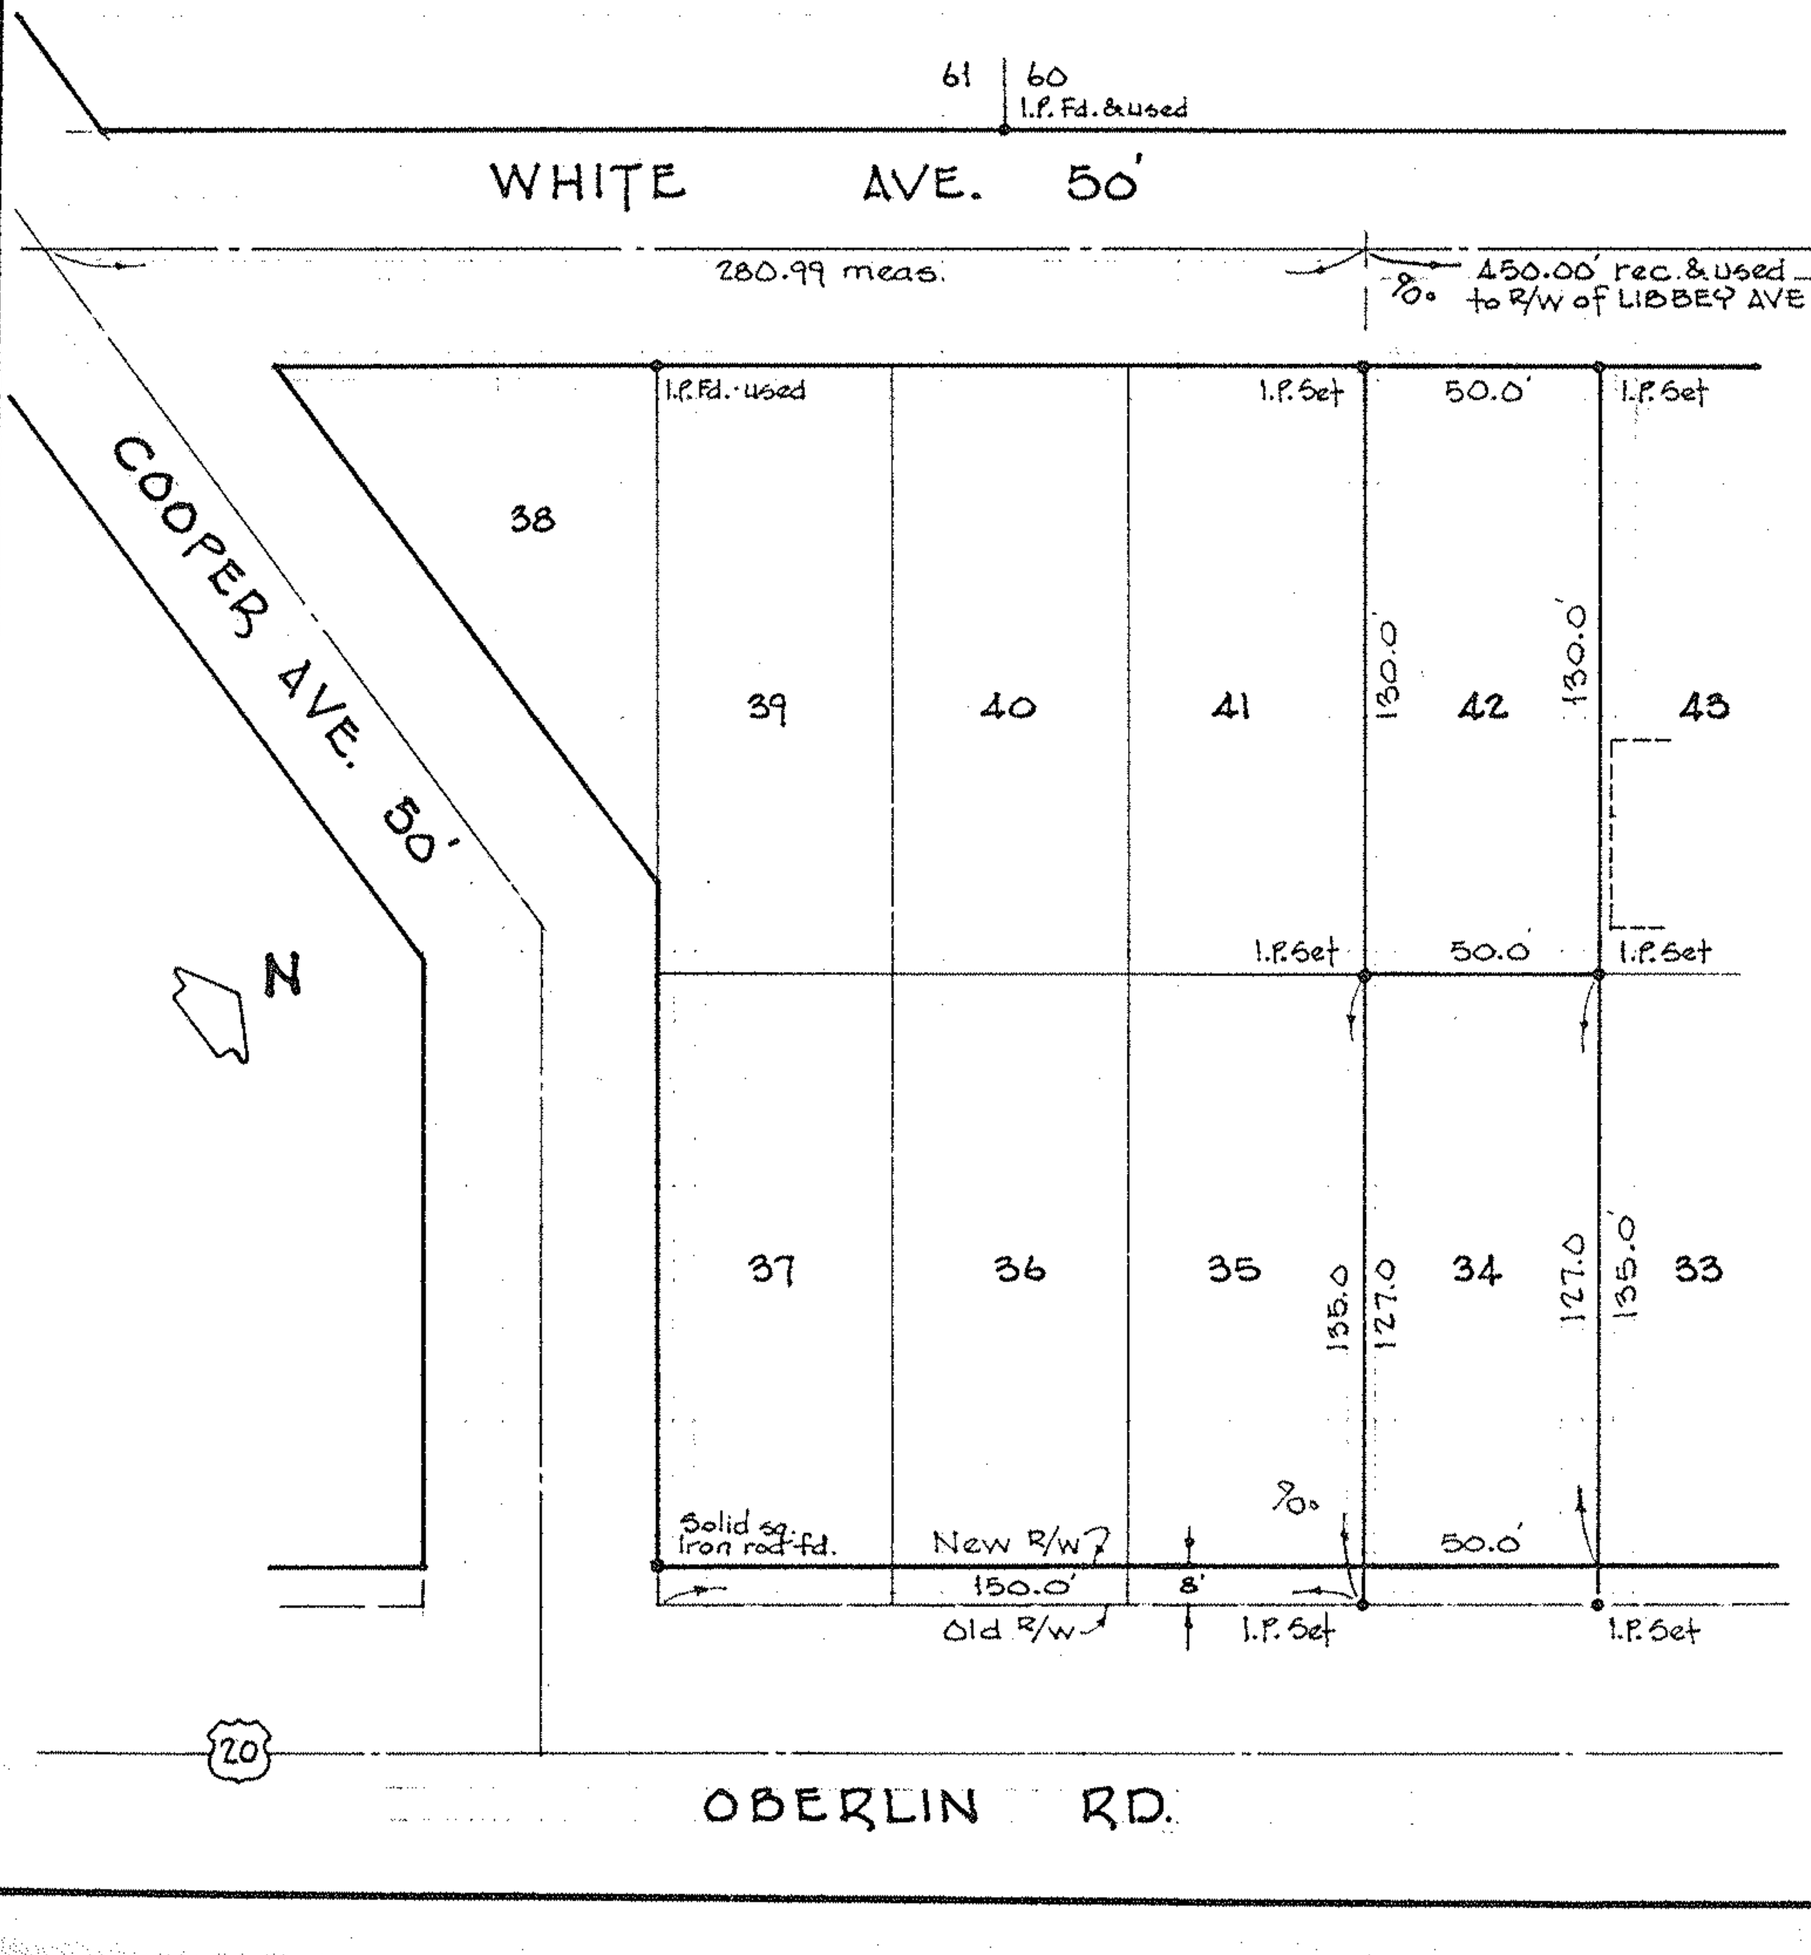
SURVEY OF S/L's 34 & 42 MEADOW VIEW ALLOT.
PLAT VOL. 12 PG. 7