

124


125

126

10-00-009-122-046

10-00-009-4

Scan #46467

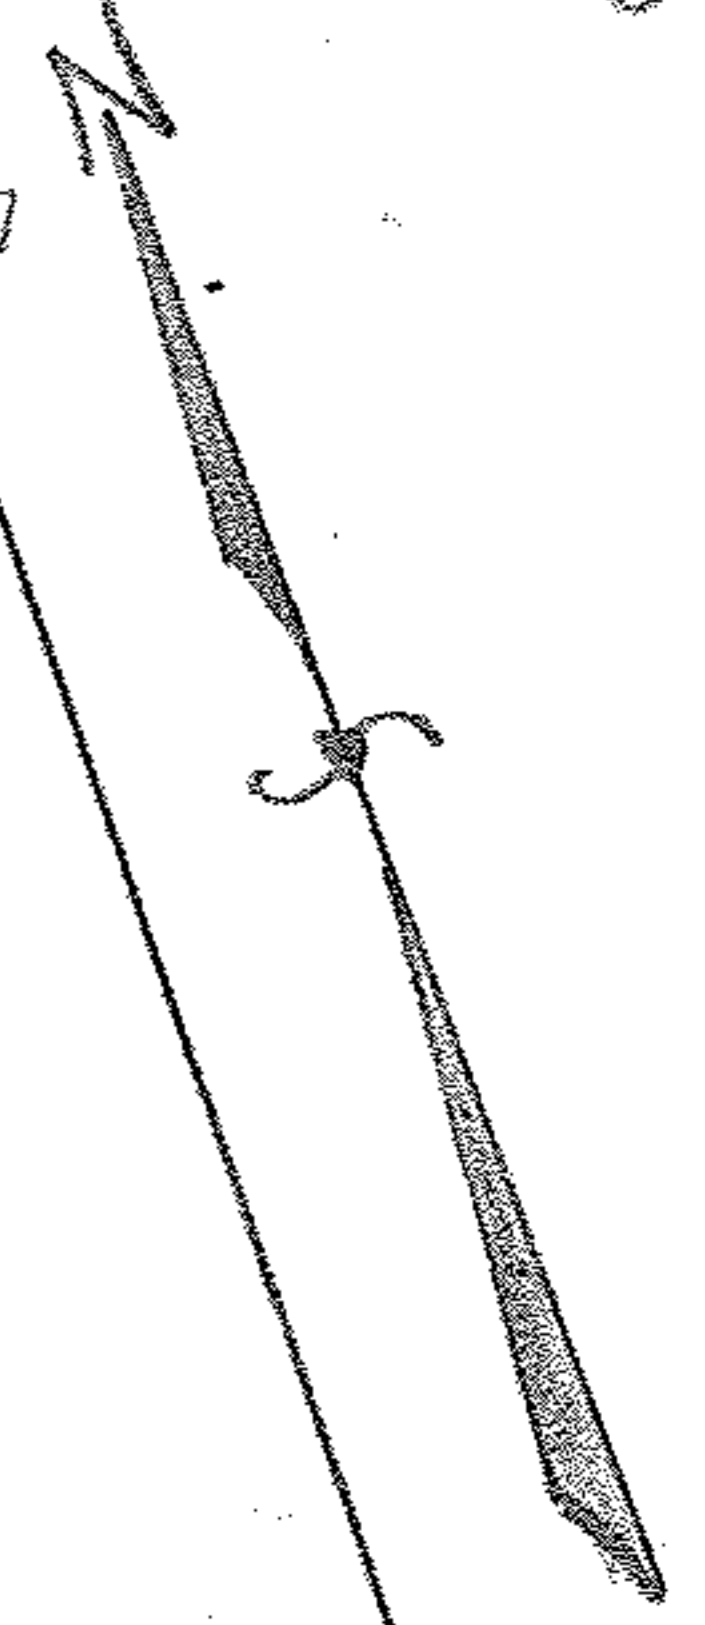

50' 50' 50' 5-70°-17'-20"E. 112.34' 47.25' 47.43' 47.64' 47.84' 50.30'

11.7' 4' 4' Privy

86 85 84 83 82

N-14°-59'-30" 157.29'

91'-9" 10'-2" 24'-0" 32'-0" 34'-2"

9'-5/16" Drive

Henry & Laura M. Miller


N-13°-58'-E. 152.78'

N-12°-58'-E. 147.37'

140.92'

100.22' 5-0°-54'-10"W.

GREENVIEW DR. 60'

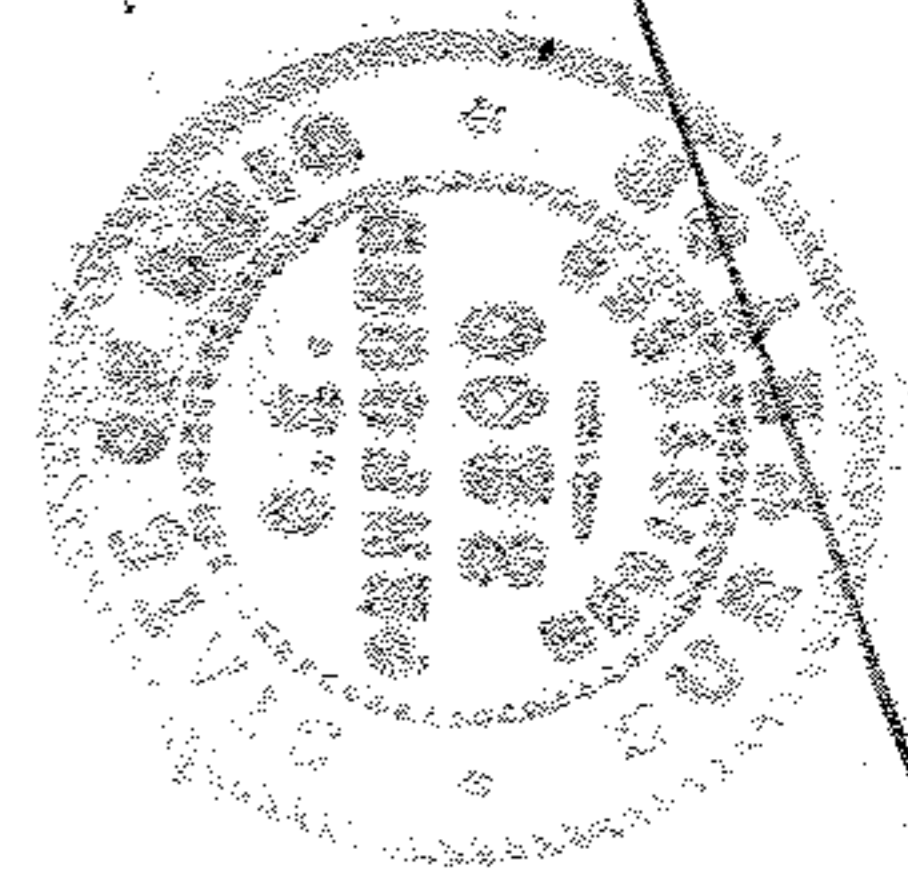

Arc 50' Ch. 4999' 5-75°-44'-17"E. R=2719.71'

Arc 50' Ch. 4999' 5-76°-47'-29"E. 39.57' 14.58' 39.57' T=36.42'

MIDVALE DRIVE 50'

P.O.T.

118'

Arc 65.17' R=2555'

MAP OF SUB-LOT NO. 85  
CARLISLE PROPERTIES INCORPORATED  
CARLISLE ESTATES NO. 2 VOL. 13 PG. 2-3  
RECORD OF PLATS - SECTIONS NOS 8 & 9  
CARLISLE TWP. LORAIN COUNTY OHIO  
Scale 1"=30' Feb. 15-1958 1:30 P.M.  
C.E. Penfound Registered Surveyor.

Parcel No. 2 Order No. 347  
OHIO BAR TITLE INSURANCE CO.

WW