10-00-009-129-026,034→036 (4)

10-00-009-H

Scan # 46470

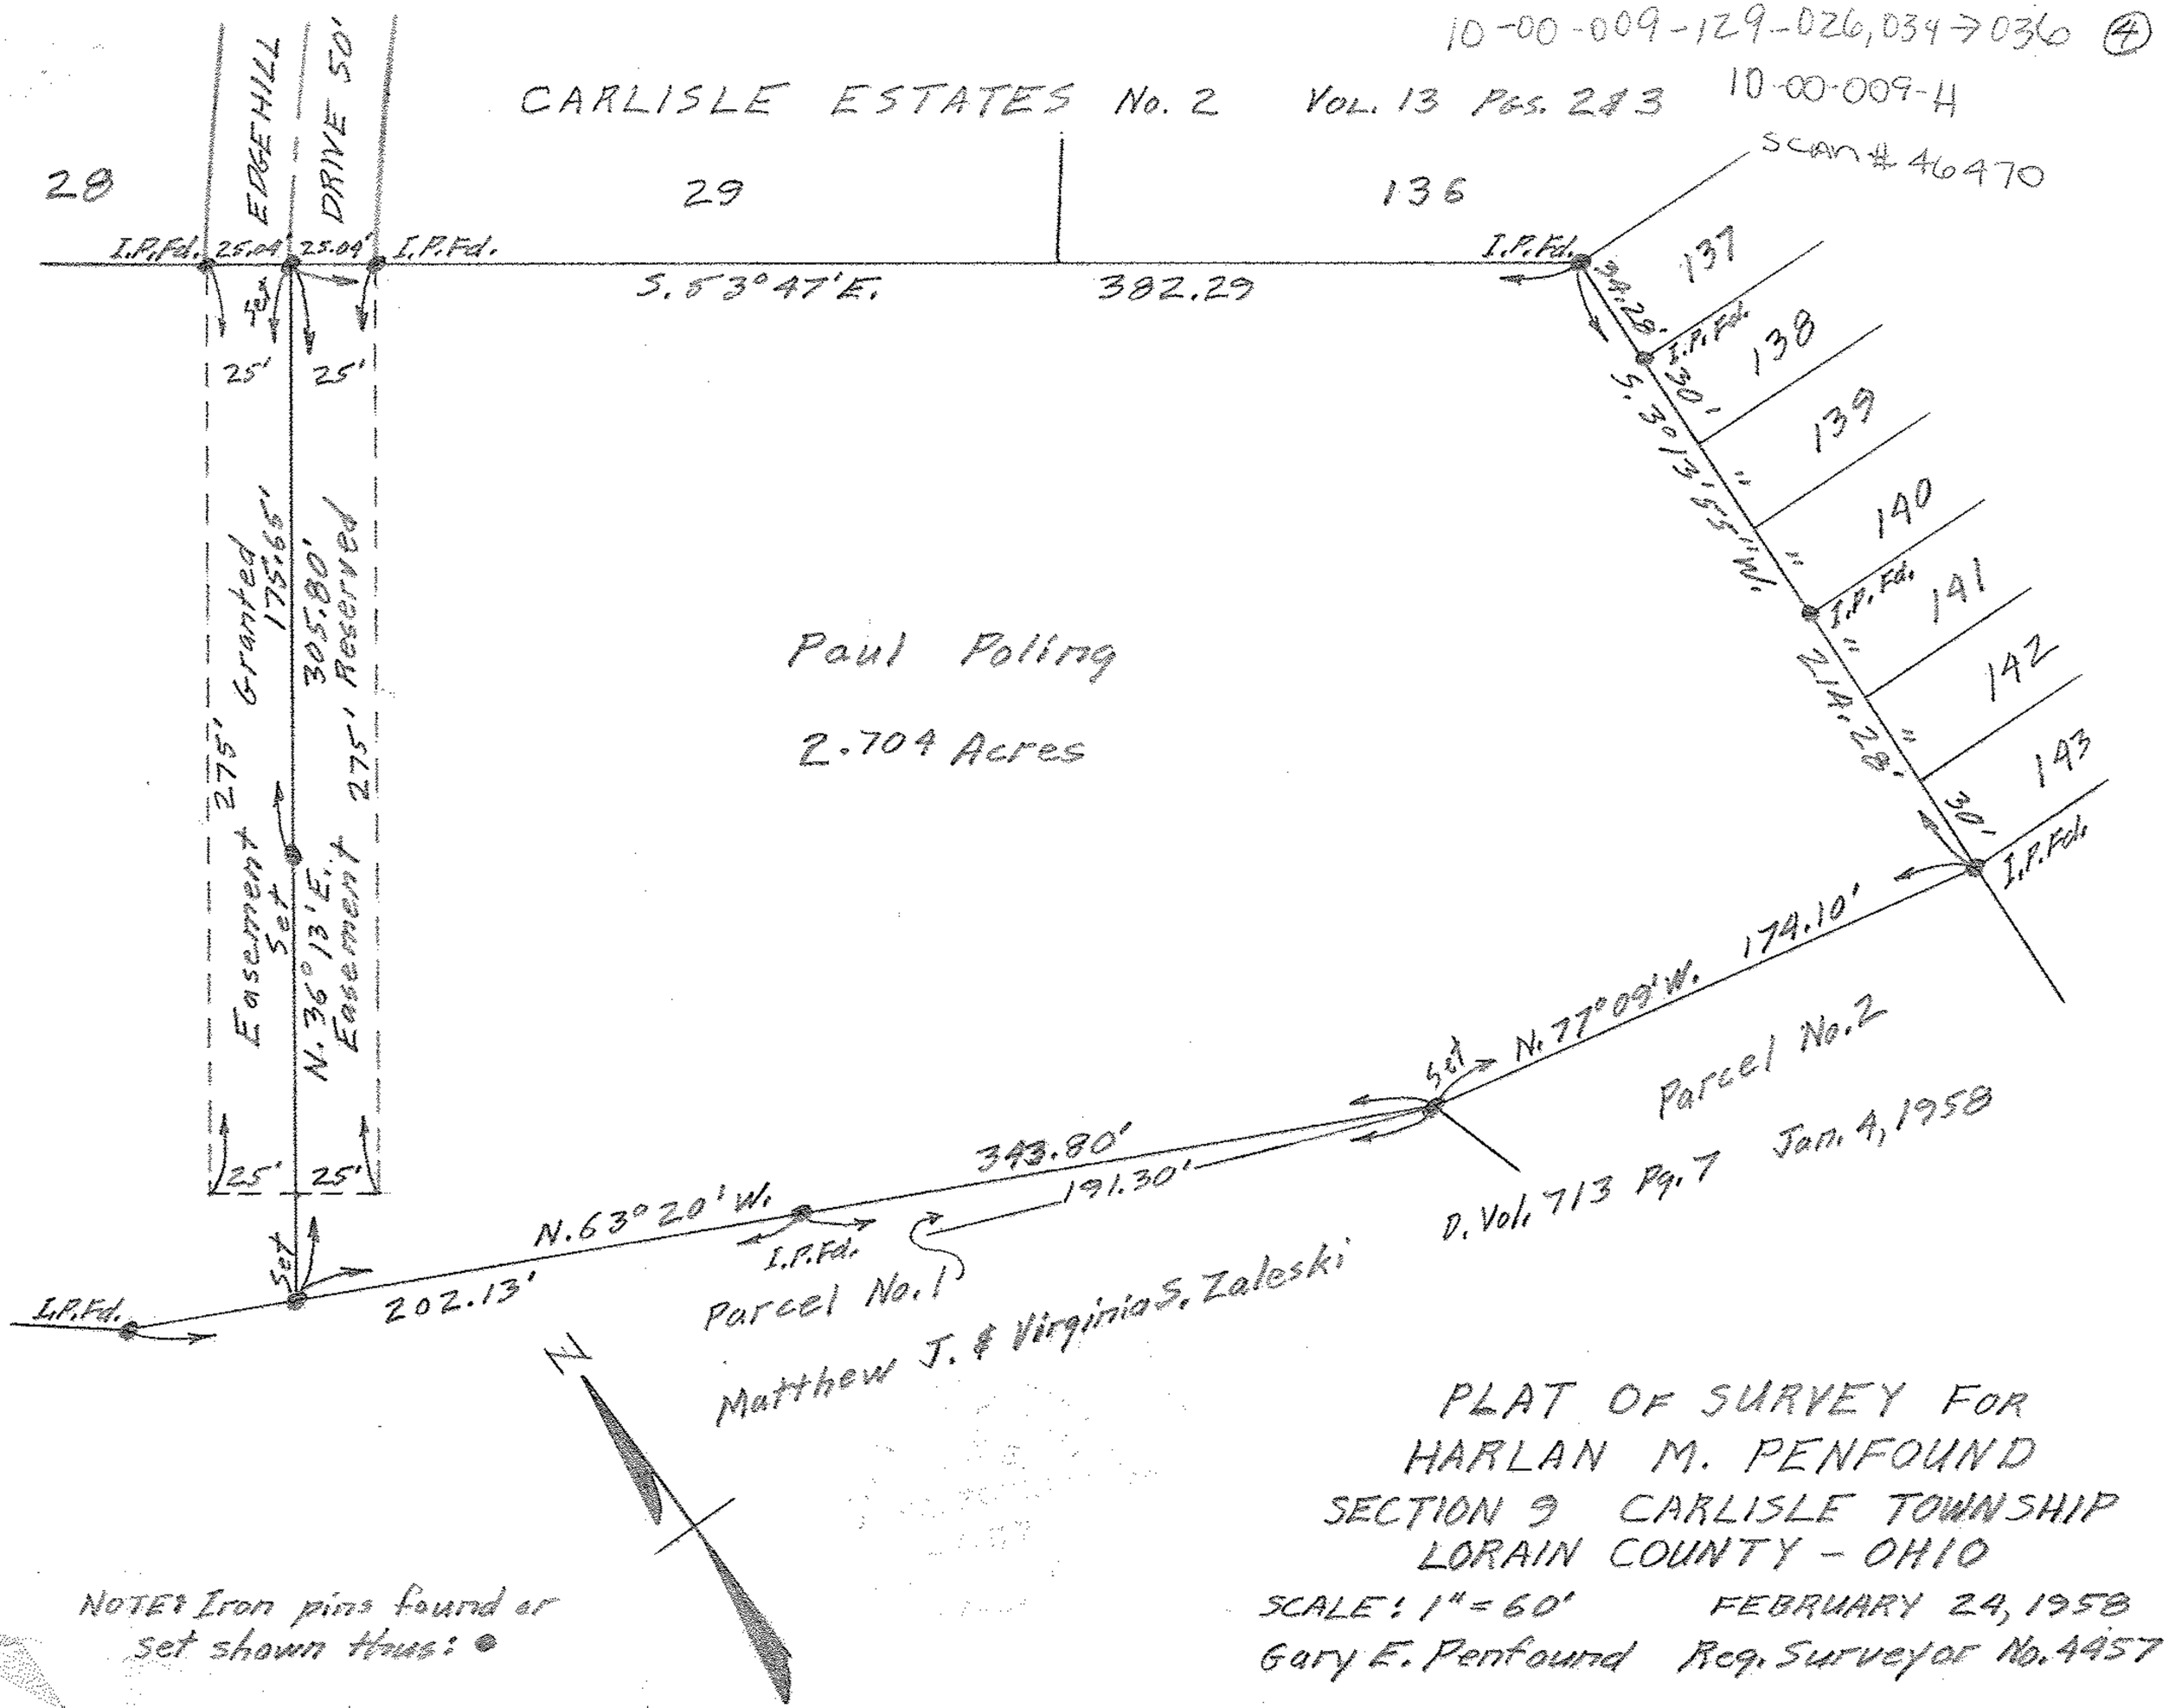

PLAT OF SURVEY FOR
HARLAN M. PENFOUND
SECTION 9 CARLISLE TOWNSHIP
LORAIN COUNTY - OHIO

SCALE: 1" = 60' FEBRUARY 24, 1958

Gary E. Penfound Reg. Surveyor No. 4457

NOTE: Iron pins found or set shown thus: ●