46495

SITUATED IN THE TOWNSHIP OF PITTSFIELD, COUNTY OF LORAIN, STATE OF OHIO AND BEING KNOWN AS PART OF ORIGINAL PITTSFIELD TOWNSHIP LOT 157. ALSO BEING A PORTION OF THOSE LANDS DEEDED TO LYLE G. & MARION K. JAMEYSON IN DEED VOLUME 1191 PAGE 623 OF LORAIN COUNTY DEED RECORDS.

## SURVEYOR'S STATEMENT

DISTANCES ARE EXPRESSED IN FEET AND DECIMAL PARTS THEREOF. BEARINGS ARE TO AN ASSUMED MERIDIAN AND ARE USED TO INDICATE ANGLES ONLY. PERMANENT MONUMENTS WERE FOUND OR SET AS INDICATED HEREON. ALL OF WHICH I DECLARE TO BE CORRECT TO THE BEST OF MY ABILITIES AND BELIEFS.

THOMAS M. SNEZEK, P.S. 7051 — DATE 8/14/10

STATE OF OHIO — THOMAS M. SNEZEK S-7051 — SURVEYOR

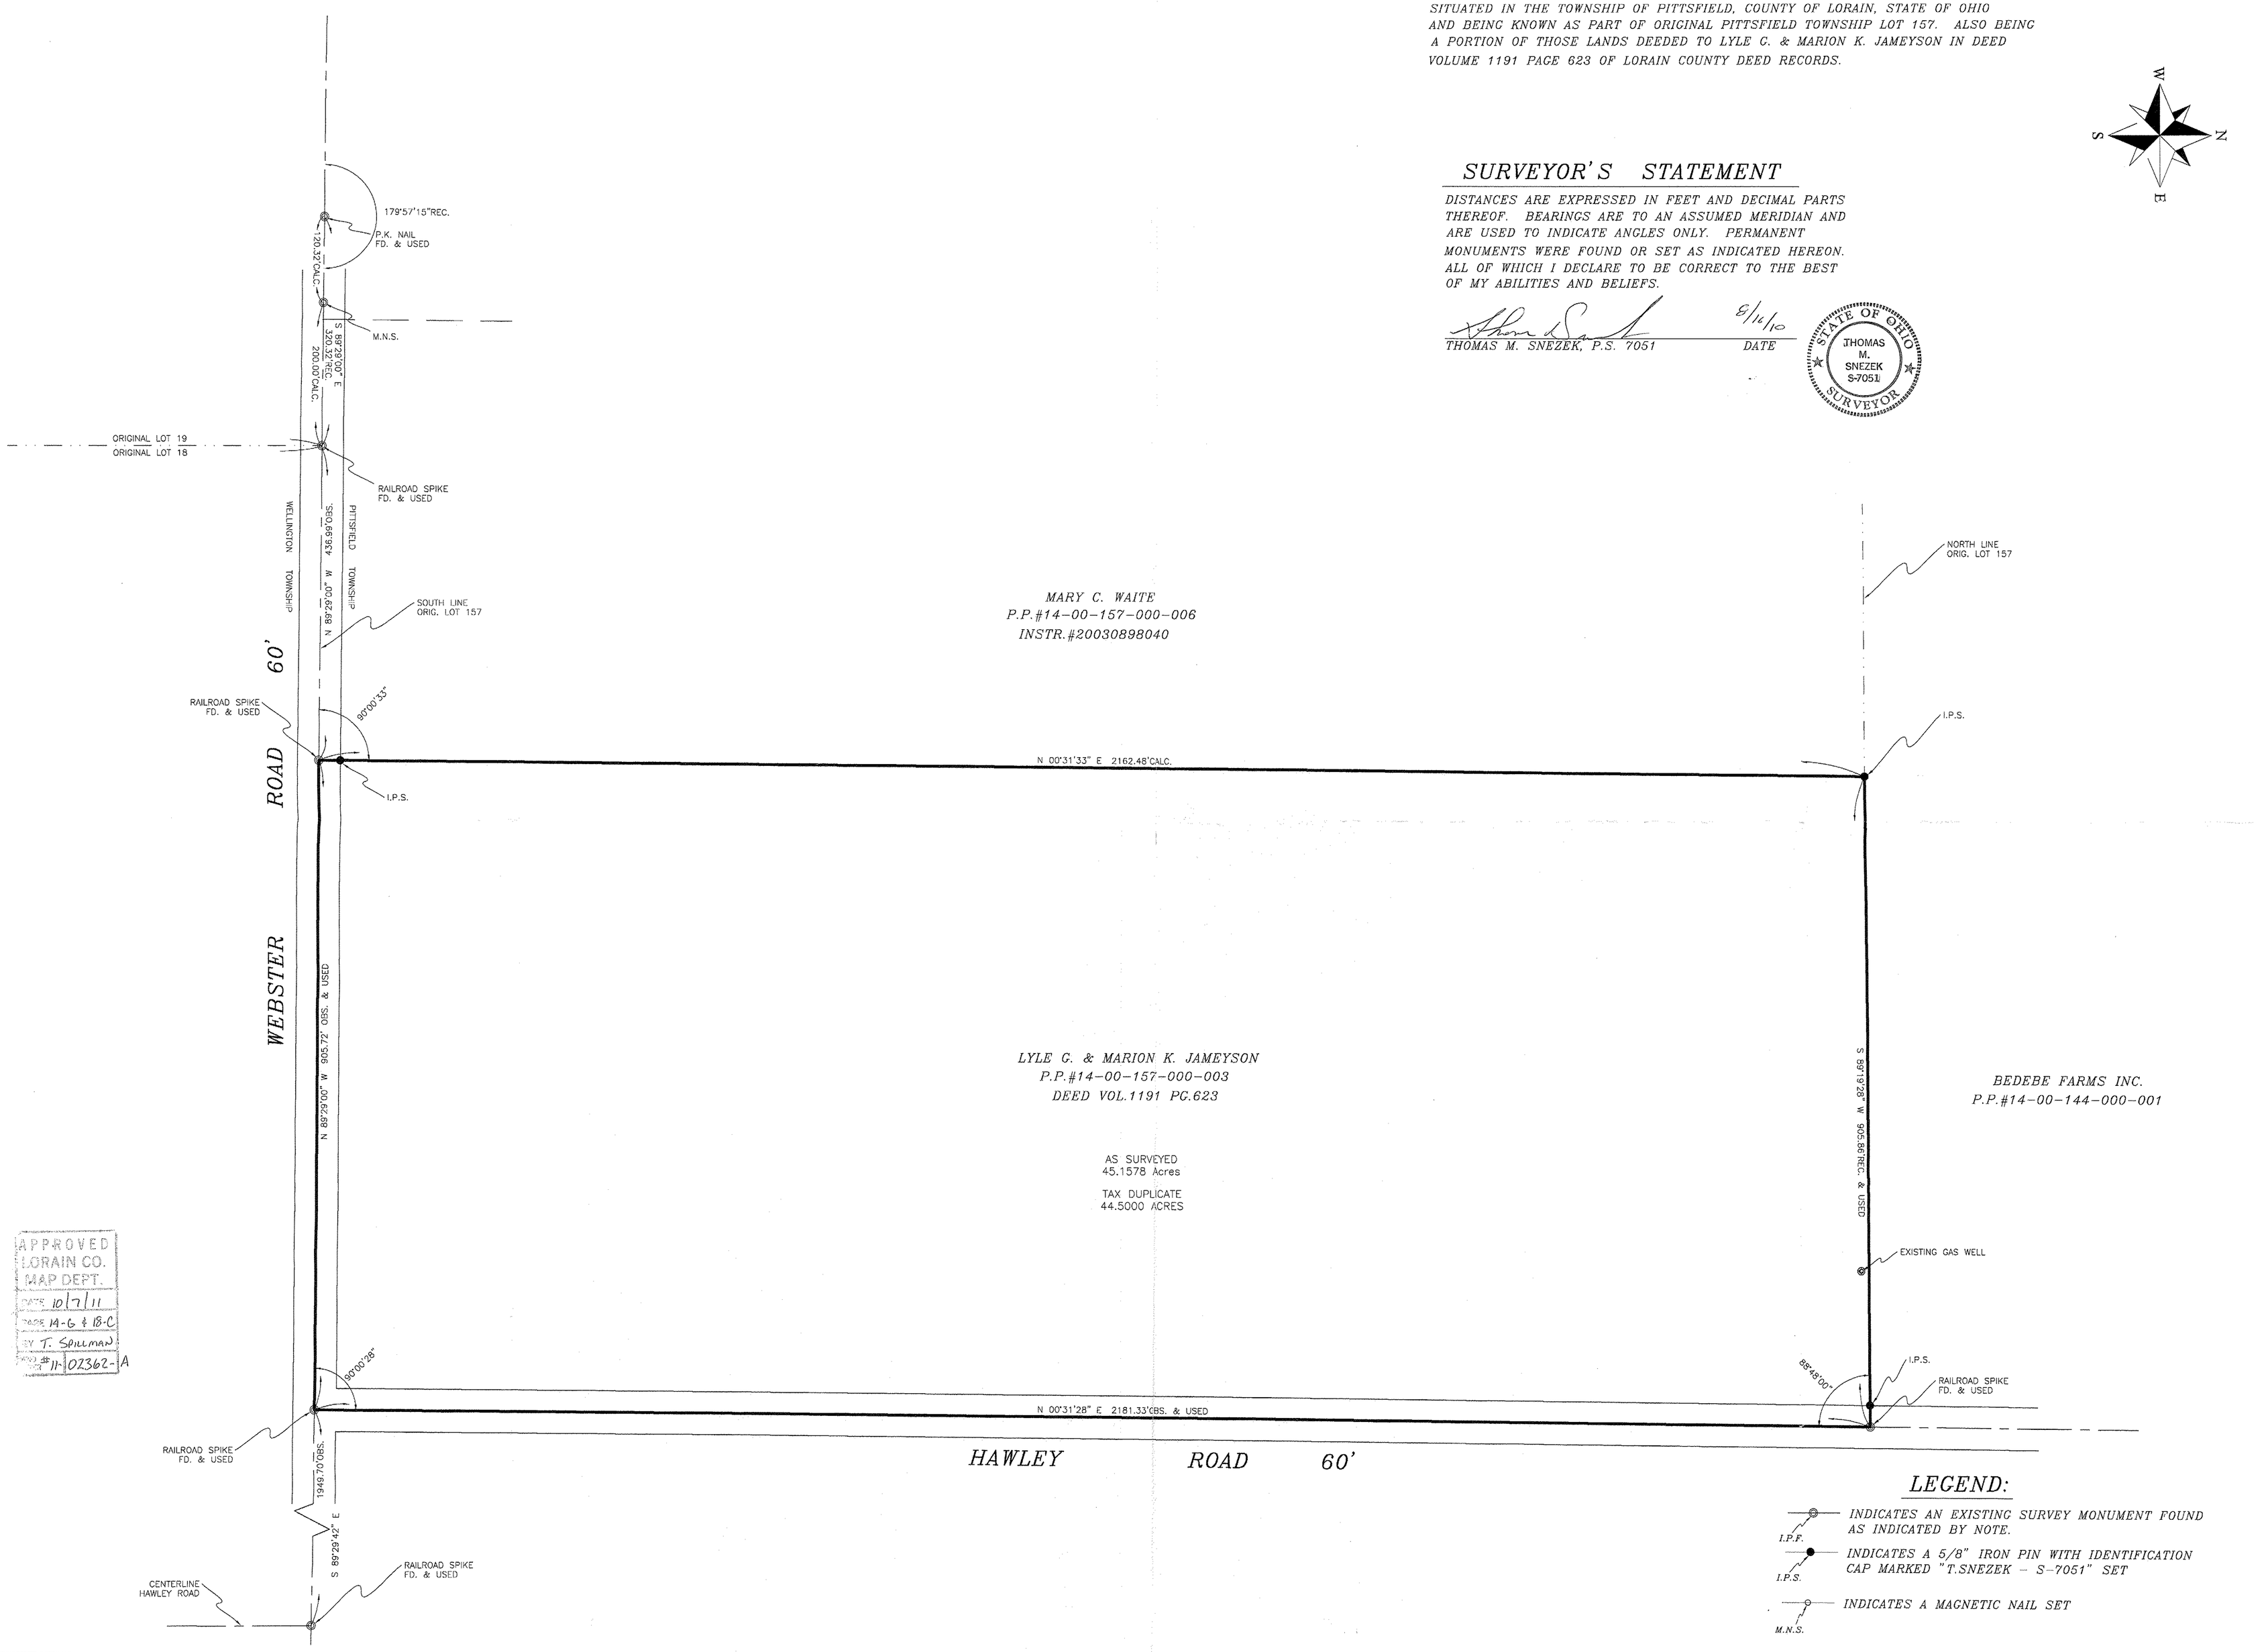


## LEGEND:

- I.P.F. — INDICATES AN EXISTING SURVEY MONUMENT FOUND AS INDICATED BY NOTE.
- I.P.S. — INDICATES A 5/8" IRON PIN WITH IDENTIFICATION CAP MARKED "T.SNEZEK – S-7051" SET
- M.N.S. — INDICATES A MAGNETIC NAIL SET

SCALE: 1" = 100' (0', 100', 200')

PROJECT NO. JAMESYSON-#1019

# MAP OF BOUNDARY SURVEY

PREPARED FOR:

THE ESTATE OF LYLE G. & MARION K. JAMEYSON
C/O JACK & DEBBIE COCHRANE — 476 KAR A BRU DRIVE — AMHERST, OHIO 44001

PREPARED BY:


SNEZEK & ASSOCIATES, L.L.C.
PROFESSIONAL SURVEYORS
CLEVELAND, OHIO 44111
DADSURV@HOTMAIL.COM
3496 COLLETTA LANE
(216) 671-4902
FAX (216)-941-2431


DRAWN T.SNEZEK — DATE 8_16_10 — REVISED: — SHEET 2OF2

SCAN# 46495 — 14-00-157-000-003 — 14-G