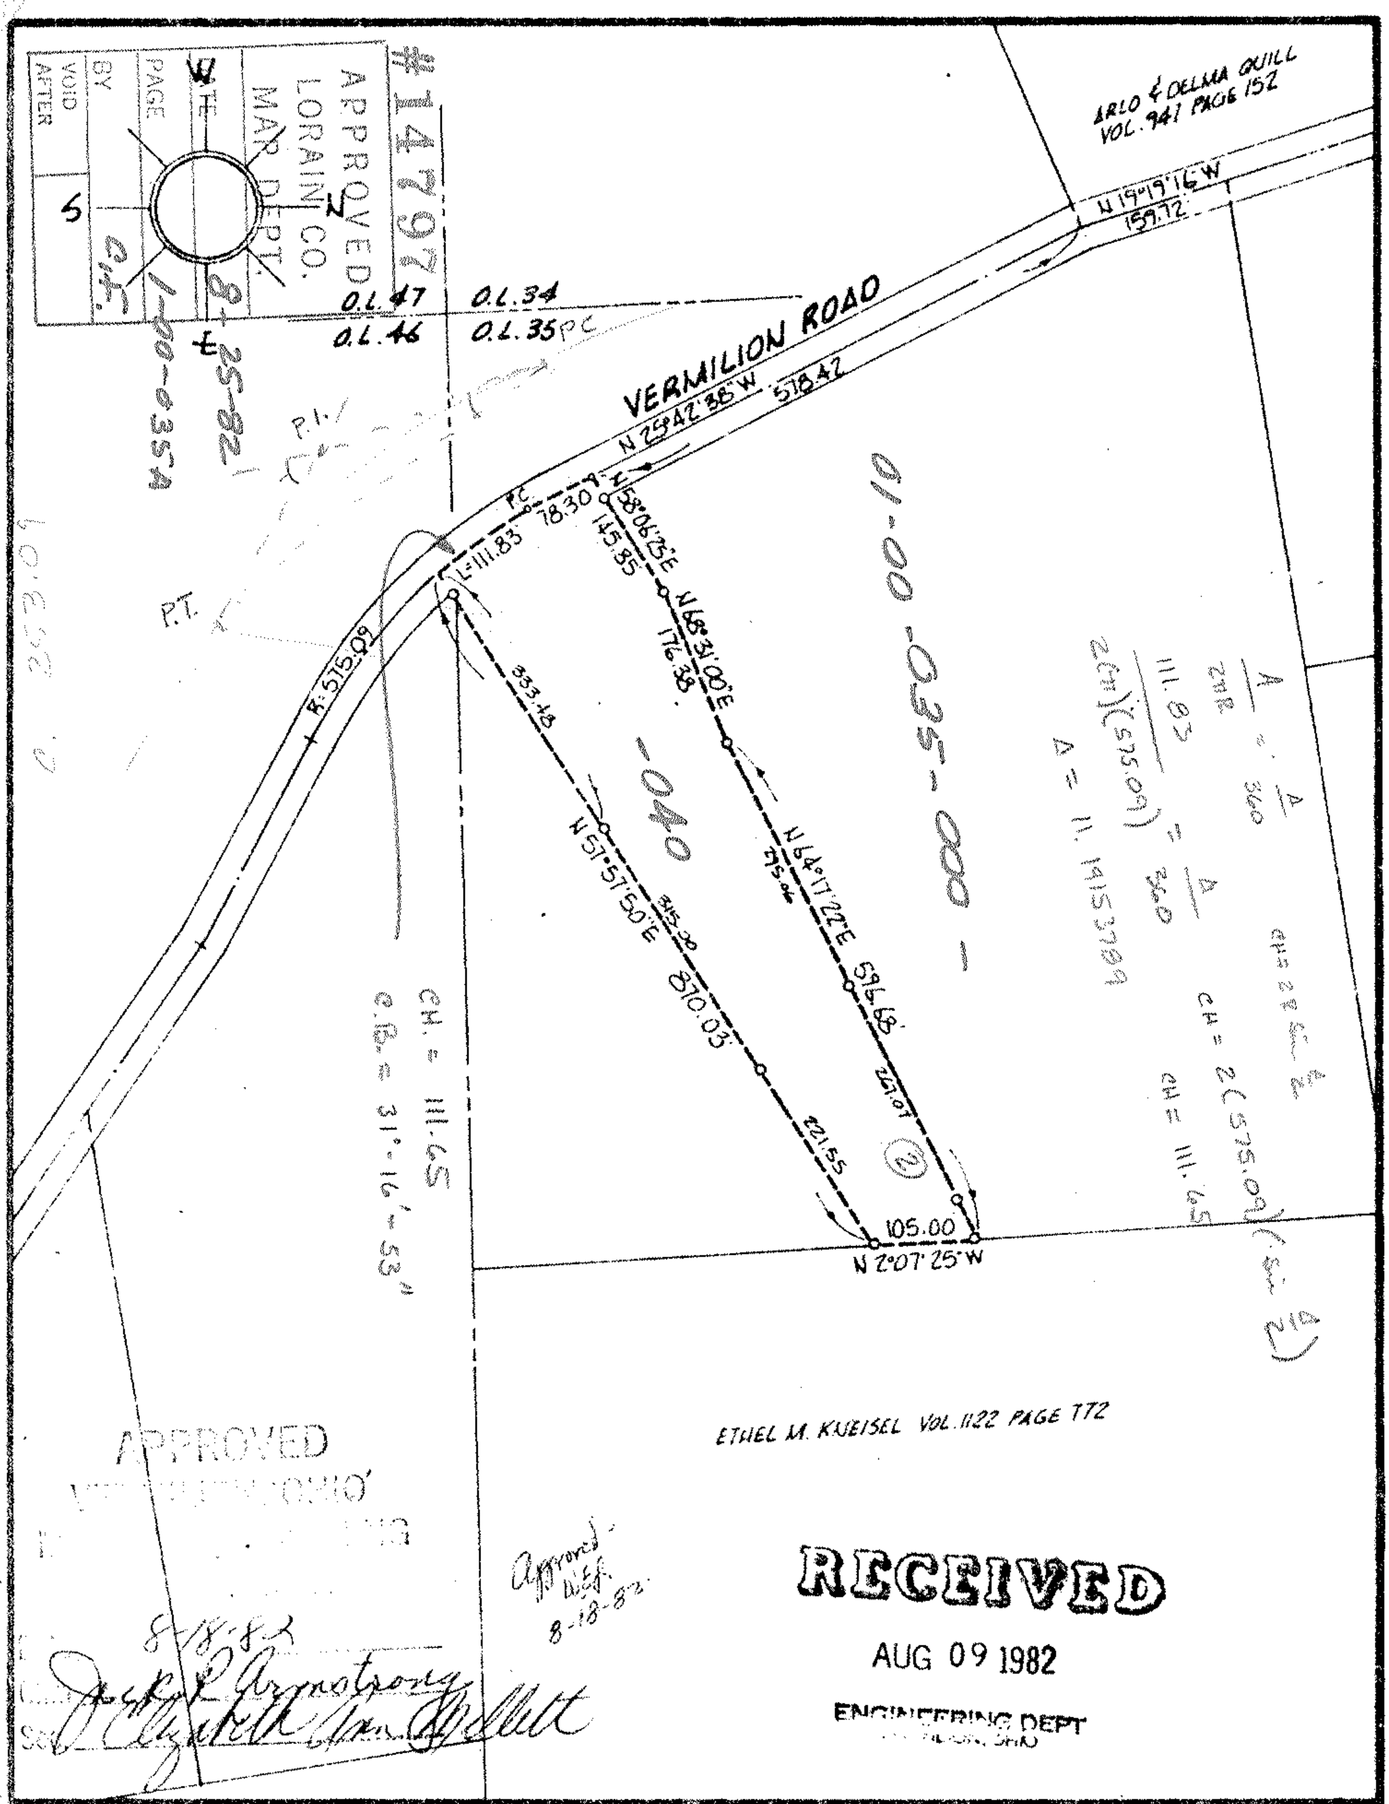

ACREAGE 2.94	DATE 08-02-82	SCALE 1" = 200 FT.	DRAWN MGH

PREPARED FOR:
MR. JOHN ROWLAND

SITUATED IN THE CITY OF
VERMILION OHIO

STATE OF OHIO
MICHAEL G. HURA
No. 4712
REGISTERED SURVEYOR

Michael G. Hura and Associates
3409 LIBERTY AVENUE VERMILION, OHIO

PERIMETER SURVEY

PART OF O.L. 35 TR. ____ SECTION ____ OF
BROWNHELM Township LORAIN County, Ohio
SUBLOT ____ of ____
____ VOL. ____ PAGE ____ OF PLATS

PERMANENT PARCEL NO.